



WB 9+860

SEE NOTE ON SHEET 312

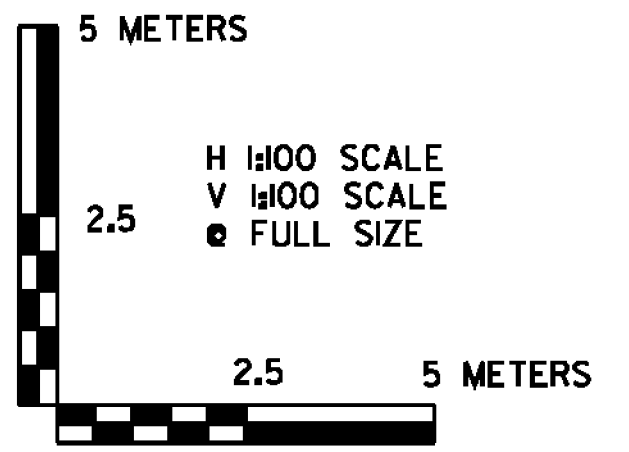

SEE REVISED

	PROJECT NAME: BENNINGTON
	PROJECT NUMBER: NH 019-(154)
FILE NAME: ...\plot_files\zd307c4xs.279WB.ptf	PLOT DATE: 1/26/2010
DESIGN SUPERVISOR: GREG EDWARDS	DRAWN BY: STANTEC
DESIGNED BY: MARC FOISY	CHECKED BY: GARY SANTY
VT 279 WB CROSS SECTION WBX-07	SHEET 318 OF 468

1/26/2010 4:56:02 PM V:\1953\getlive\1953\0002\tr\anspor\getlive\dr\dwg\cont\tr\cp1\_4\plot\_files\zd307c4xs.279WB.ptf