


WB 9+920

SEE NOTE ON SHEET 312



SEE REVISED

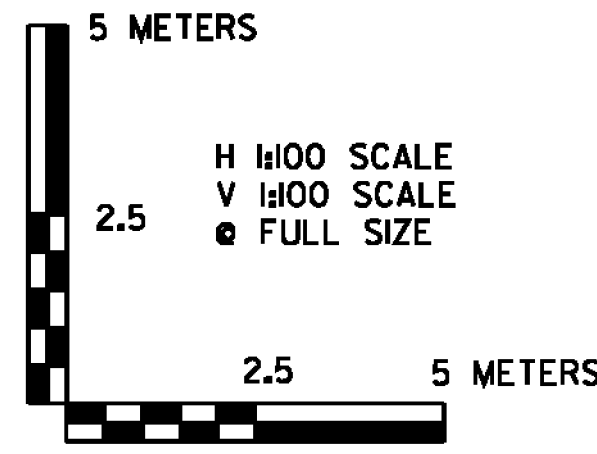

PROJECT NAME:	BENNINGTON
PROJECT NUMBER:	NH 019-(154)
FILE NAME:	...plot_files\zd307c4xs.279WB.ptf
DESIGN SUPERVISOR:	GREG EDWARDS
DESIGNED BY:	MARC FOISY
VT 279 WB CROSS SECTION	WBX-10
PLOT DATE:	1/26/2010
DRAWN BY:	STANTEC
CHECKED BY:	GARY SANTY
SHEET	321 OF 468

1/26/2010 4:56:04 PM v:\1953\getlive\1953\0002\tr\anspor\station\dr\cwg\ng\cont\rcpt\_4\plot\_files\zd307c4xs.279WB.ptf