


SEE NOTE ON SHEET 312

WB 9+940



SEE REVISED

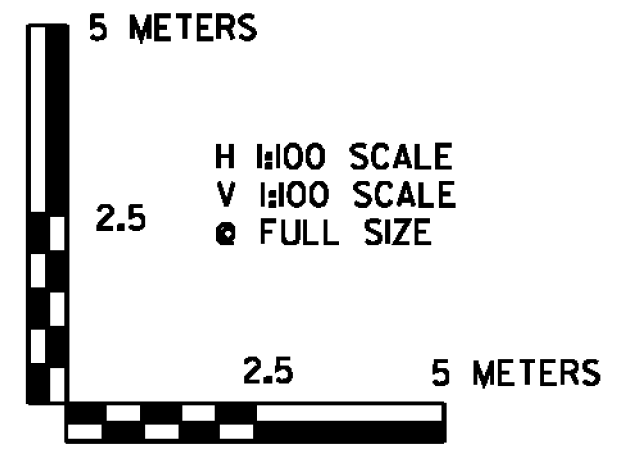

PROJECT NAME:	BENNINGTON
PROJECT NUMBER:	NH 019-(154)
FILE NAME:	...plot_files\zd307c4xs.279WB.ptf
DESIGN SUPERVISOR:	GREG EDWARDS
DESIGNED BY:	MARC FOISY
VT 279 WB CROSS SECTION	WBX-11
PLOT DATE:	1/26/2010
DRAWN BY:	STANTEC
CHECKED BY:	GARY SANTY
SHEET	322 OF 468

1/26/2010 4:56:05 PM v:\1953\getlive\19530002\tramsport\station\dr\cm\ng\cont\rcpt_4\plot_files\zd307c4xs.279WB.ptf