


SEE NOTE ON SHEET 312

WB 9+980

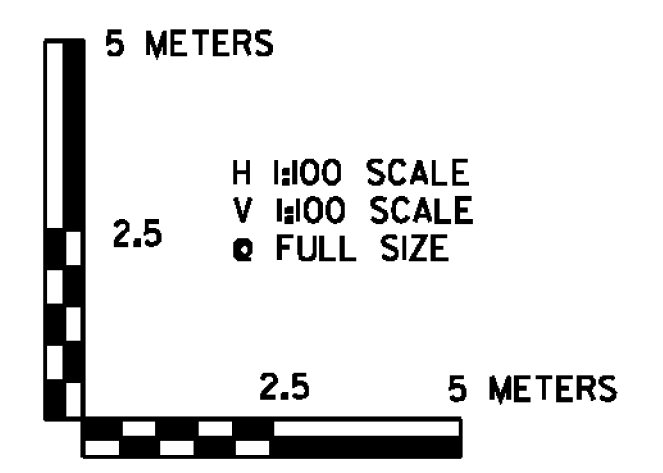

SEE REVISED

PROJECT NAME:	BENNINGTON
PROJECT NUMBER:	NH 019-1(54)
FILE NAME:	...plot_files\zd307c4xs.279WB.ptf
DESIGN SUPERVISOR:	GREG EDWARDS
DESIGNED BY:	MARC FOISY
VT 279 WB CROSS SECTION WBX-12	
PLOT DATE:	1/26/2010
DRAWN BY:	STANTEC
CHECKED BY:	GARY SANTY
SHEET	323 OF 468

1/26/2010 4:56:06 PM v:\1953\getlive\19530002\tr\anspor\getlive\dr\cwg\ng\com\tr\cst\4\plot_files\zd307c4xs.279WB.ptf