




WB 10+140  
WB 10+139.217 = NB 10+139.217, 3.6m RT.

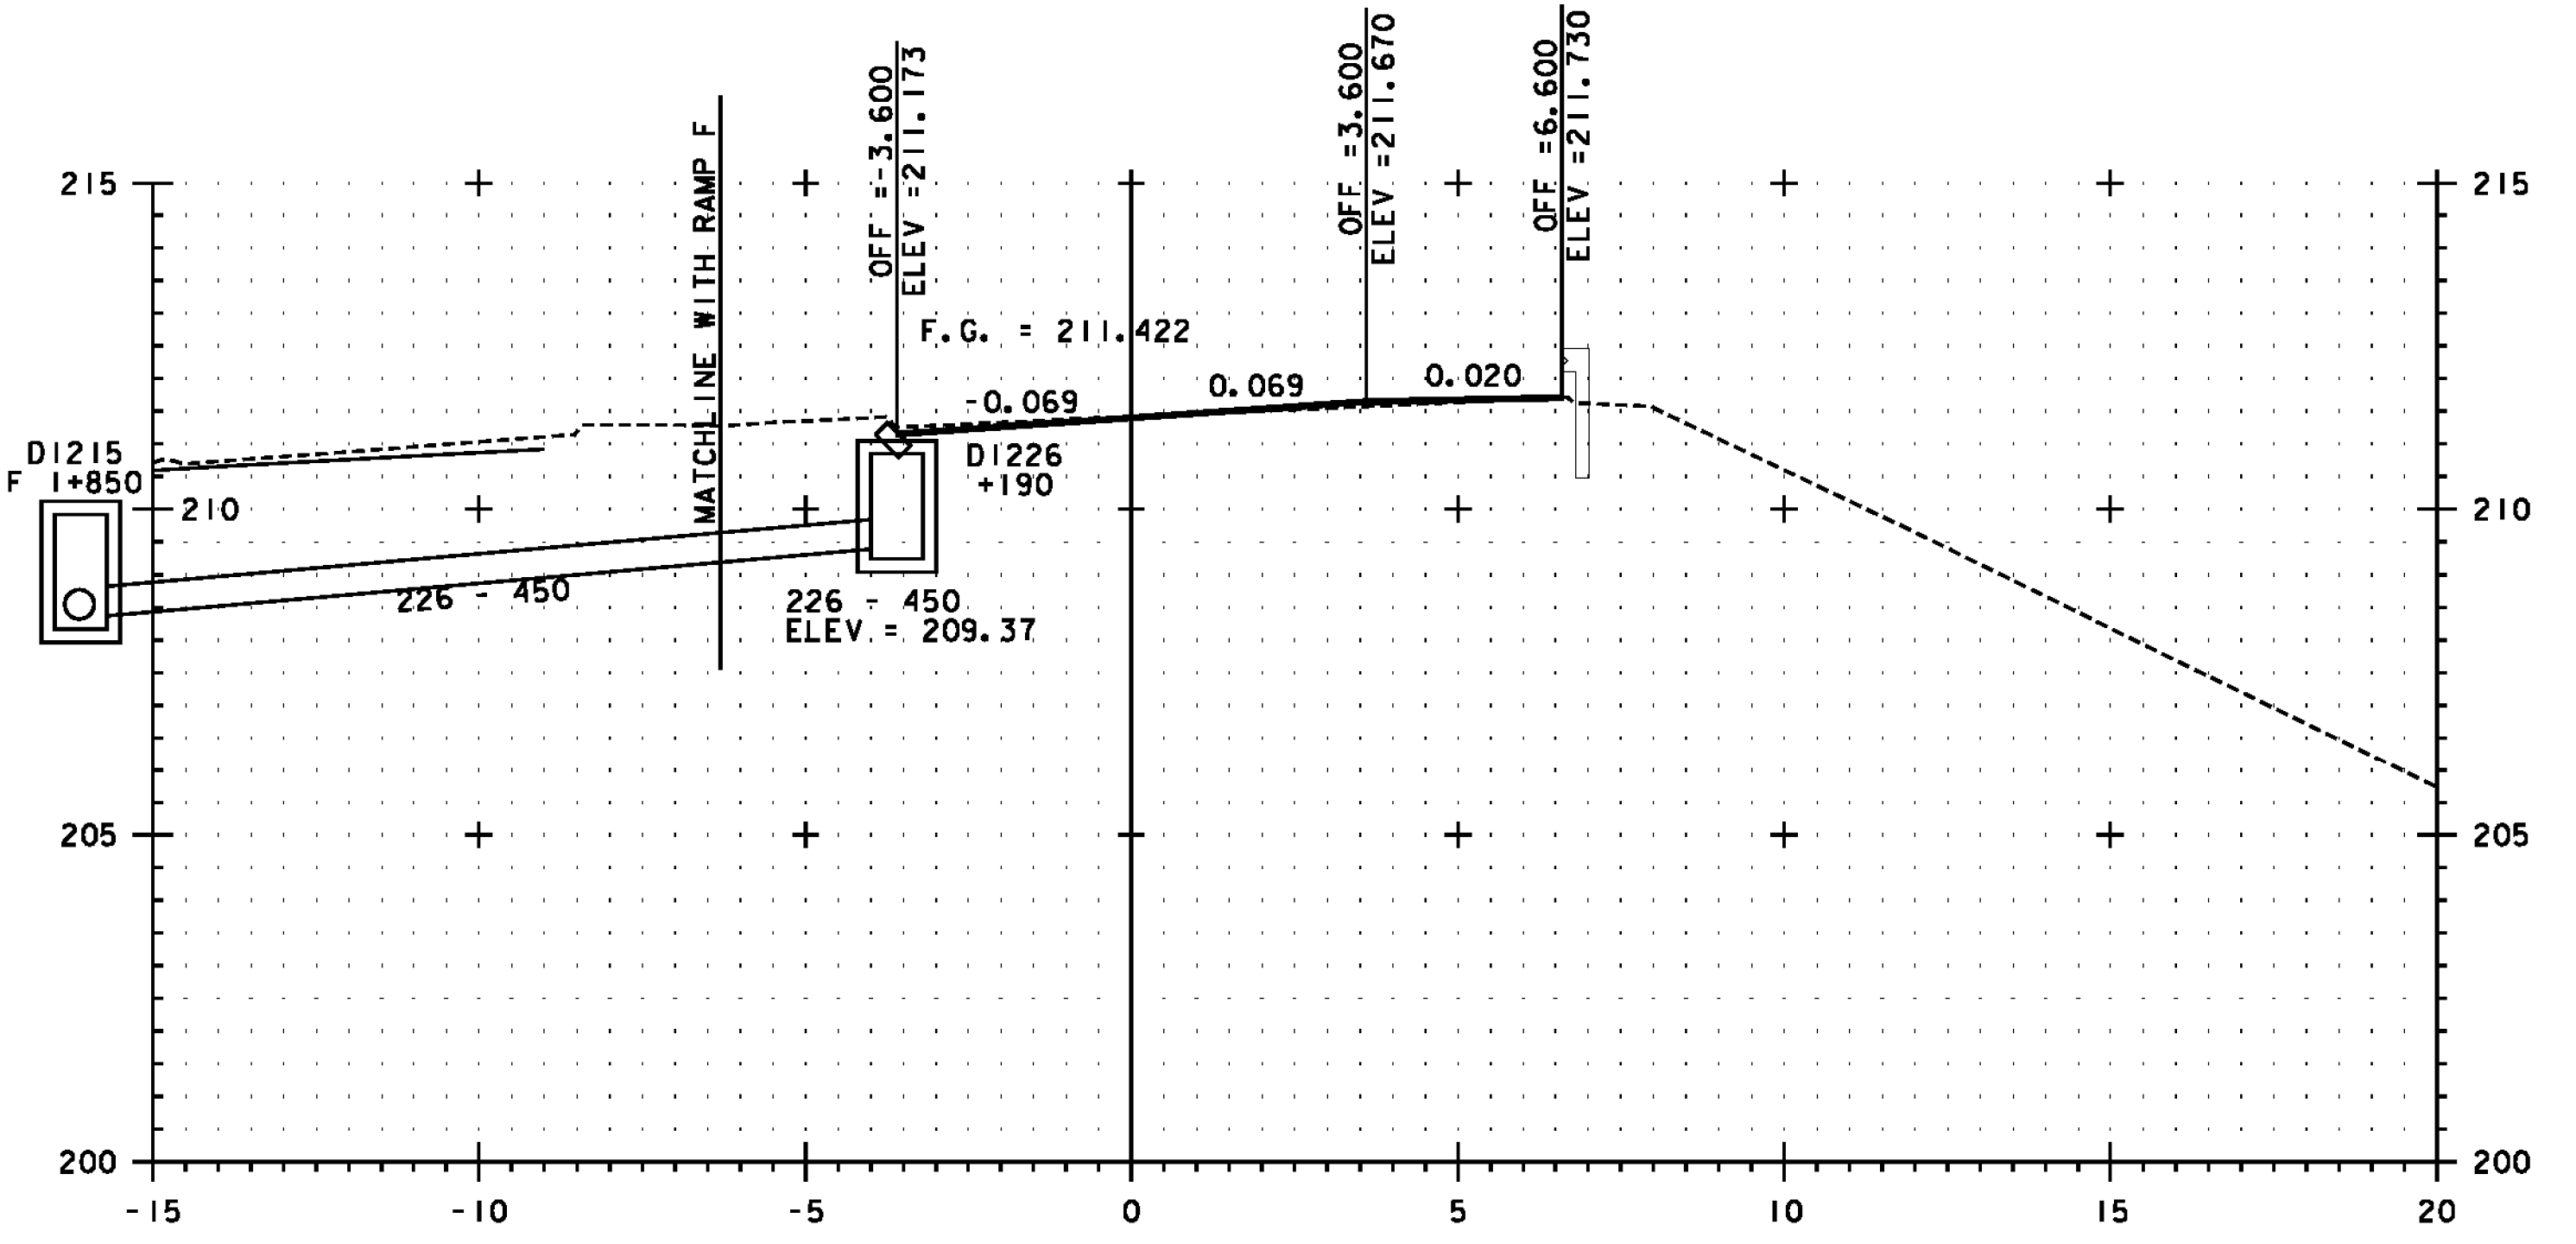

WB 10+180

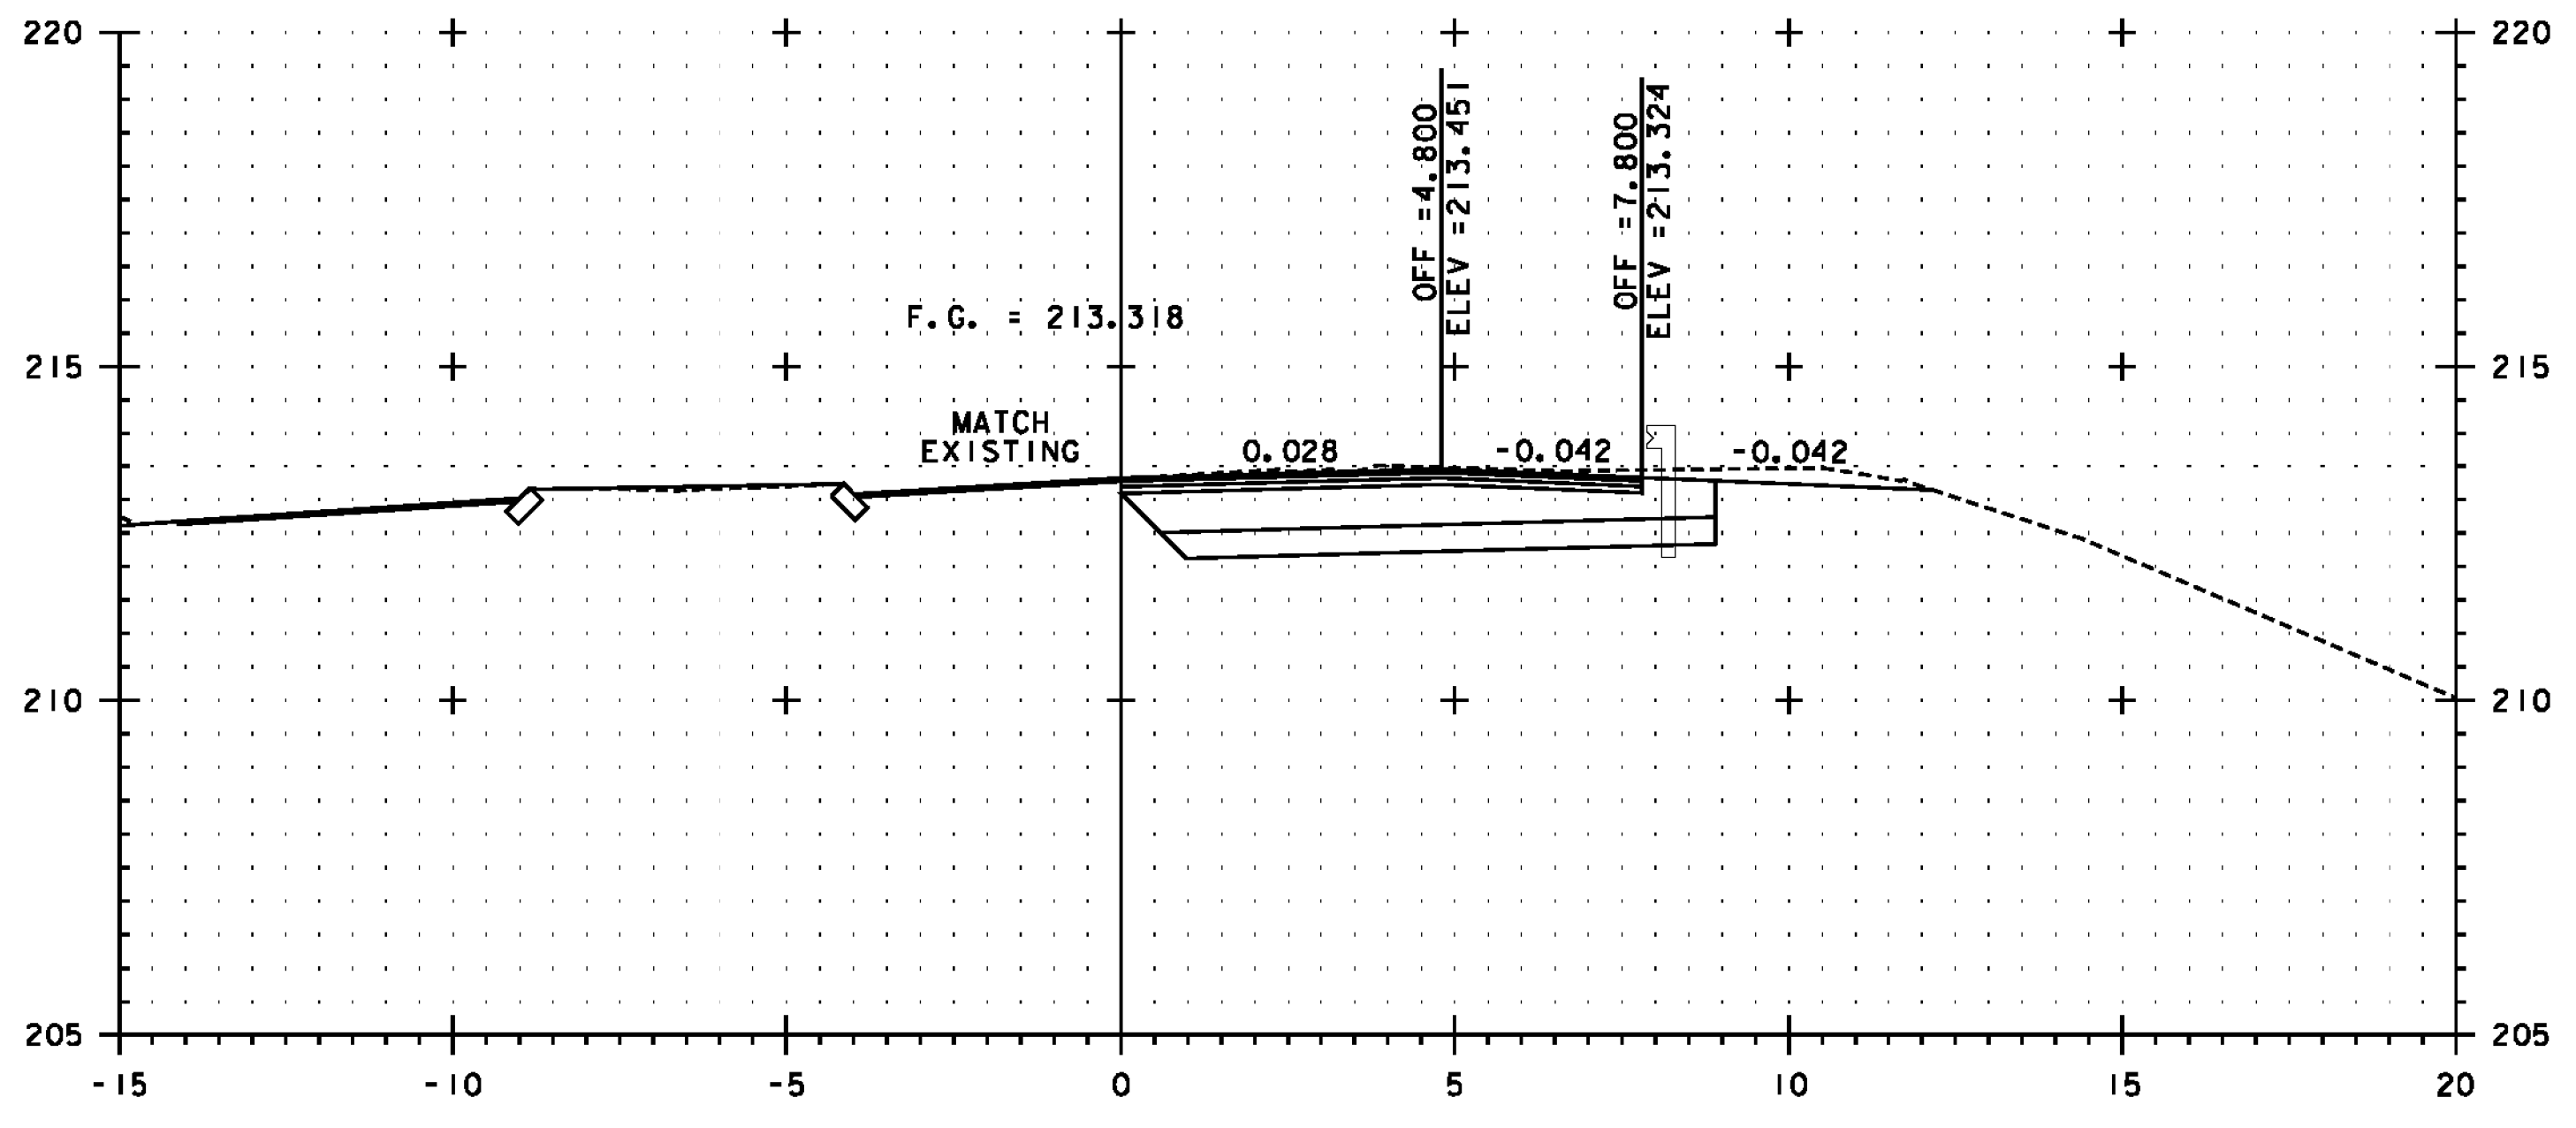


WB 10+120

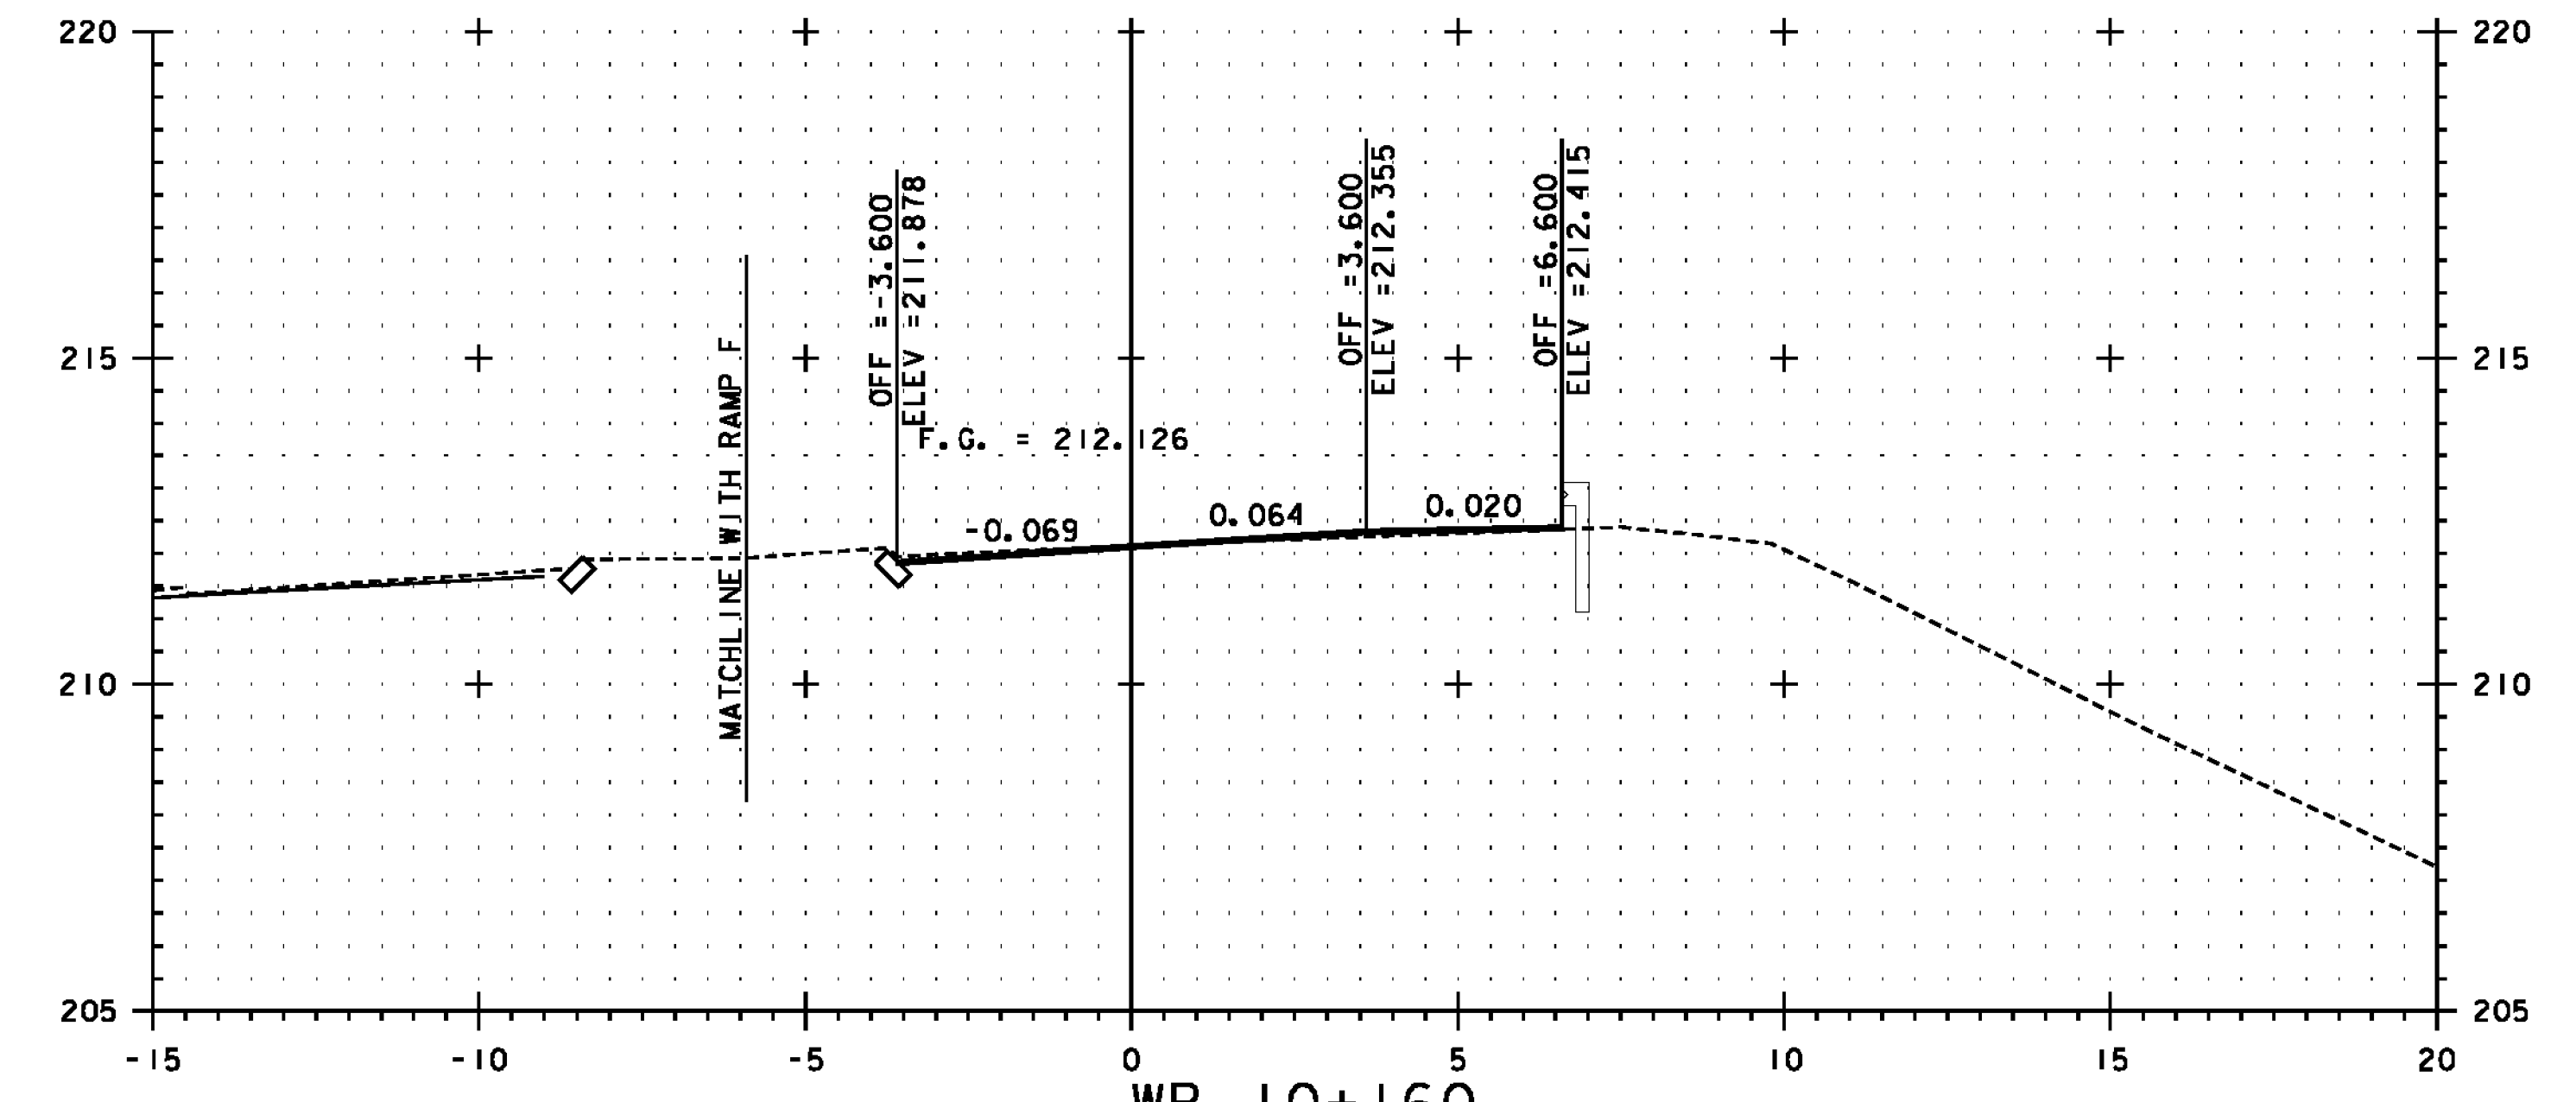

WB 10+160  
END FULL DEPTH CONSTRUCTION  
BEGIN COLD PLANE / OVERLAY

SEE NOTE ON SHEET 312

SEE REVISED

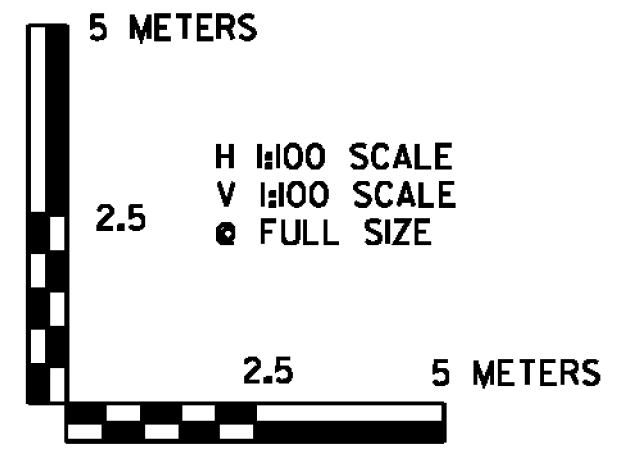

PROJECT NAME:	BENNINGTON
PROJECT NUMBER:	NH 019-(154)
FILE NAME:	...plot_files\zd307c4xs.279WB.ptf
DESIGN SUPERVISOR:	GREG EDWARDS
DESIGNED BY:	MARC FOISY
VT 279 WB CROSS SECTION WBX-14	
PLOT DATE:	1/26/2010
DRAWN BY:	STANTEC
CHECKED BY:	GARY SANTY
SHEET	325 OF 468

1/26/2010 4:56:08 PM V:\1953\getlive\19530002\tr\anspor\ref\ion\dr\w\ng\confr\cst\_4\plot\_files\zd307c4xs.279WB.ptf