




WB 10+220

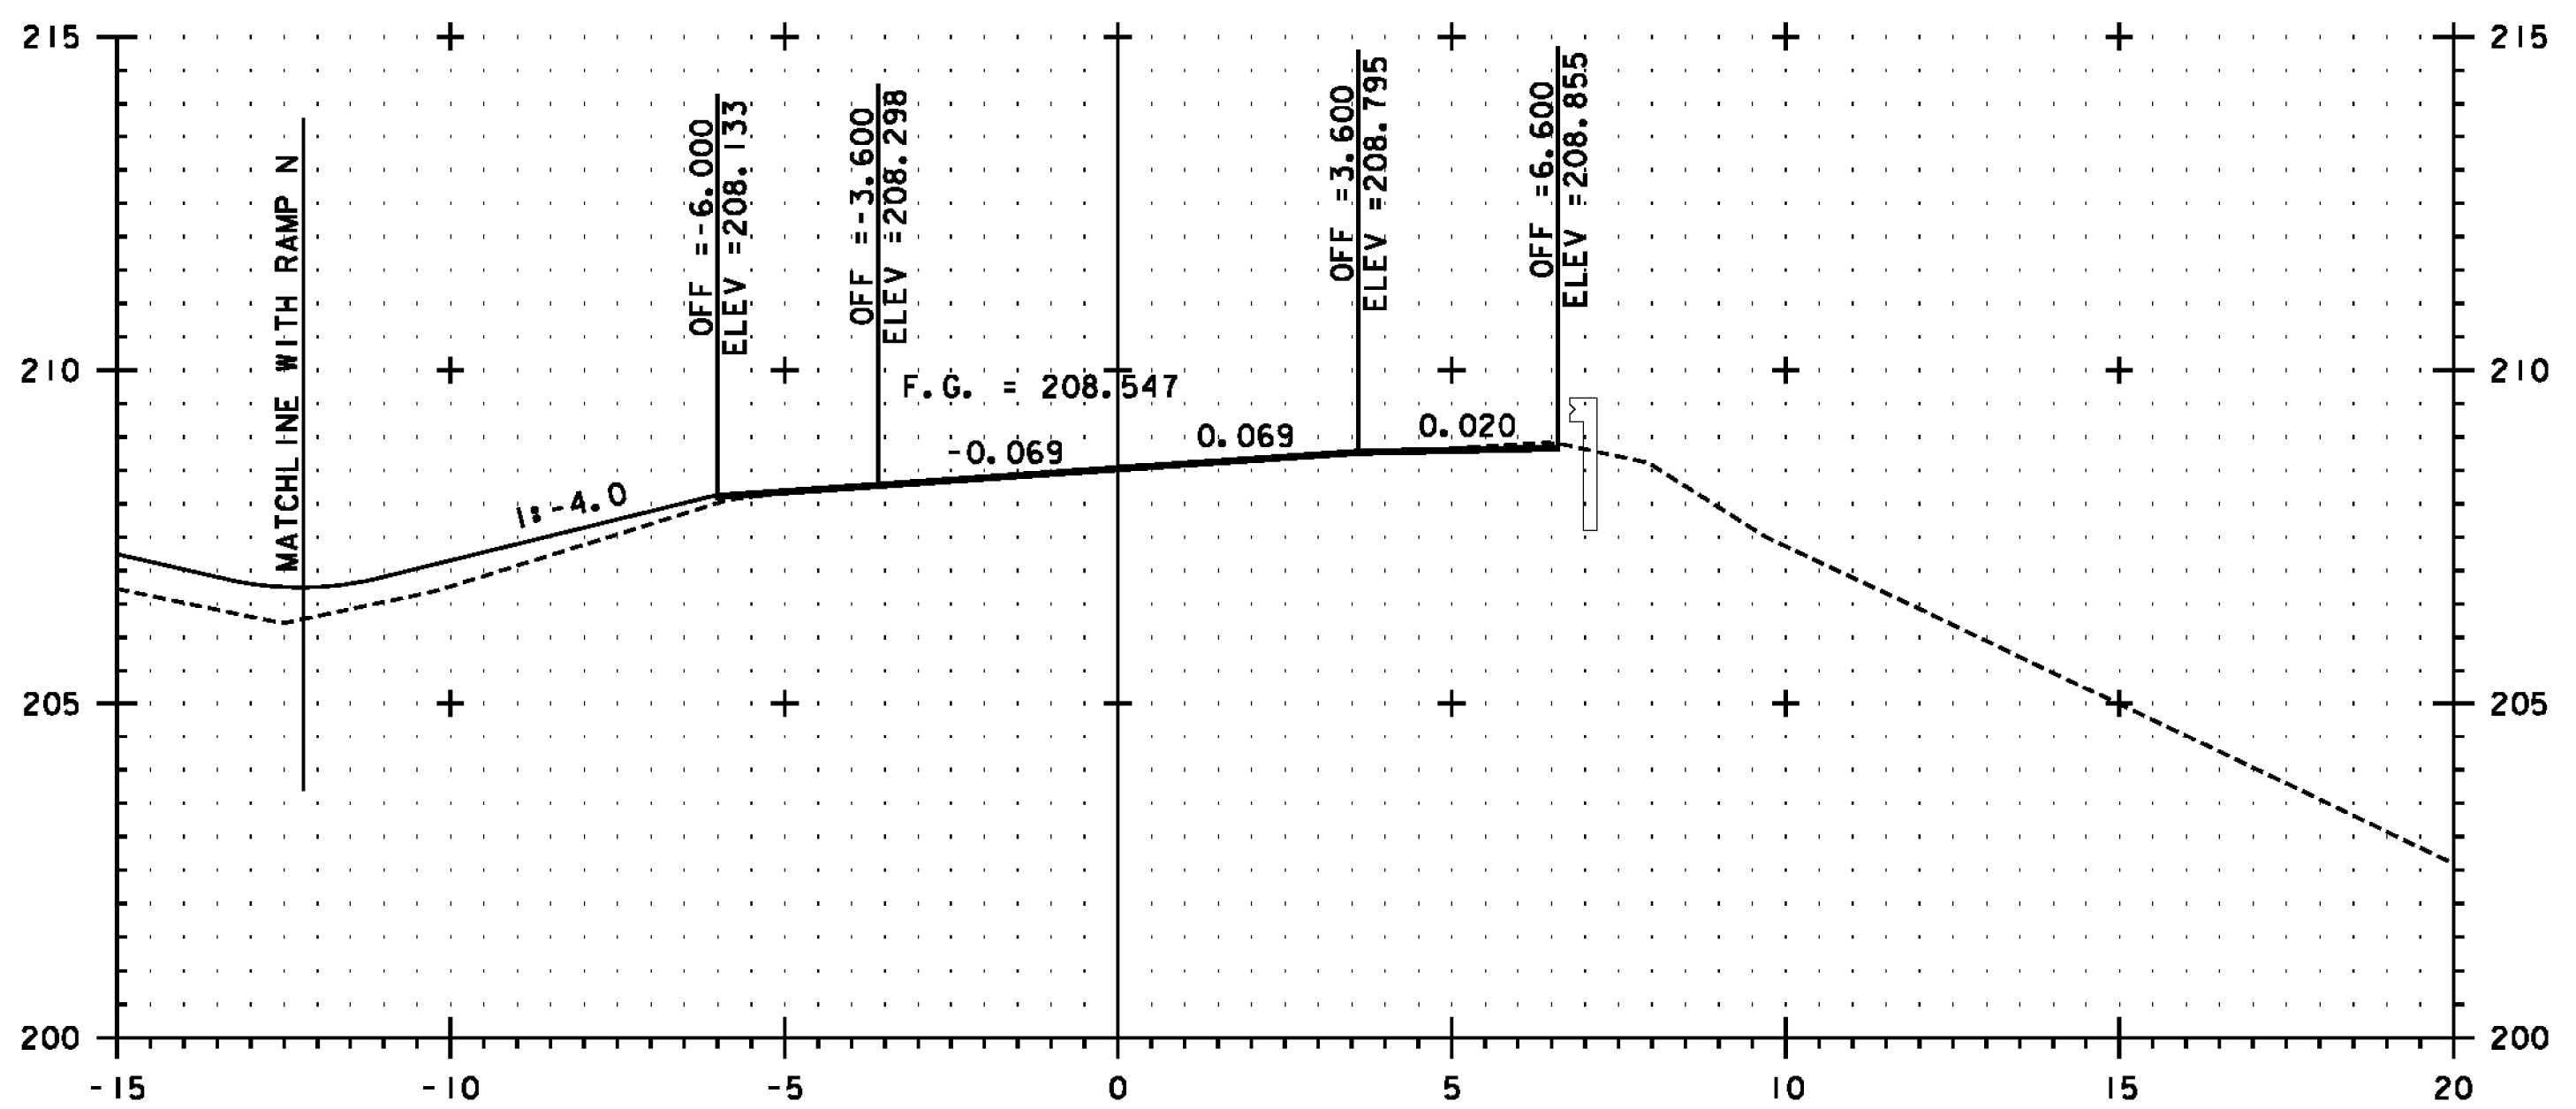

WB 10+260

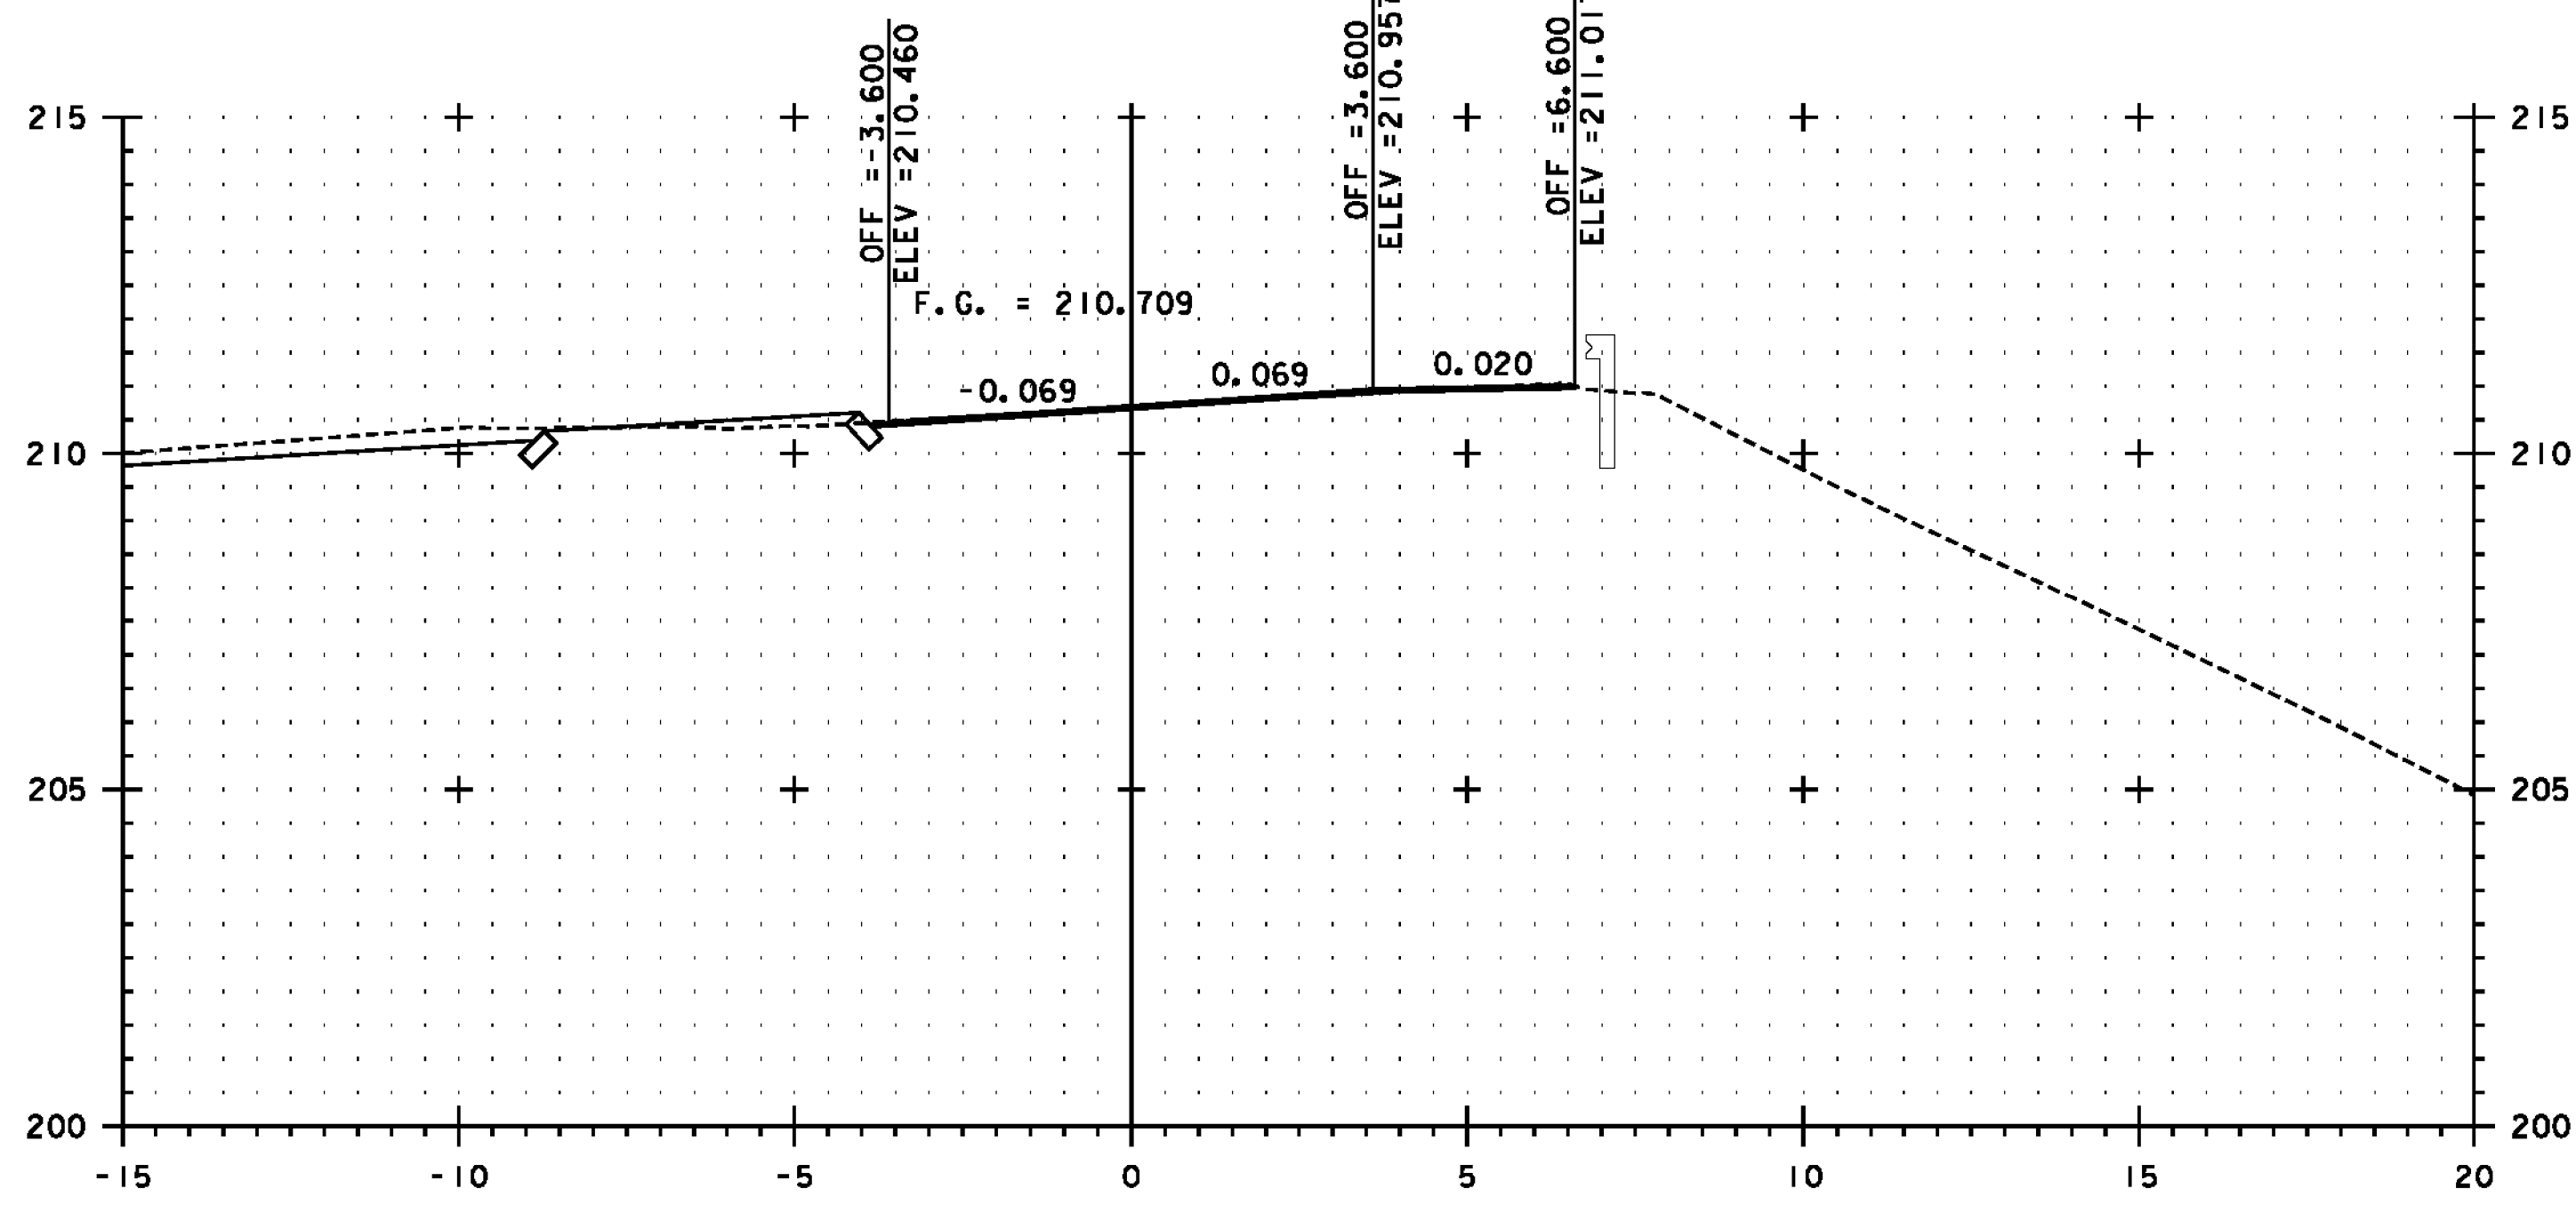


WB 10+200

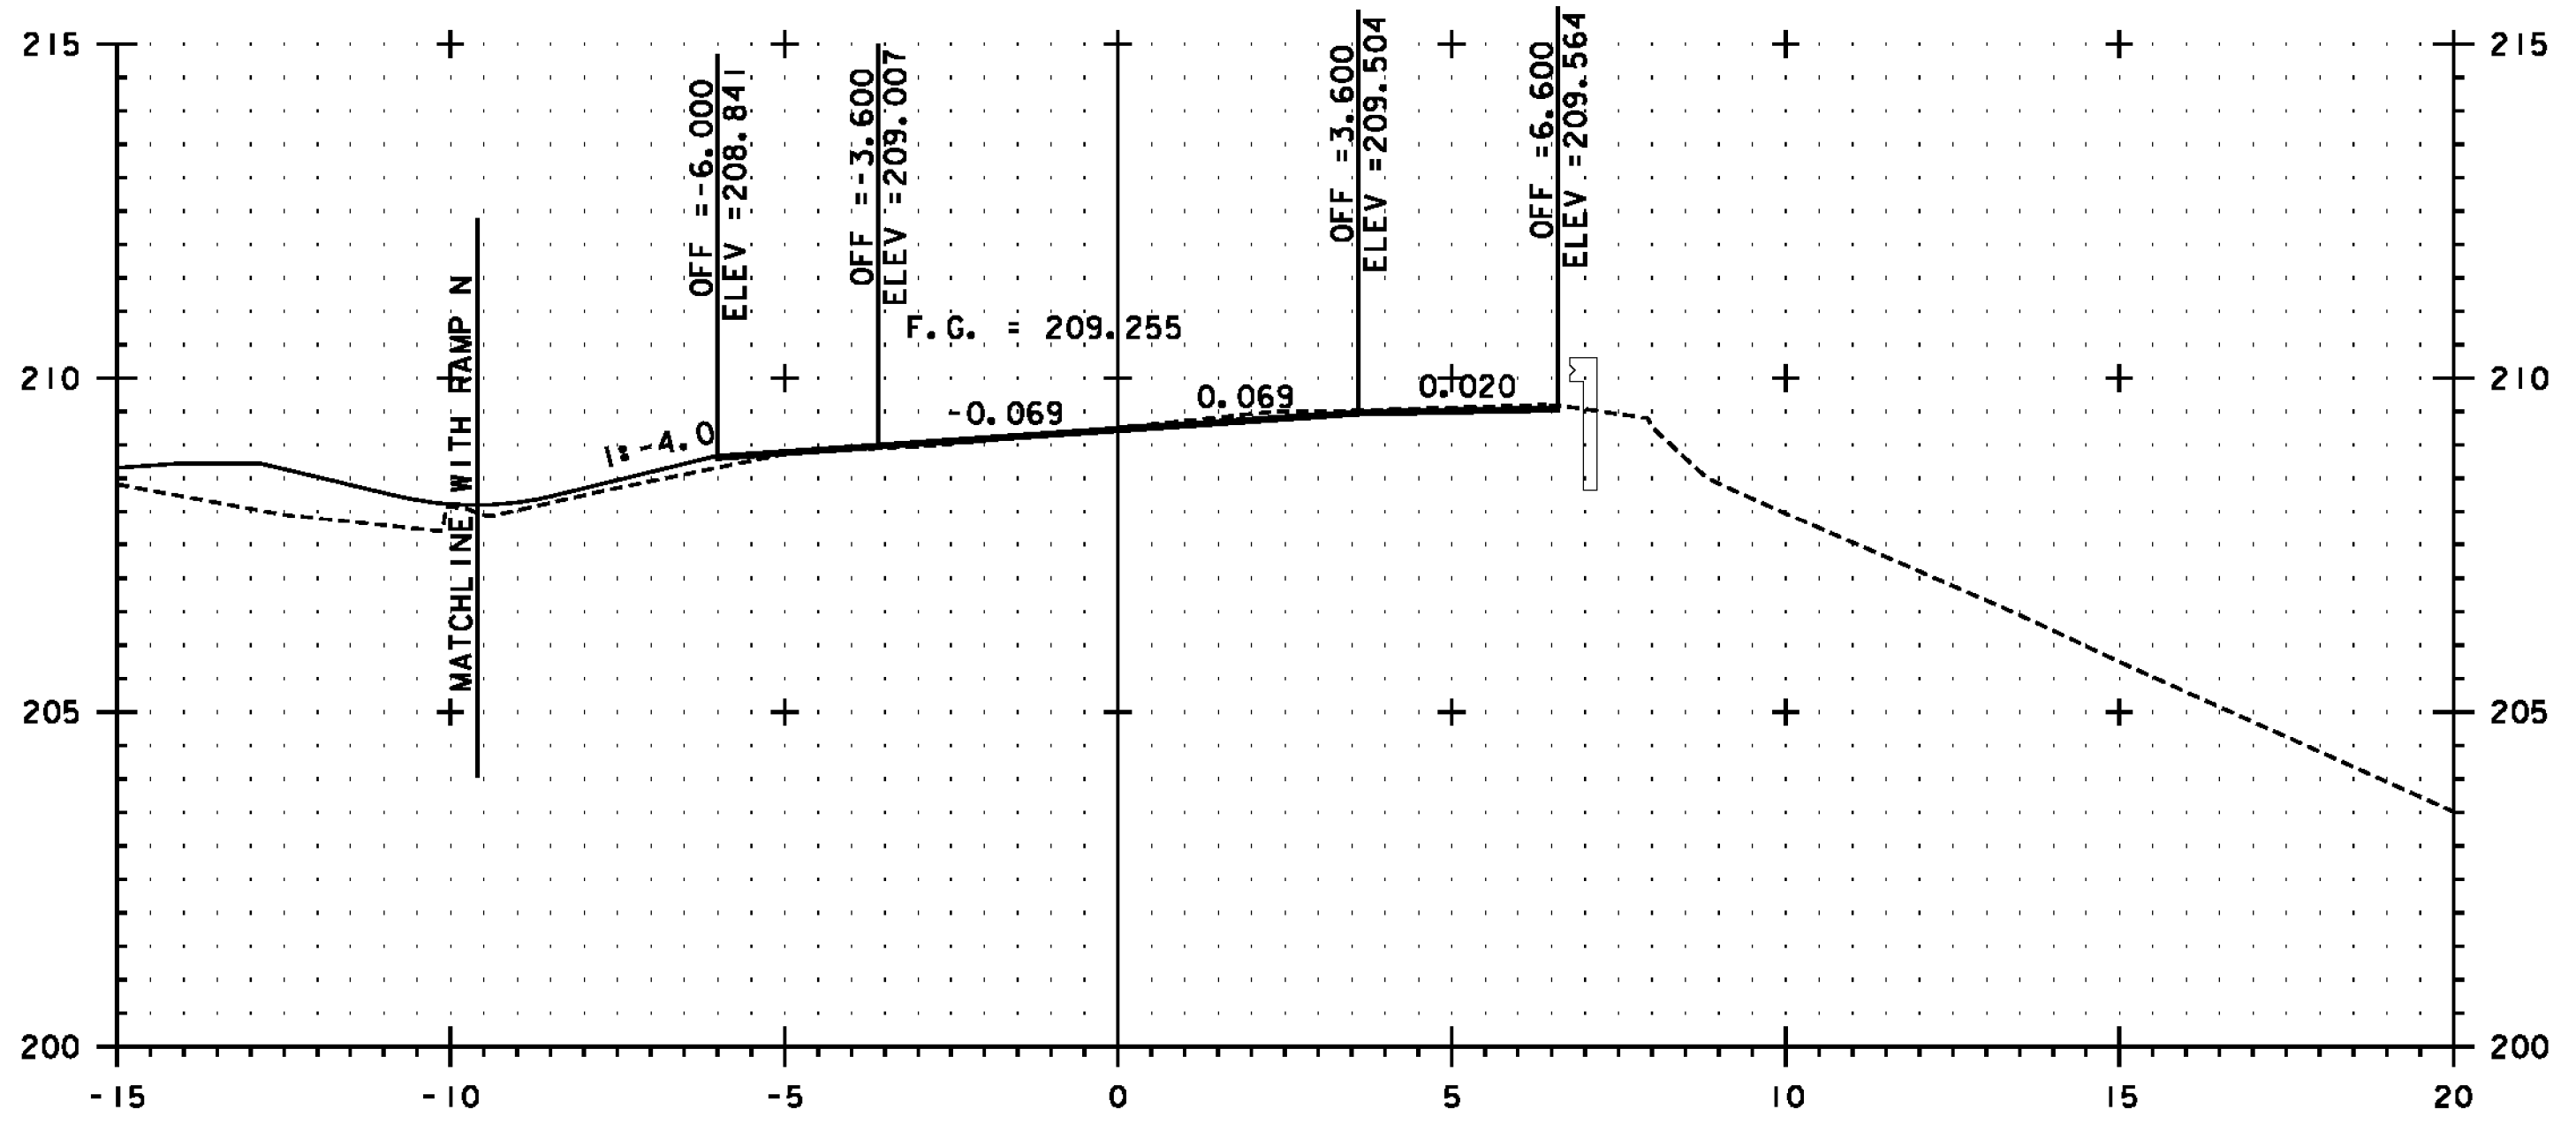

WB 10+240

SEE NOTE ON SHEET 312

SEE REVISED

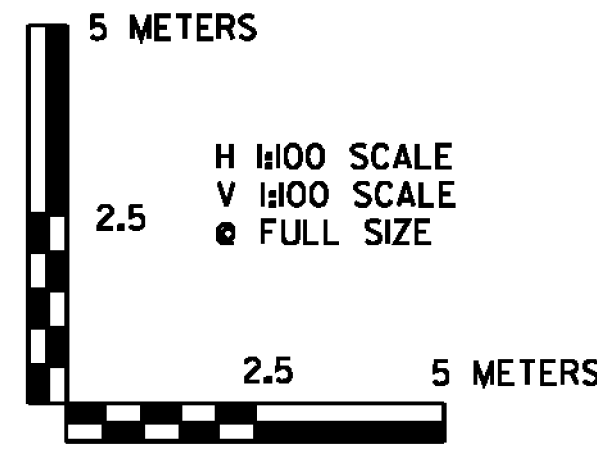

PROJECT NAME:	BENNINGTON
PROJECT NUMBER:	NH 019-(154)
FILE NAME:	...\\plot_files\zd307c4xs.279WB.ptf
DESIGN SUPERVISOR:	GREG EDWARDS
DESIGNED BY:	MARC FOISY
VT 279 WB CROSS SECTION	WBX-15
PLOT DATE:	1/26/2010
DRAWN BY:	STANTEC
CHECKED BY:	GARY SANTY
SHEET	326 OF 468

1/26/2010 4:56:09 PM v:\1953\getlive\1953\0002\tr\anspor\101\dr\dwg\con\tr\001\_4\plot\_files\zd307c4xs.279WB.ptf