



WB 10+380

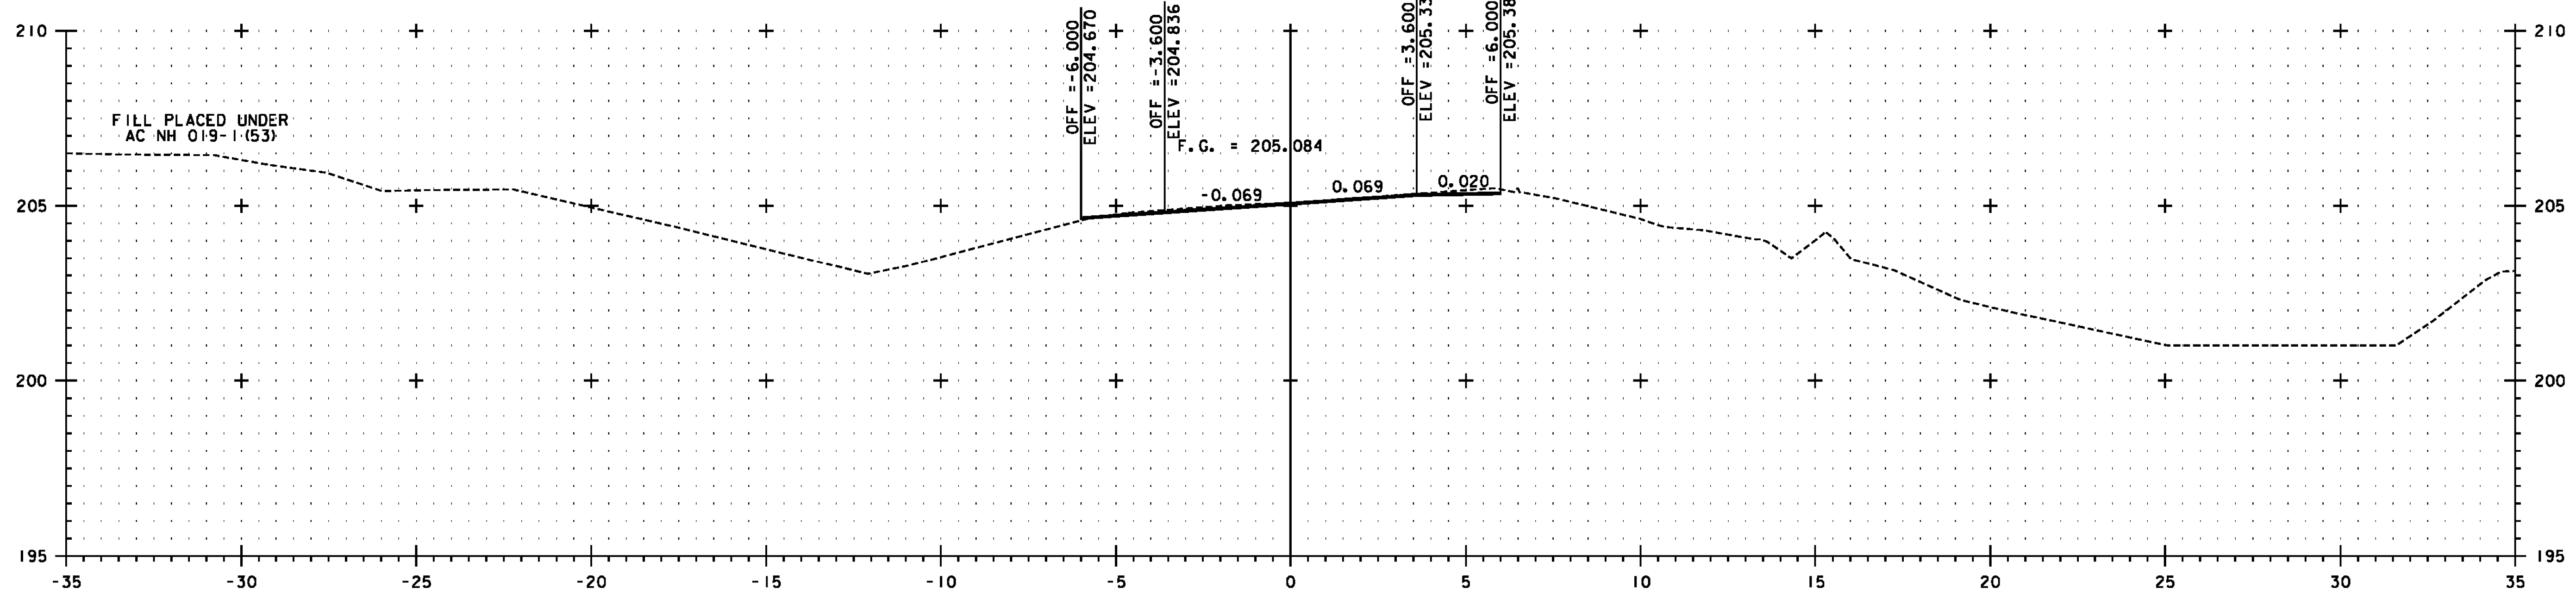

WB 10+360

SEE NOTE ON SHEET 312

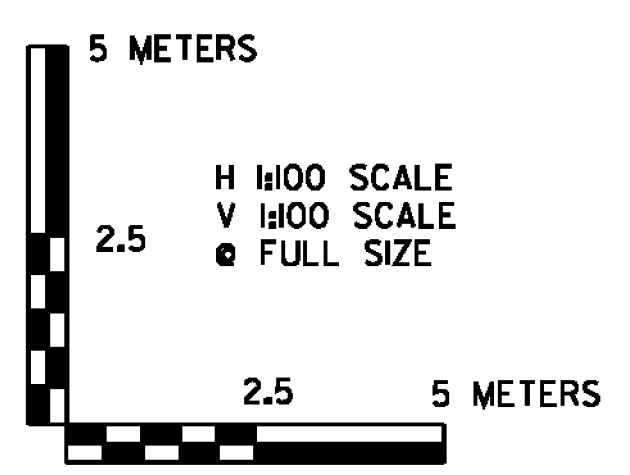

SEE REVISED



PROJECT NAME:	BENNINGTON
PROJECT NUMBER:	NH 019-(154)
FILE NAME:	...\\plot_files\zd307c4xs.279WB.ptf
DESIGN SUPERVISOR:	GREG EDWARDS
DESIGNED BY:	MARC FOISY
VT 279 WB CROSS SECTION WBX-18	
PLOT DATE:	1/26/2010
DRAWN BY:	STANTEC
CHECKED BY:	GARY SANTY
SHEET	329 OF 468

1/26/2010 4:56:22 PM v:\1953\getlive\1953\0002\transportation\drawings\contract\4\plot_files\zd307c4xs.279WB.ptf