


SEE NOTE ON SHEET 312

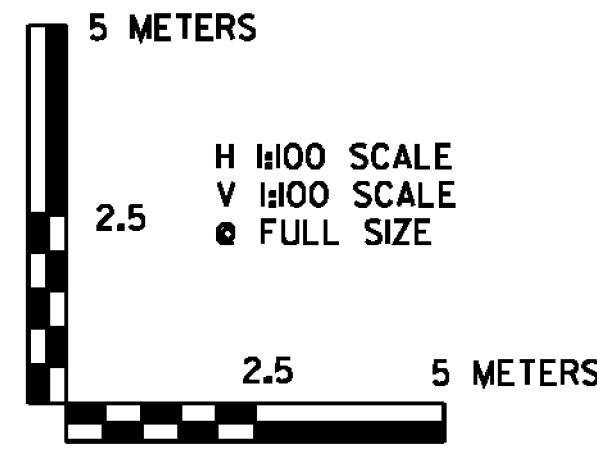

SEE REVISED

PROJECT NAME:	BENNINGTON
PROJECT NUMBER:	NH 019-(154)
FILE NAME:	...\\plot_files\zd307c4xs.279WB.ptf
DESIGN SUPERVISOR:	GREG EDWARDS
DESIGNED BY:	MARC FOISY
VT 279 WB CROSS SECTION	WBX-19
PLOT DATE:	1/26/2010
DRAWN BY:	STANTEC
CHECKED BY:	GARY SANTY
SHEET	330 OF 468

1/26/2010 4:56:13 PM v:\1953\getlive\1953\0002\tr\anspor\101\dr\cm\ng\con\tr\cst_4\plot_files\zd307c4xs.279WB.ptf