


WB 10+440

SEE NOTE ON SHEET 312



SEE REVISED

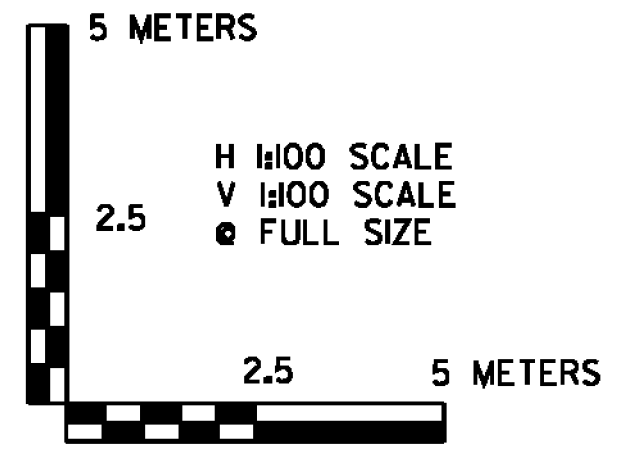

PROJECT NAME:	BENNINGTON
PROJECT NUMBER:	NH 019-1(54)
FILE NAME:	...plot_files\zd307c4xs.279WB.ptf
DESIGN SUPERVISOR:	GREG EDWARDS
DESIGNED BY:	MARC FOISY
VT 279 WB CROSS SECTION	WBX-20
PLOT DATE:	1/26/2010
DRAWN BY:	STANTEC
CHECKED BY:	GARY SANTY
SHEET	331 OF 468

1/26/2010 4:56:14 PM v:\1953\getlive\1953\002A\tr\mspor\getlive\dr\w\ng\con\tr\cpl_4\plot_files\zd307c4xs.279WB.ptf