



WB 10+466.819 = NB 10+466.819  
 END COLD PLANE / OVERLAY  
 BEGIN FULL DEPTH CONSTRUCTION

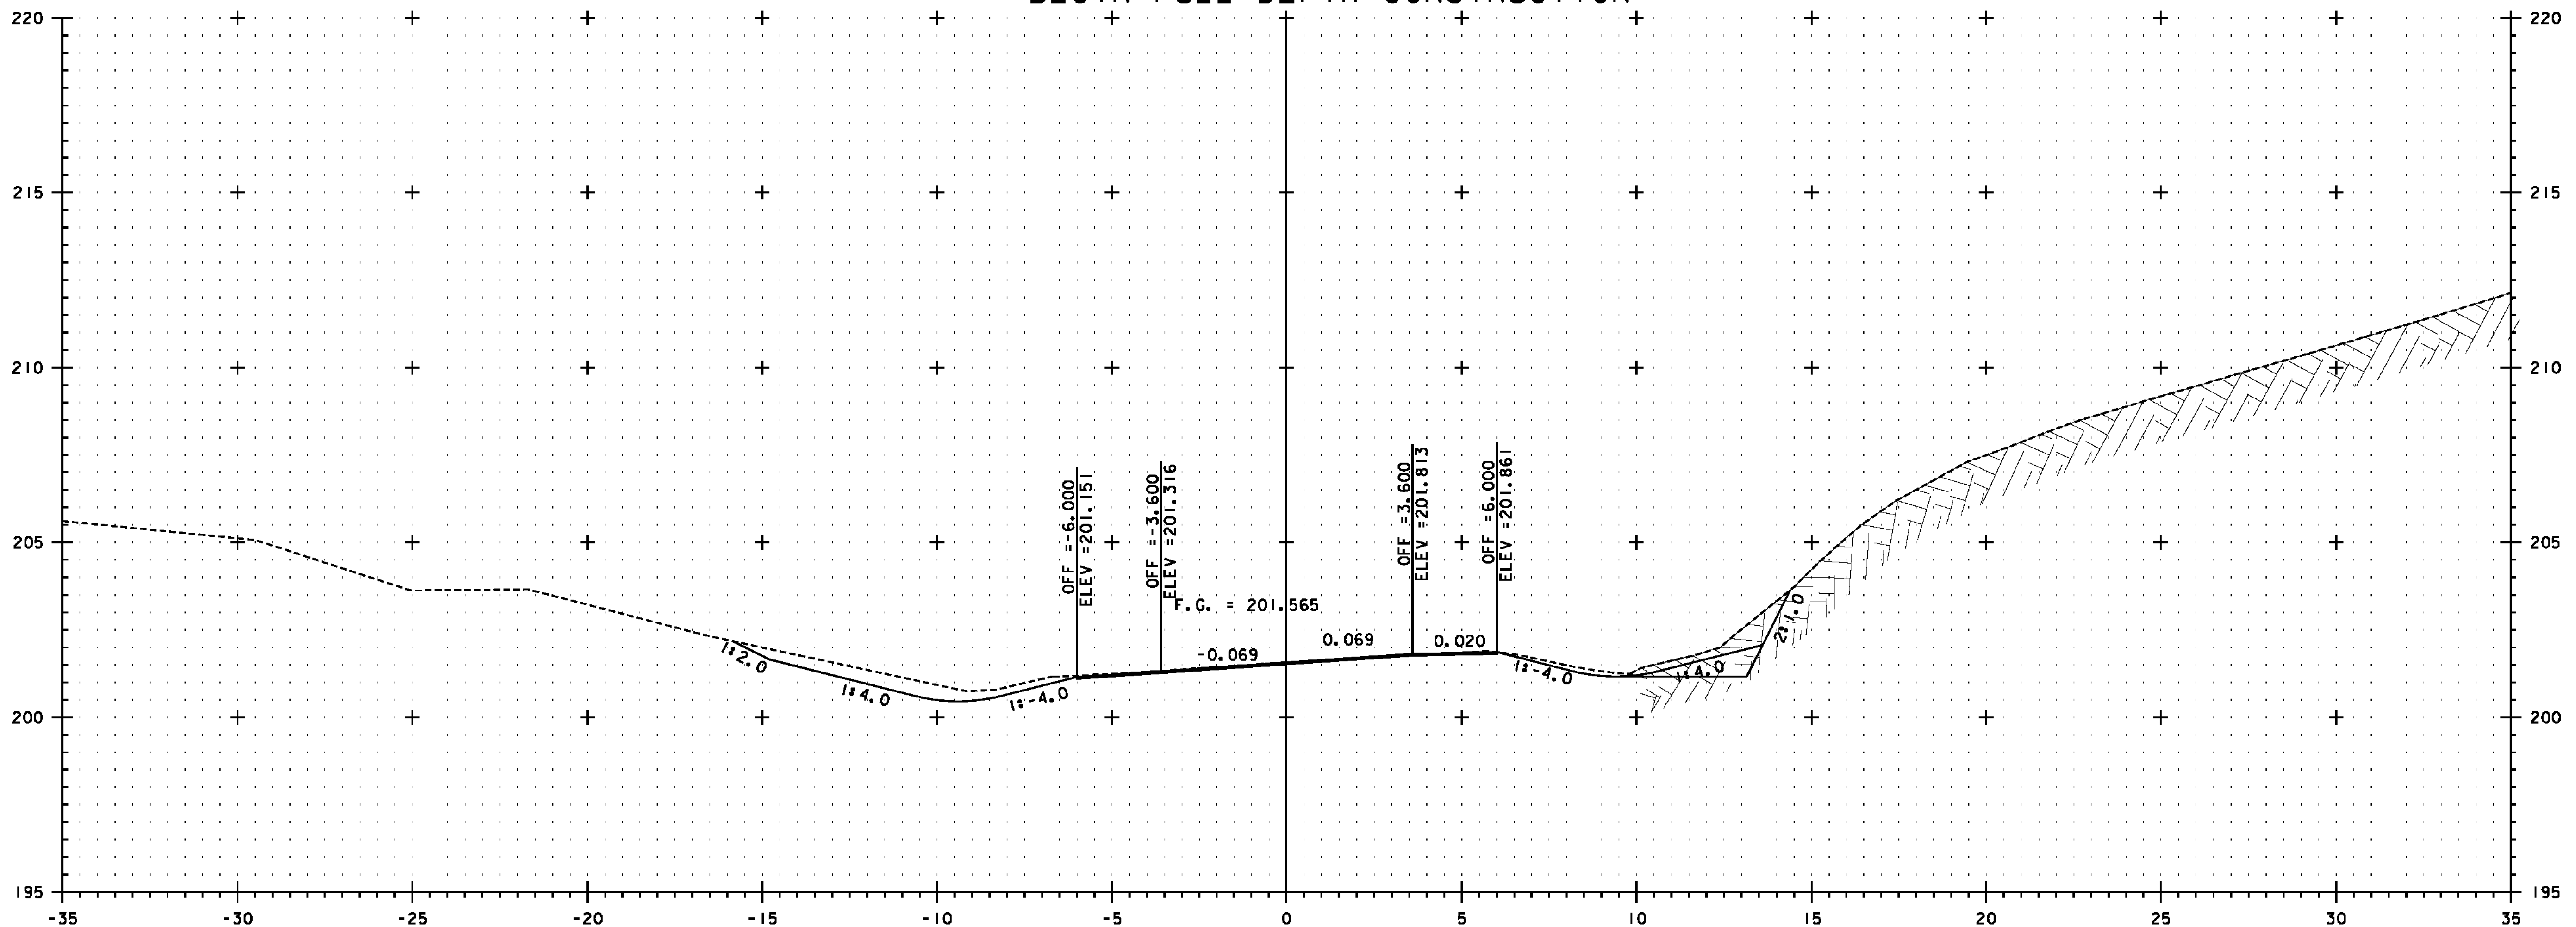

WB 10+460

SEE NOTE ON SHEET 312

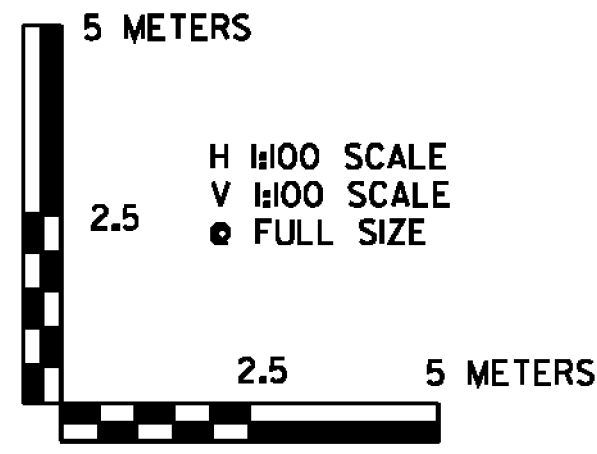

SEE REVISED



PROJECT NAME:	BENNINGTON
PROJECT NUMBER:	NH 019-(154)
FILE NAME:	...plot_files\zd307c4xs.279WB.ptf
DESIGN SUPERVISOR:	GREG EDWARDS
DESIGNED BY:	MARC FOISY
VT 279 WB CROSS SECTION	WBX-21
PLOT DATE:	1/26/2010
DRAWN BY:	STANTEC
CHECKED BY:	GARY SANTY
SHEET	332 OF 468

1/26/2010 4:56:15 PM v:\1953\getlive\19530002\tr\anspor\101\10\dr\cwg\ng\cont\tr\cp1\_4\plot\_files\zd307c4xs.279WB.ptf