


SEE NOTE ON SHEET 312



SEE REVISED

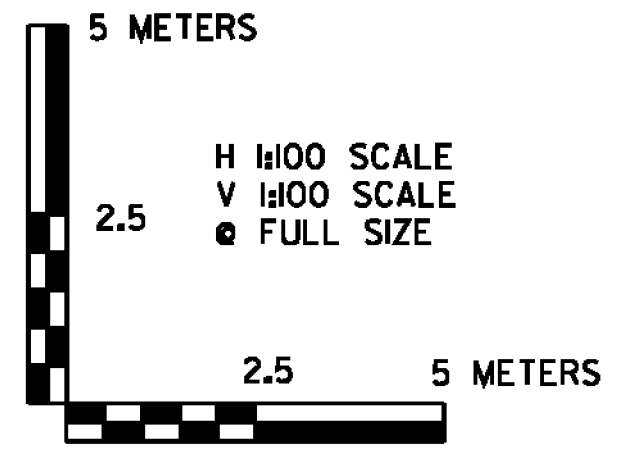

PROJECT NAME:	BENNINGTON
PROJECT NUMBER:	NH 019-(154)
FILE NAME:	...\\plot_files\zd307c4xs.279WB.ptf
DESIGN SUPERVISOR:	GREG EDWARDS
DESIGNED BY:	MARC FOISY
VT 279 WB CROSS SECTION WBX-23	
PLOT DATE:	1/26/2010
DRAWN BY:	STANTEC
CHECKED BY:	GARY SANTY
SHEET	334 OF 468

I:\26\2010_45617 PM_VA\953\getlive\9530002A\tramsport\101\dr\cm\ng\com\tr\cst_4\plot_files\zd307c4xs.279WB.ptf