




WB 10+643.6

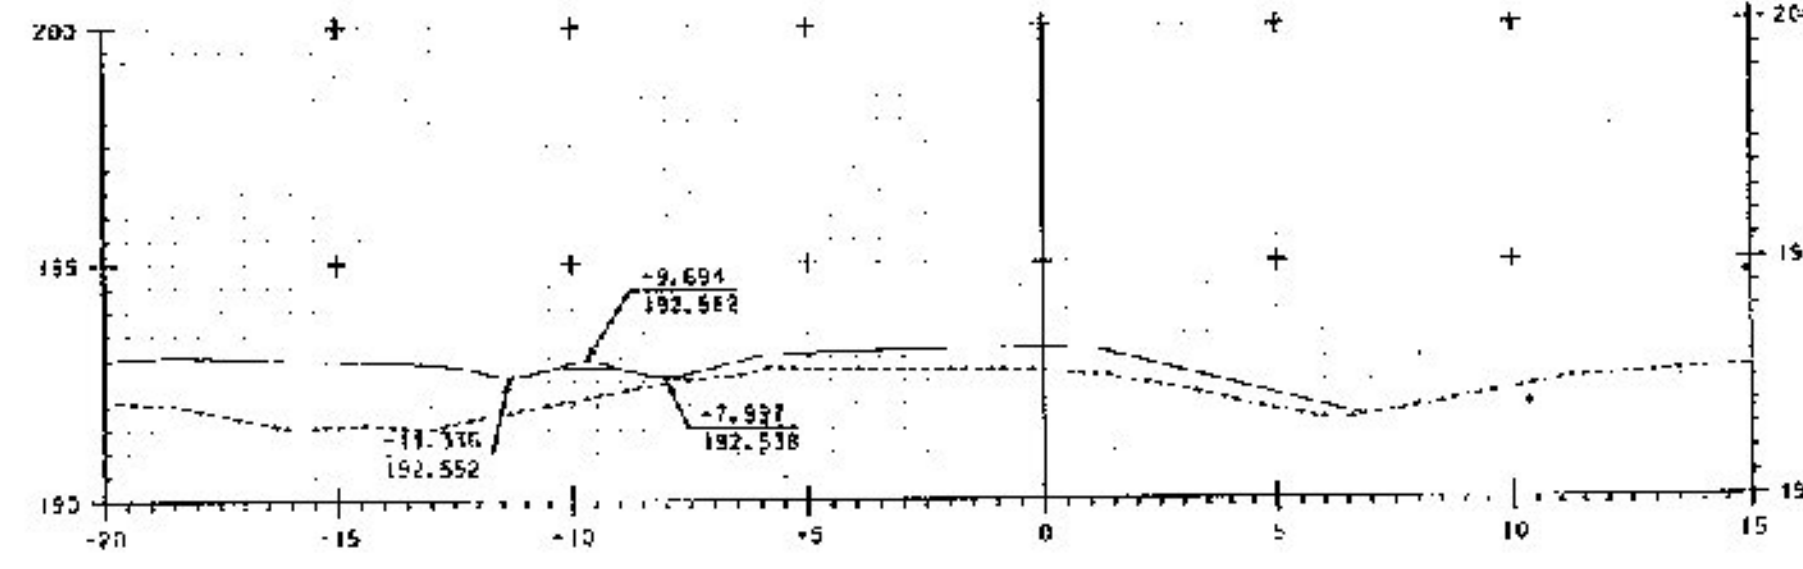


WB 10+700

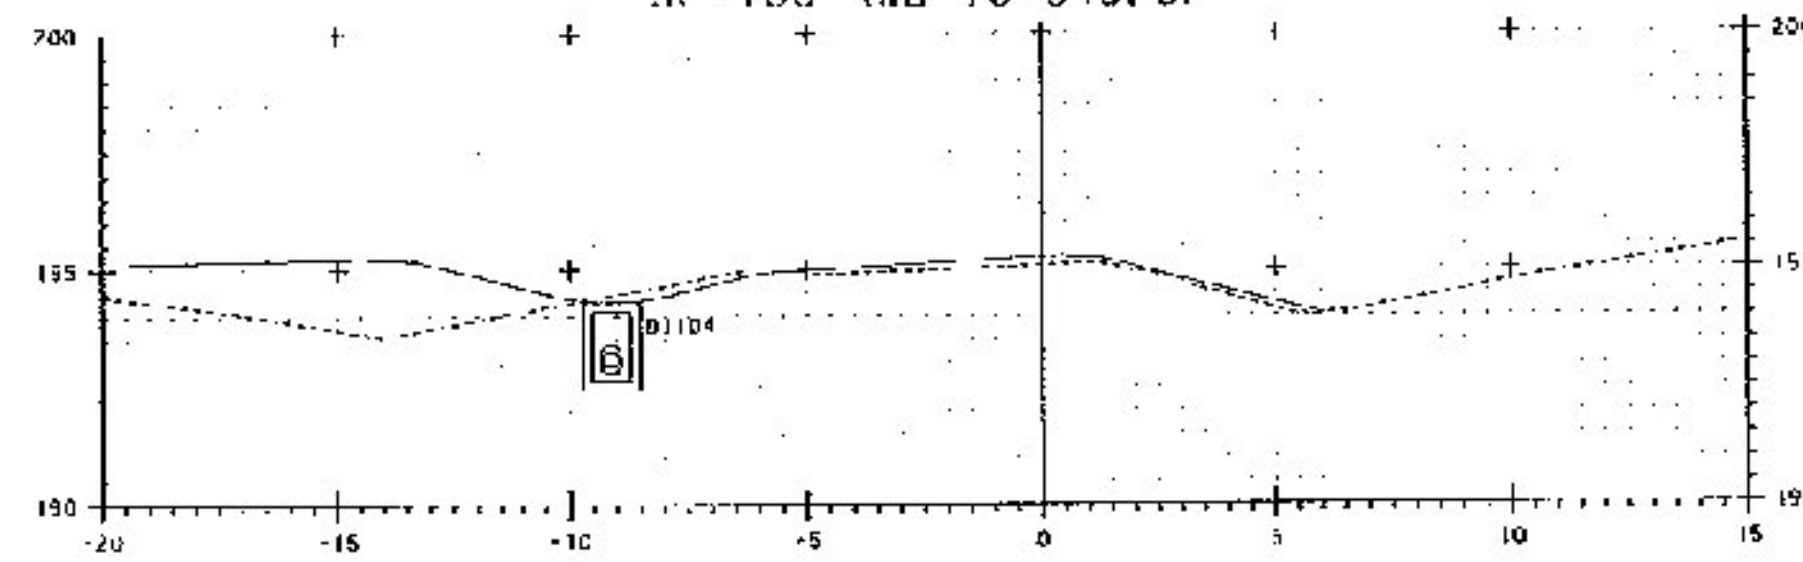

WB 10+610

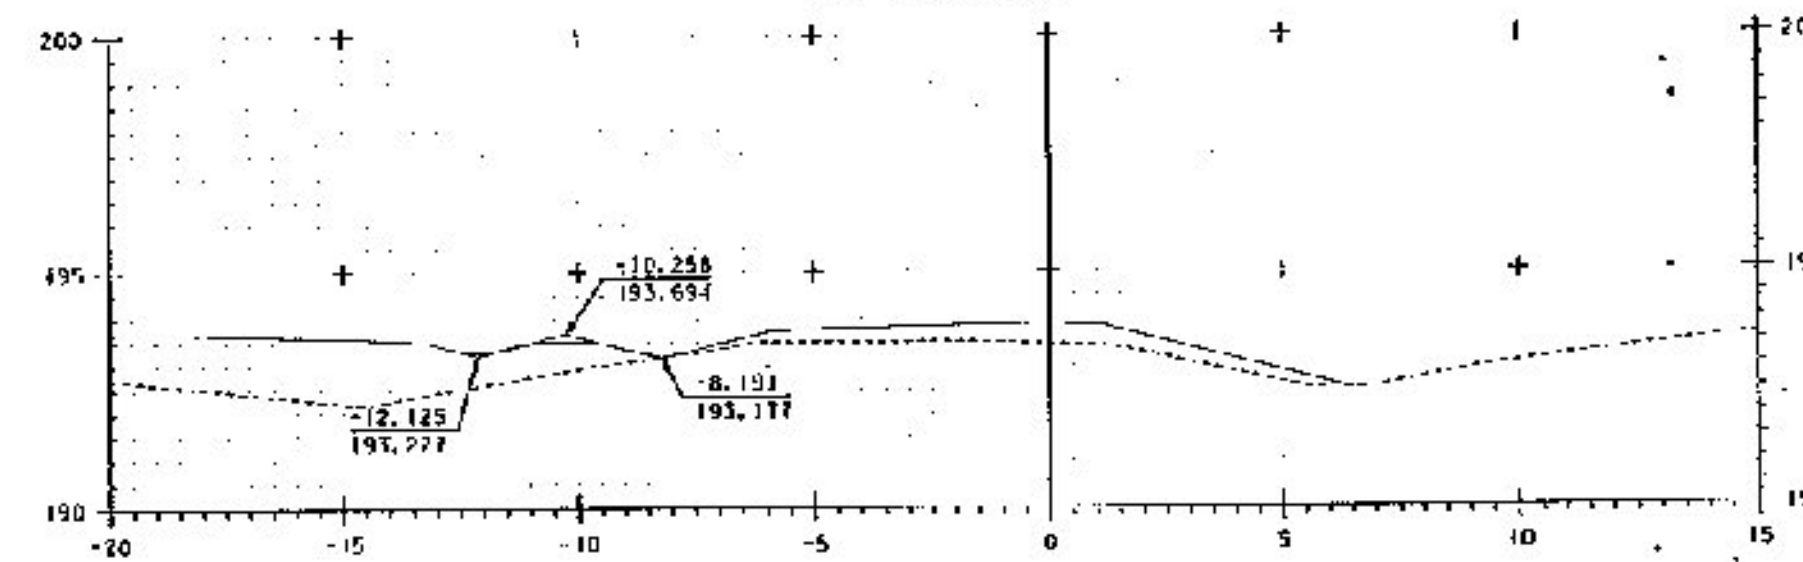


WB 10+680

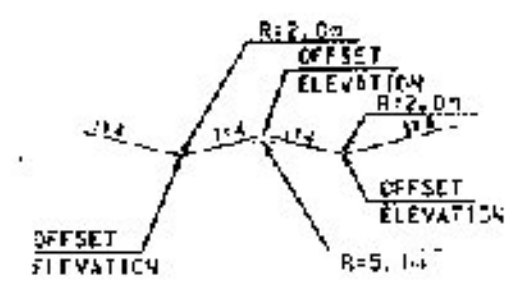

MEDIAN BERM TYPICAL SECTION

NOTE:
ELEVATIONS SHOWN TAKE INTO ACCOUNT
THE ROUNDING OF THE DITCH OR BERM.

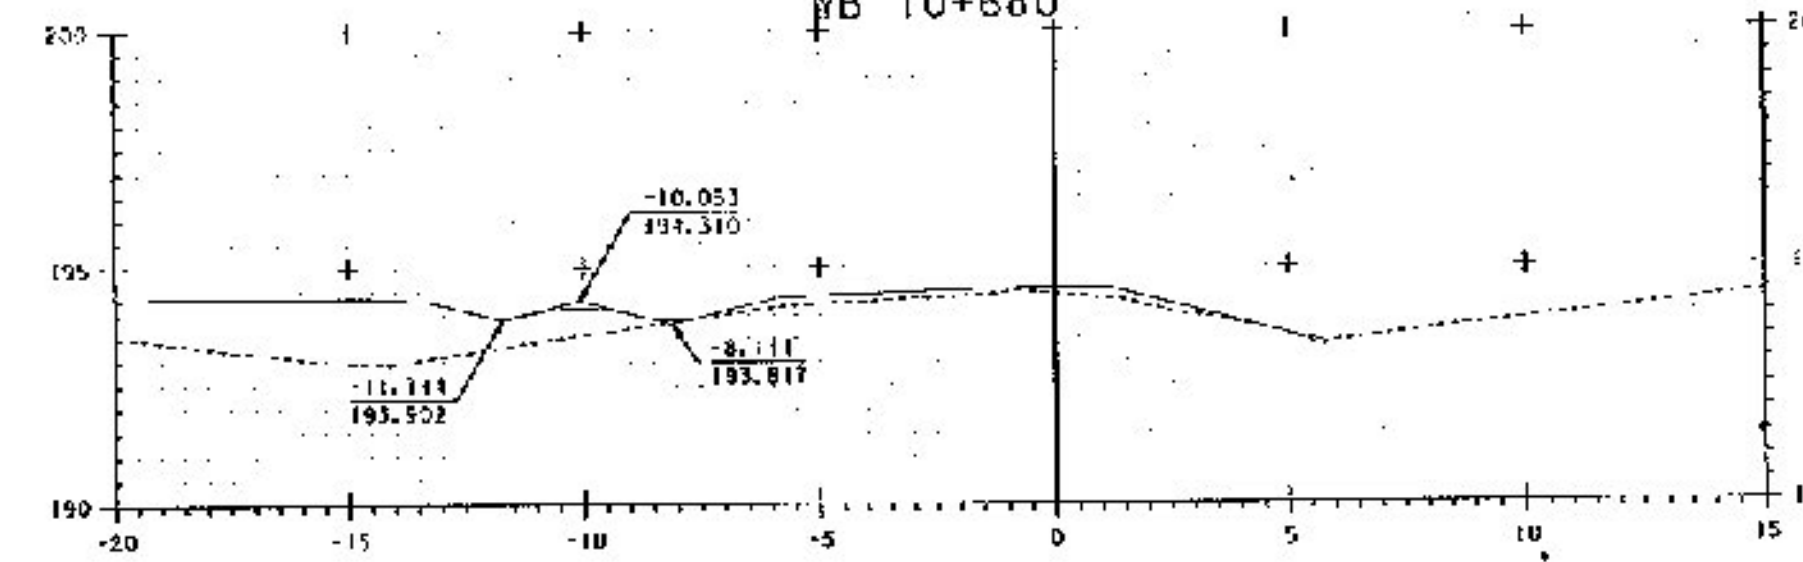

WB 10+660

*Light Pole
Record Plans*