


WB 10+715

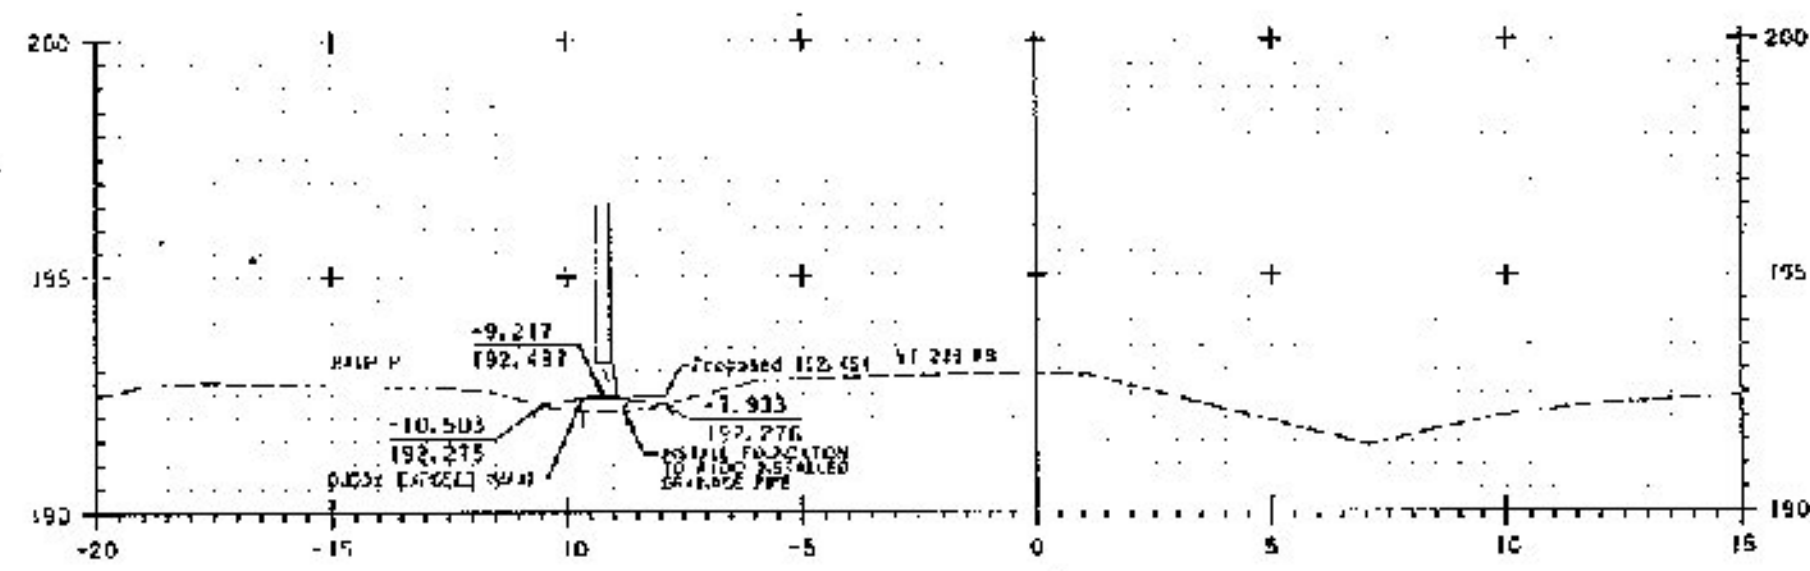

SI-107 (WB 10+708.2)

LIGHT POLE
RECORD PLANS