




WB 10+800.095 = P 1+305.358, 4.8m RT.

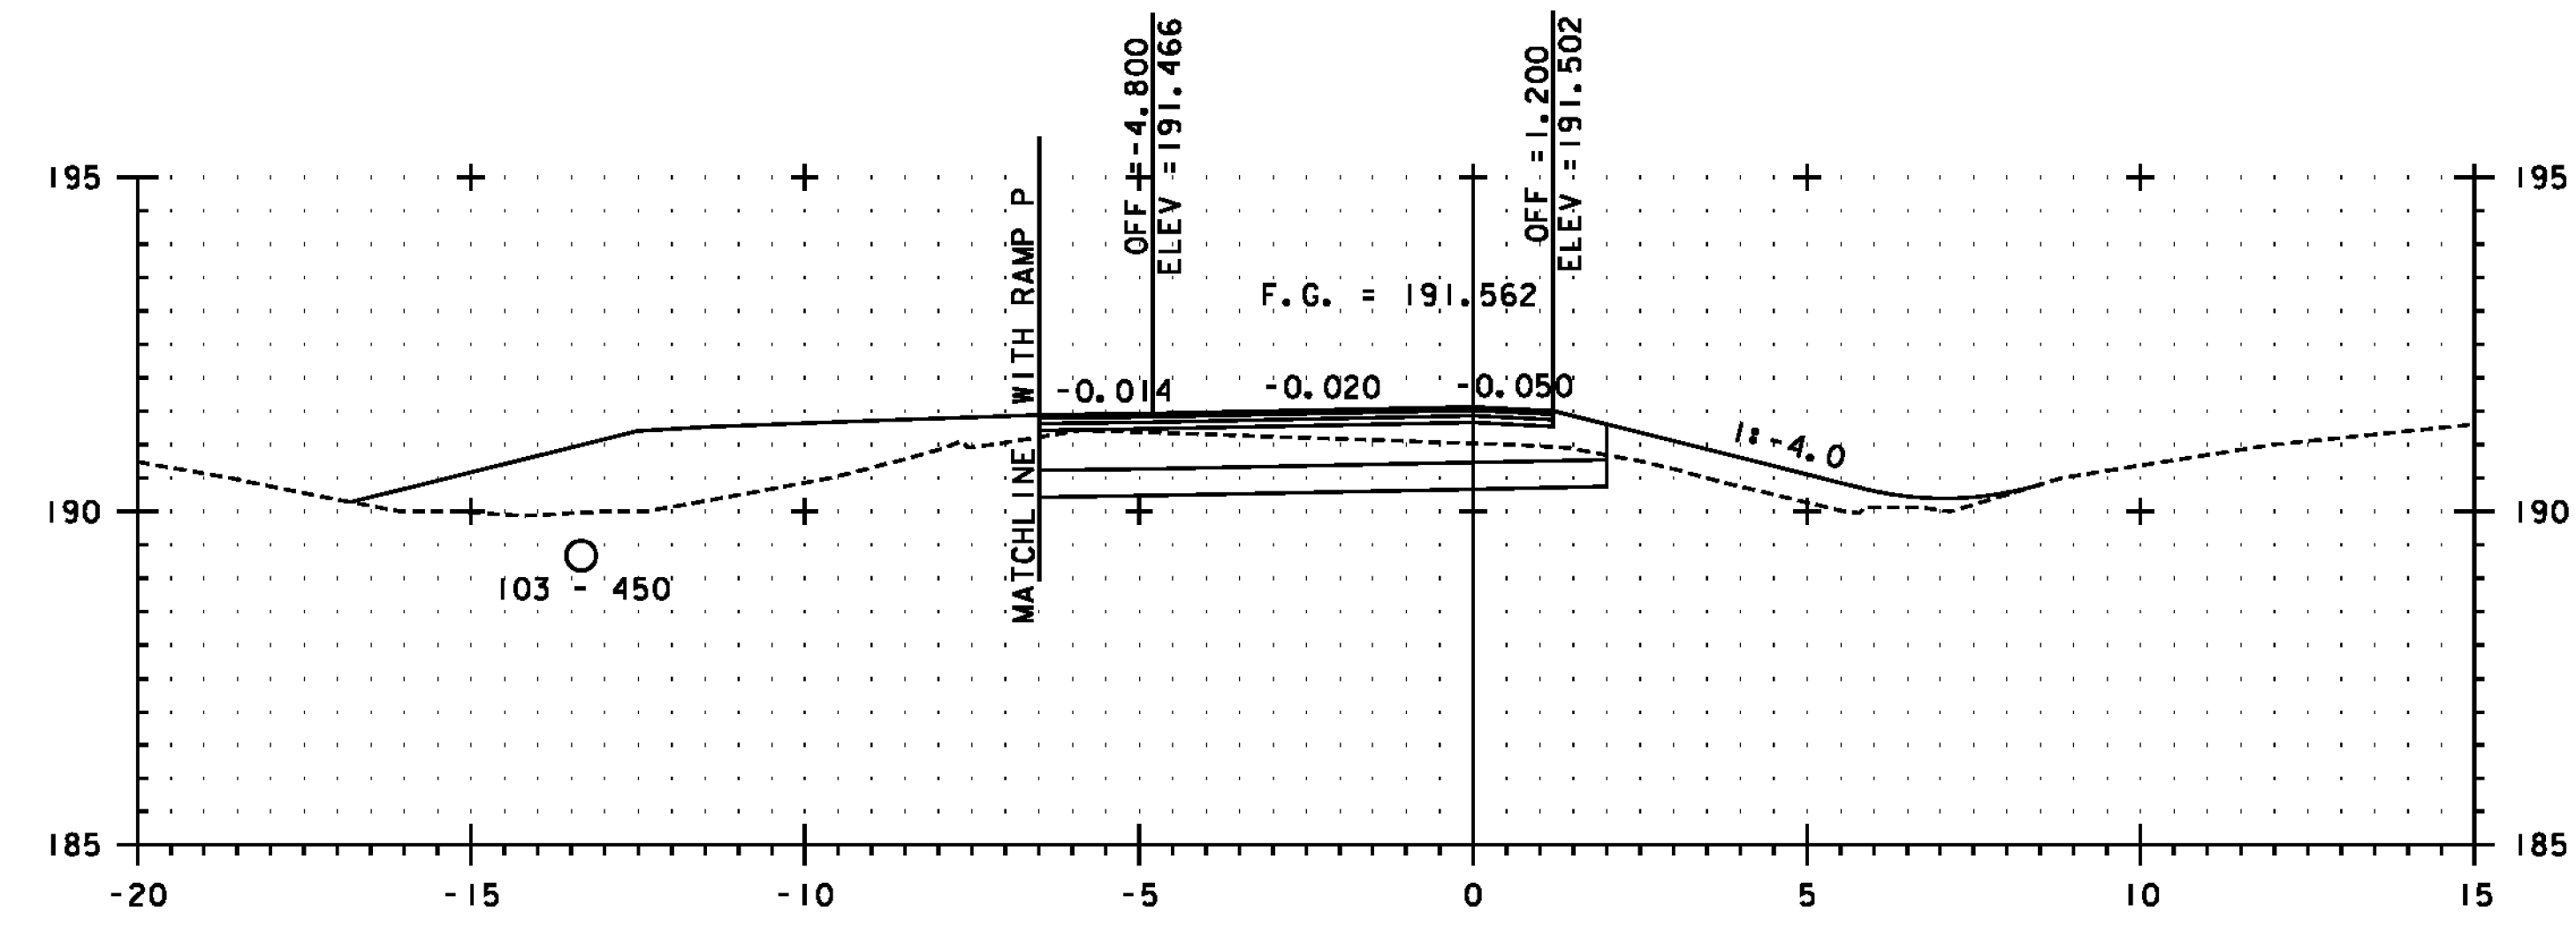


WB 10+760

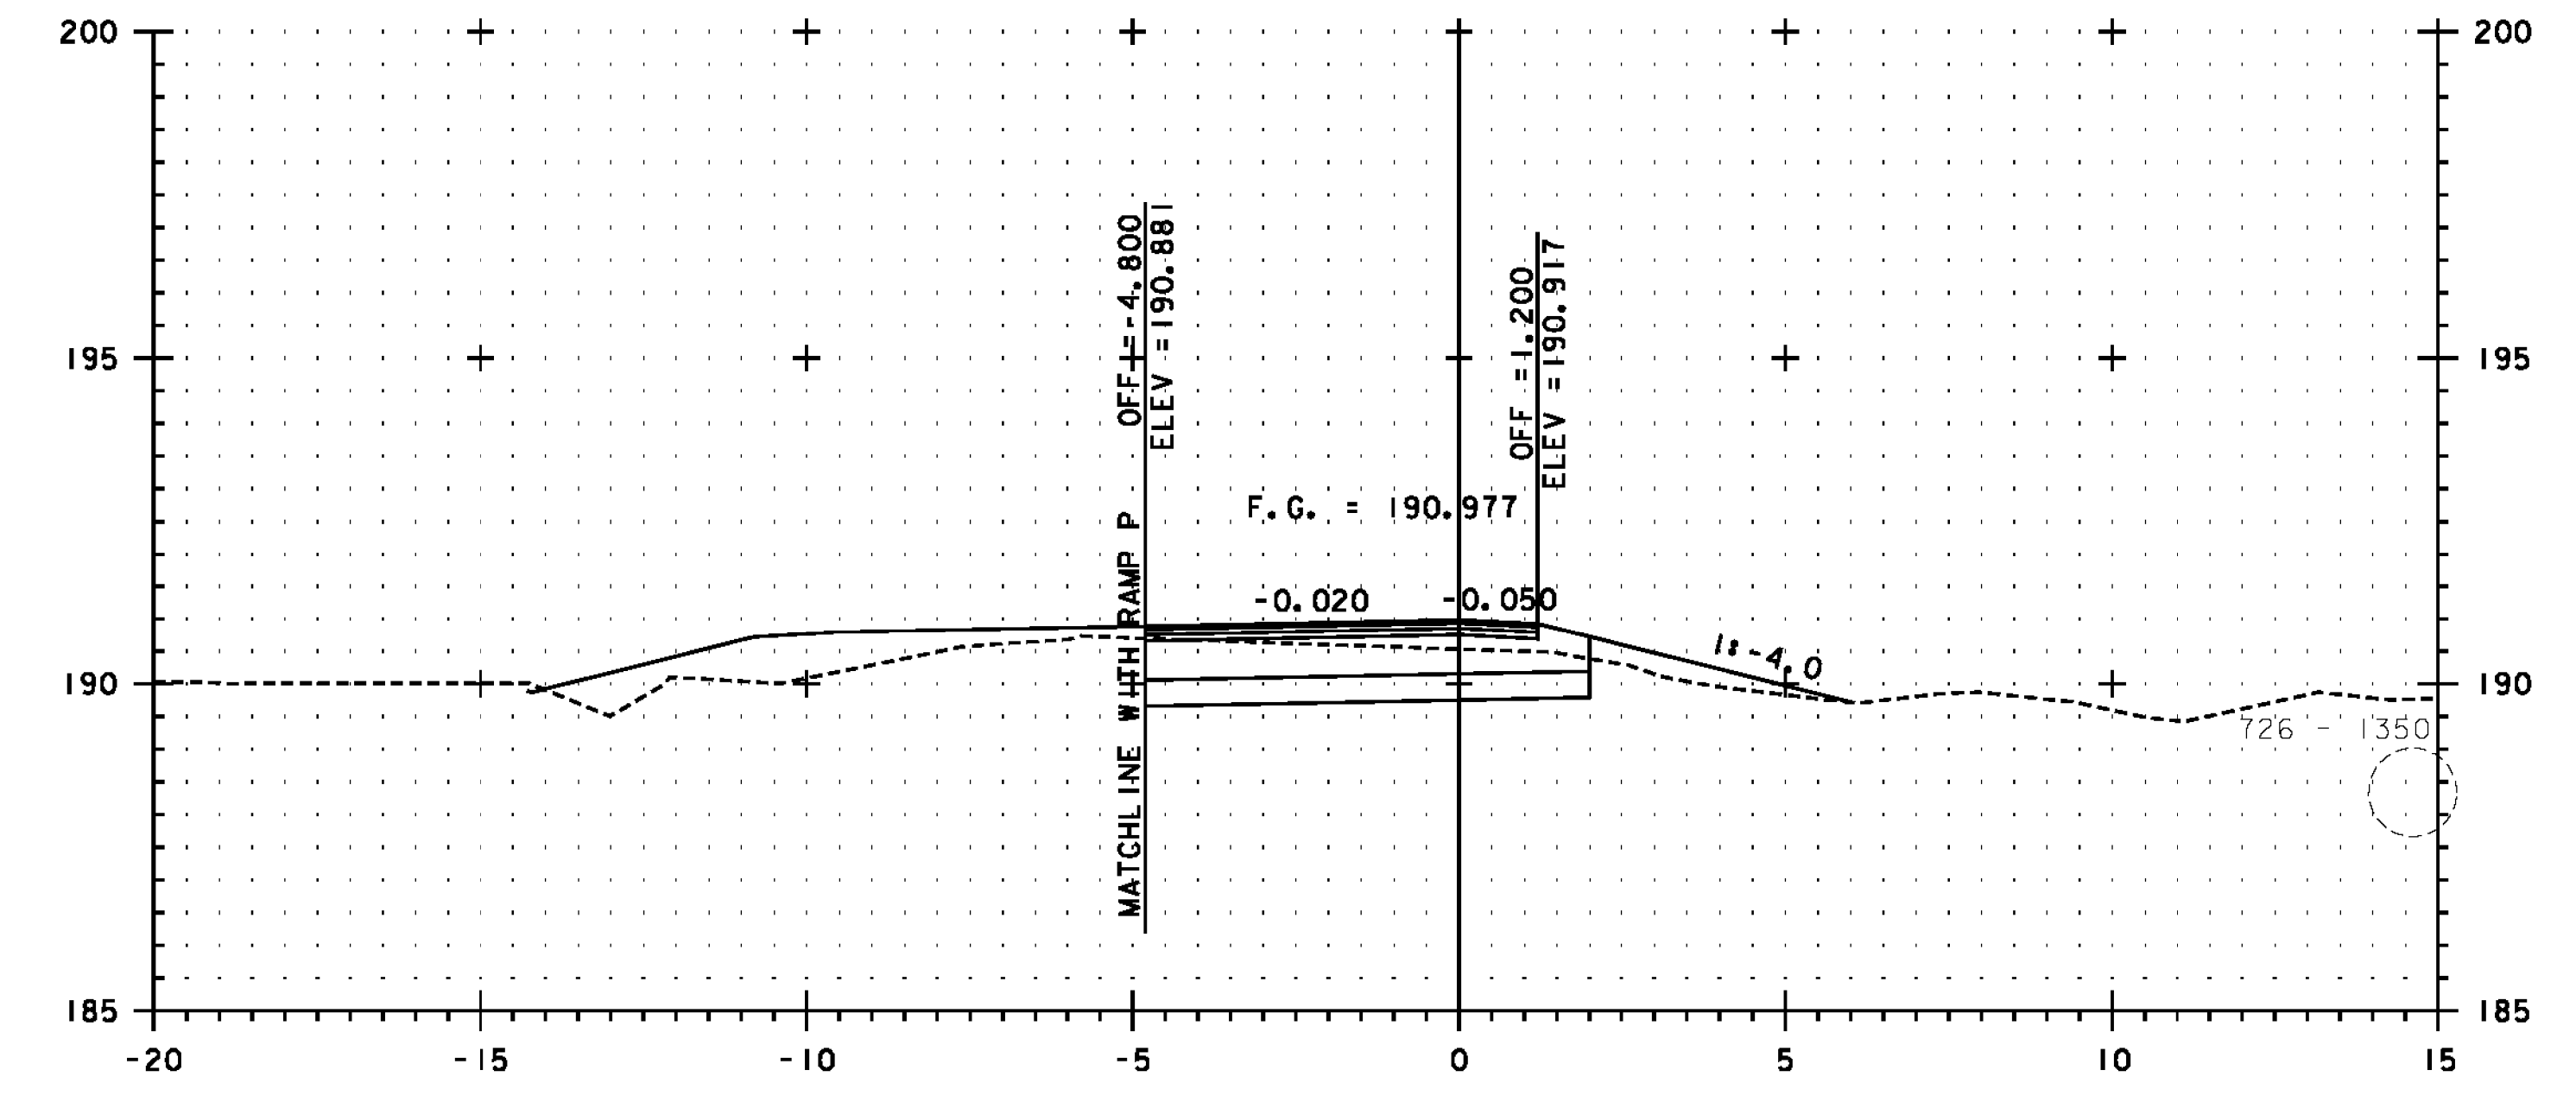

WB 10+800

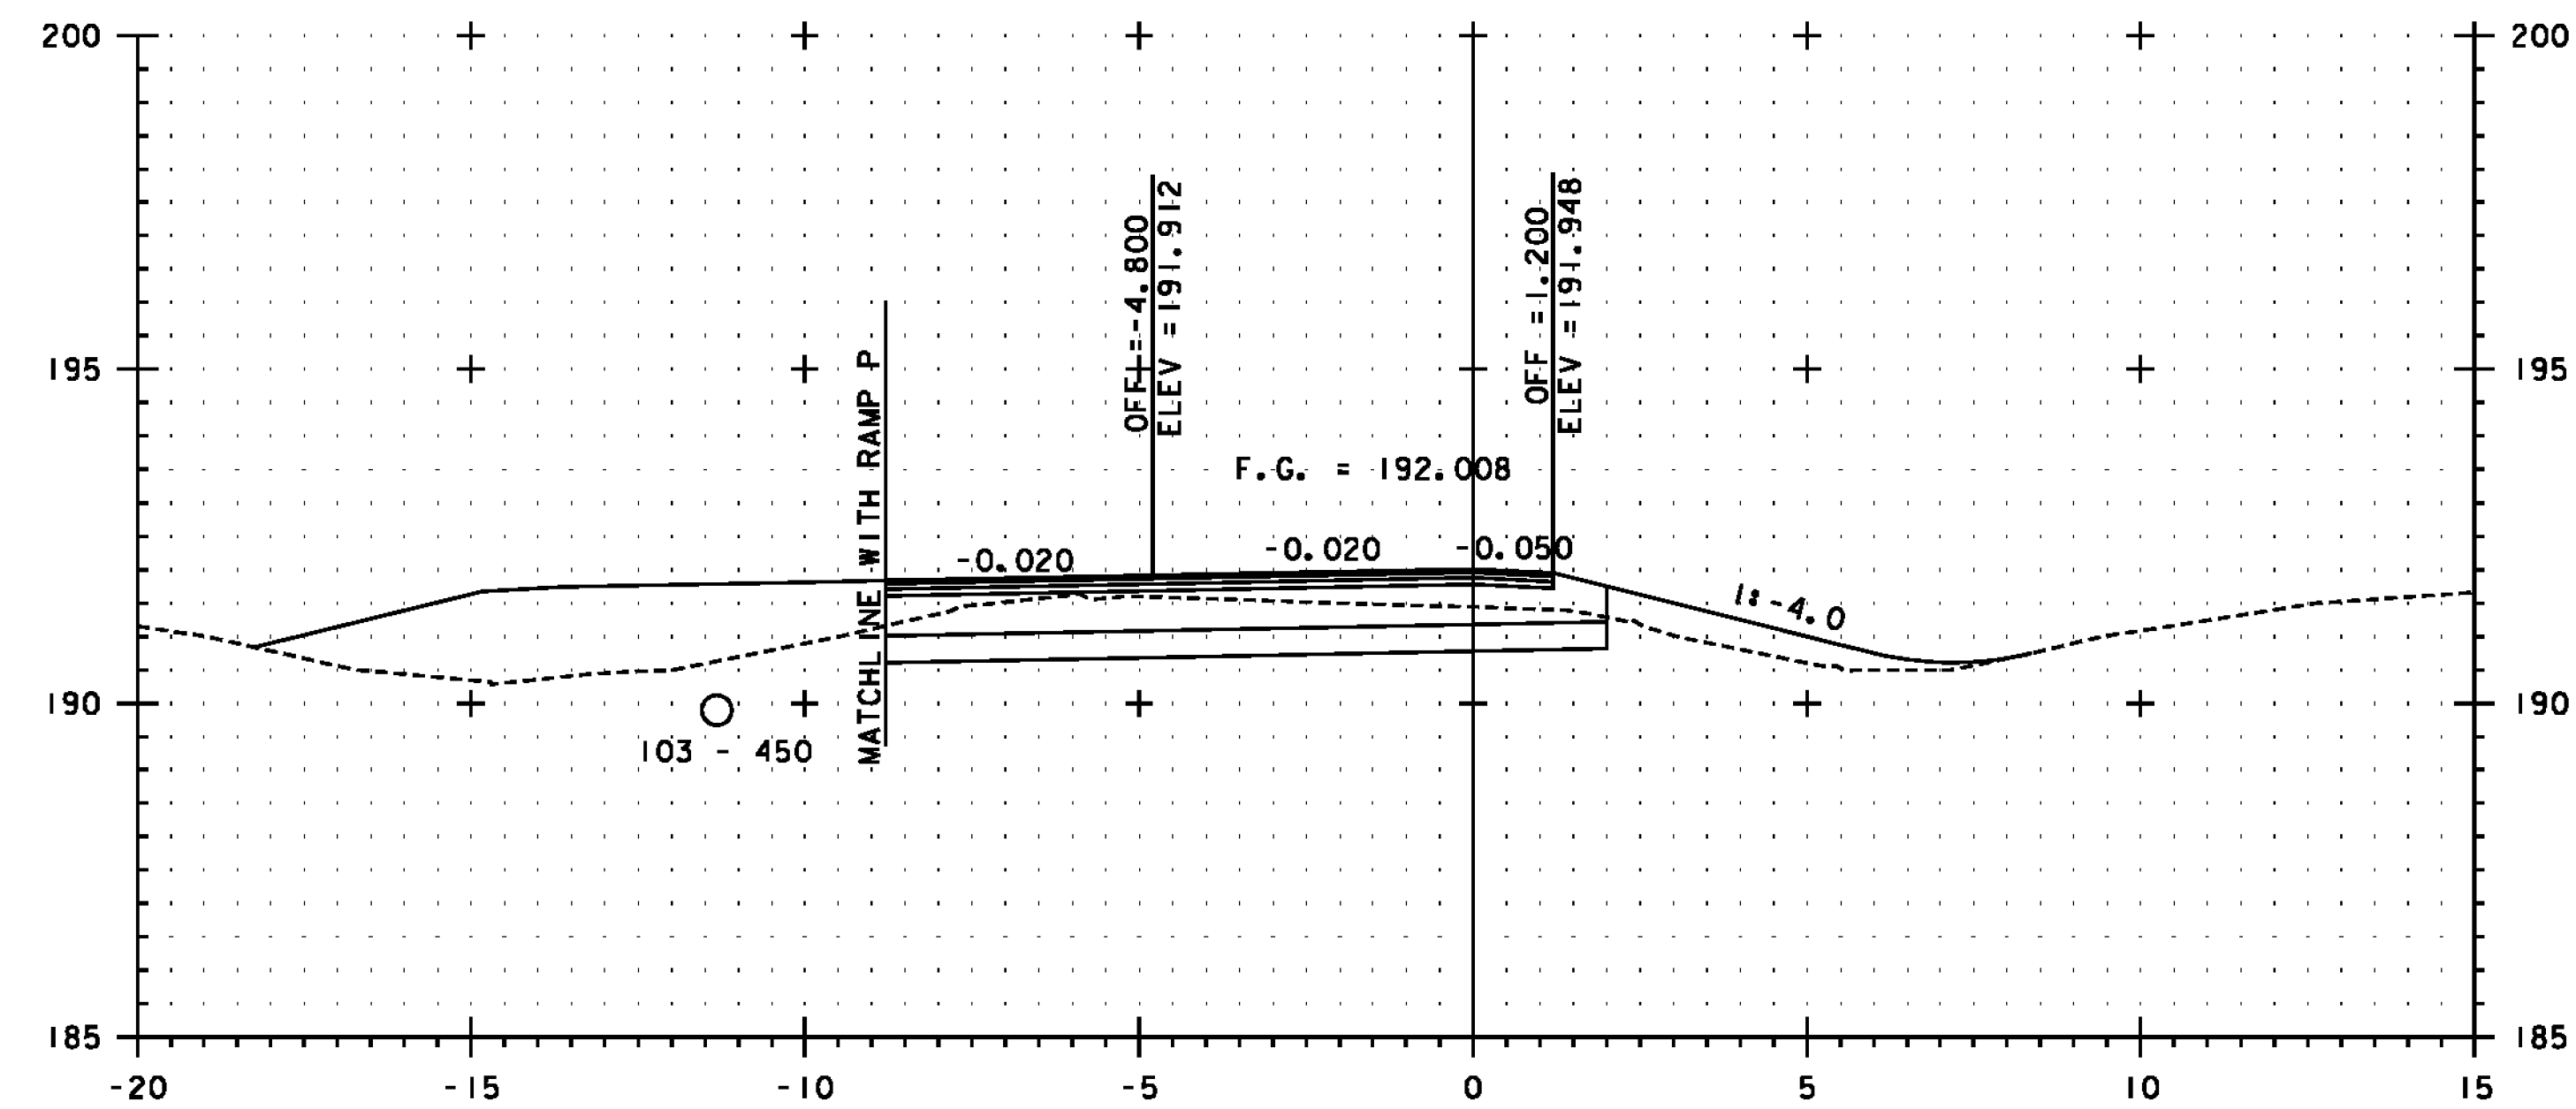


WB 10+740

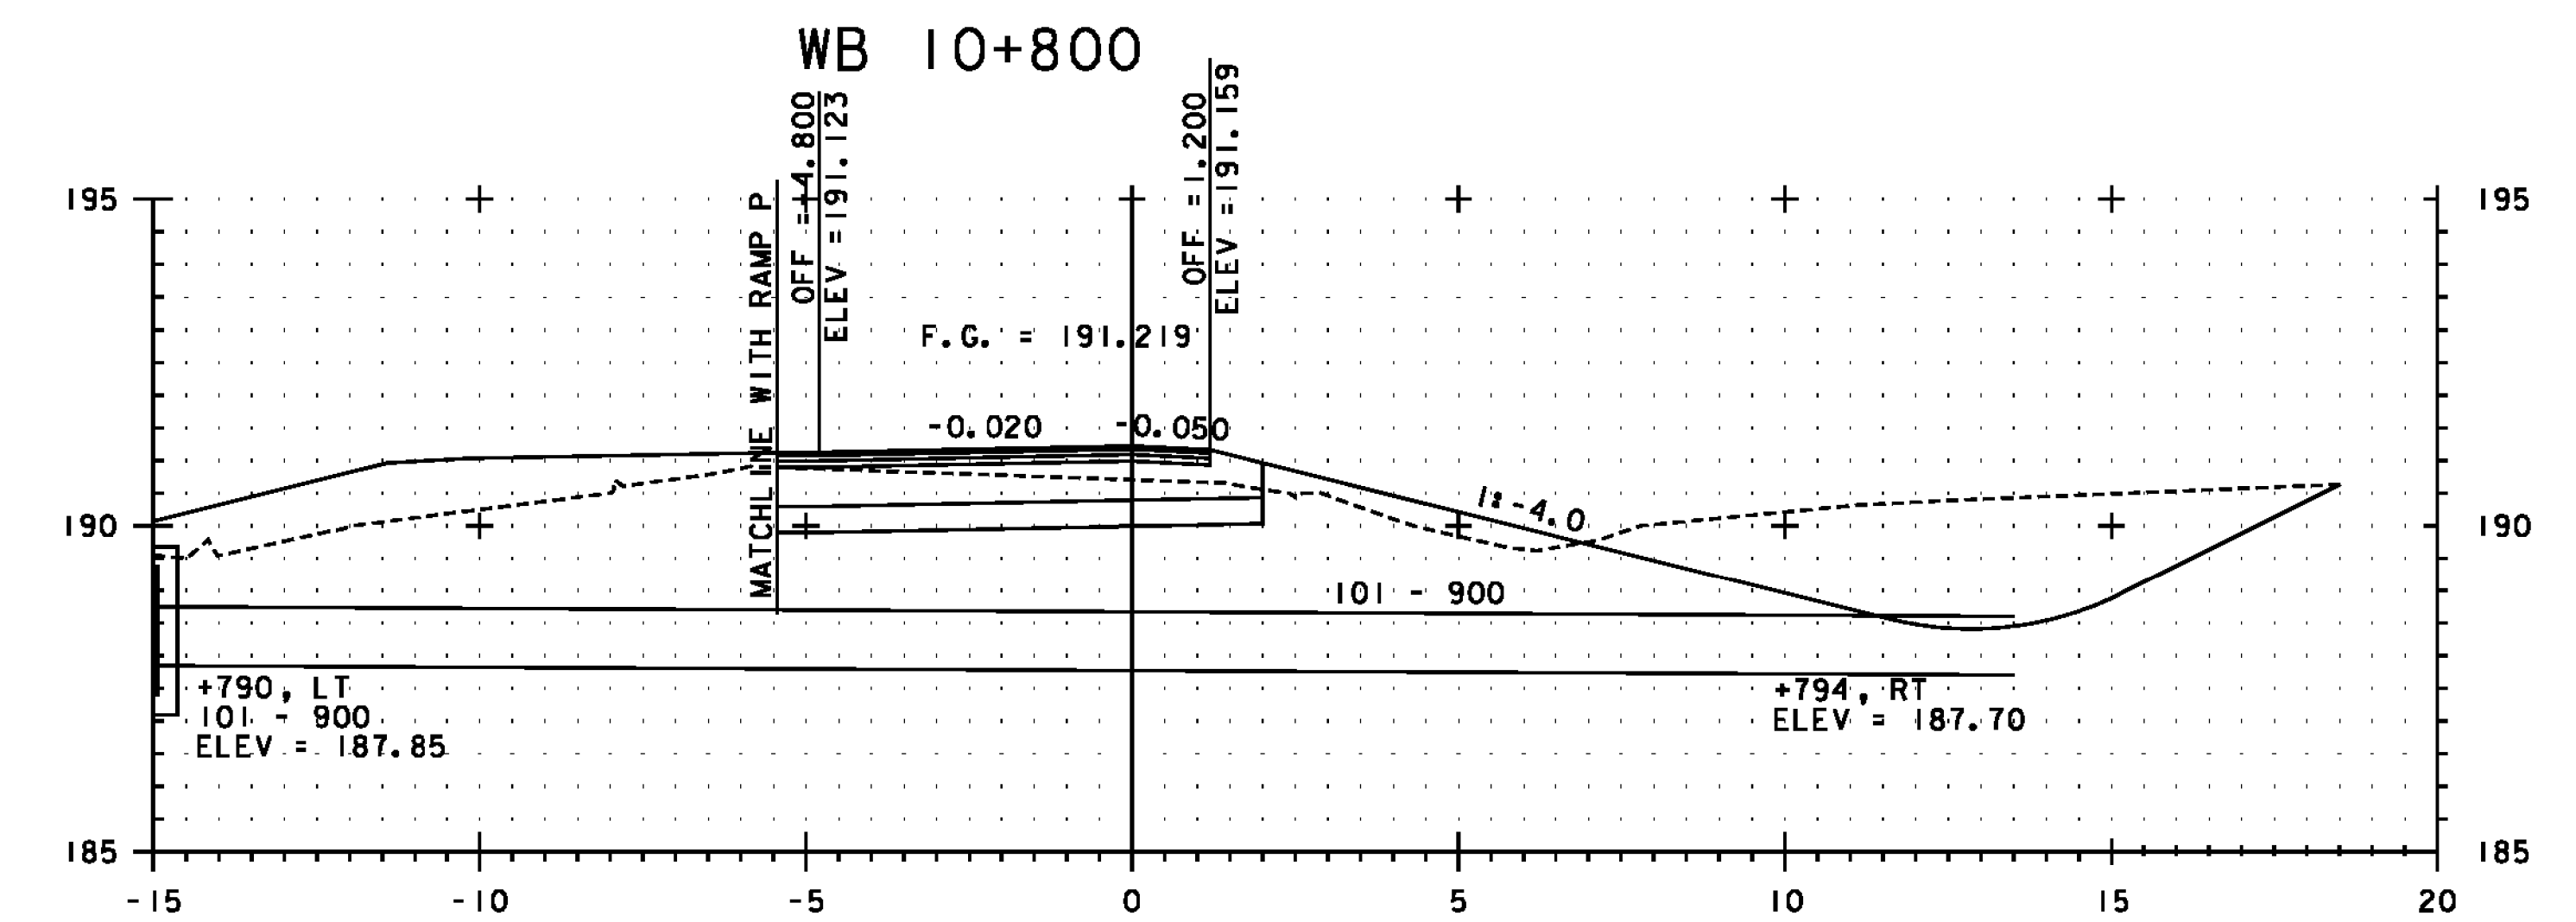

WB 10+780

SEE NOTE ON SHEET 312

SEE REVISED

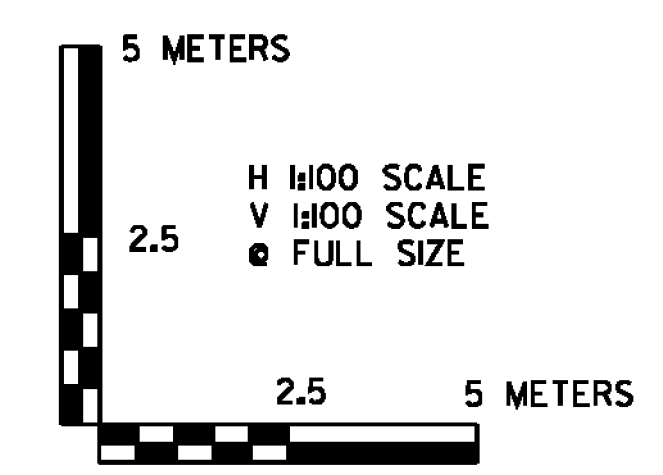

	PROJECT NAME: BENNINGTON
	PROJECT NUMBER: NH 019-(154)
	FILE NAME: ...plot_files\zd307c4xs.279WB.ptf PLOT DATE: 3/16/2010
	DESIGN SUPERVISOR: GREG EDWARDS DRAWN BY: STANTEC
DESIGNED BY: MARC FOISY CHECKED BY: GARY SANTY	
VT 279 WB CROSS SECTION WBX-25	SHEET 336 OF 468

3/16/2010 11:52:28 AM v:\1953\getlive\19530002\tr\anspor\101\10\dr\cwg\ng\con\tr\csp\4\plot_files\zd307c4xs.279WB.ptf