




SL-108 (WB 10+777.5)

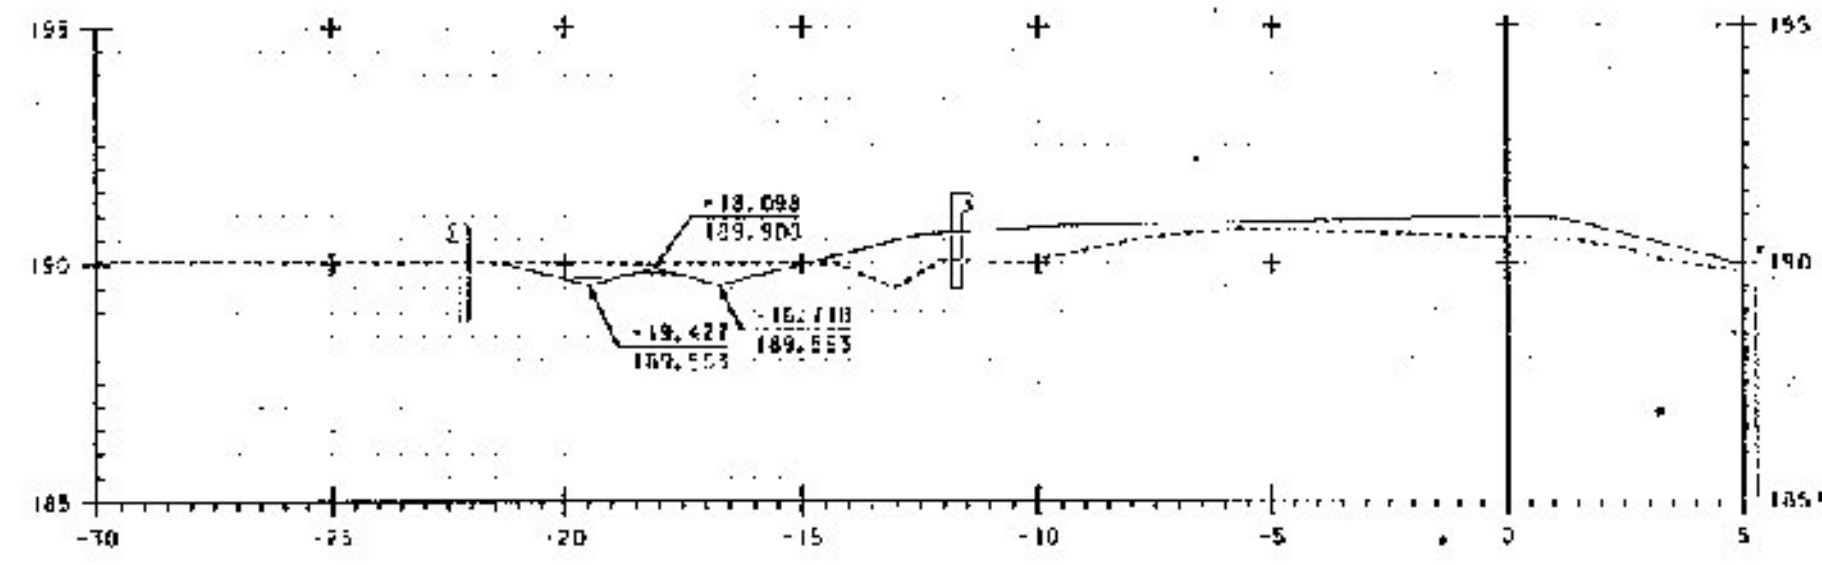


WB 10+800

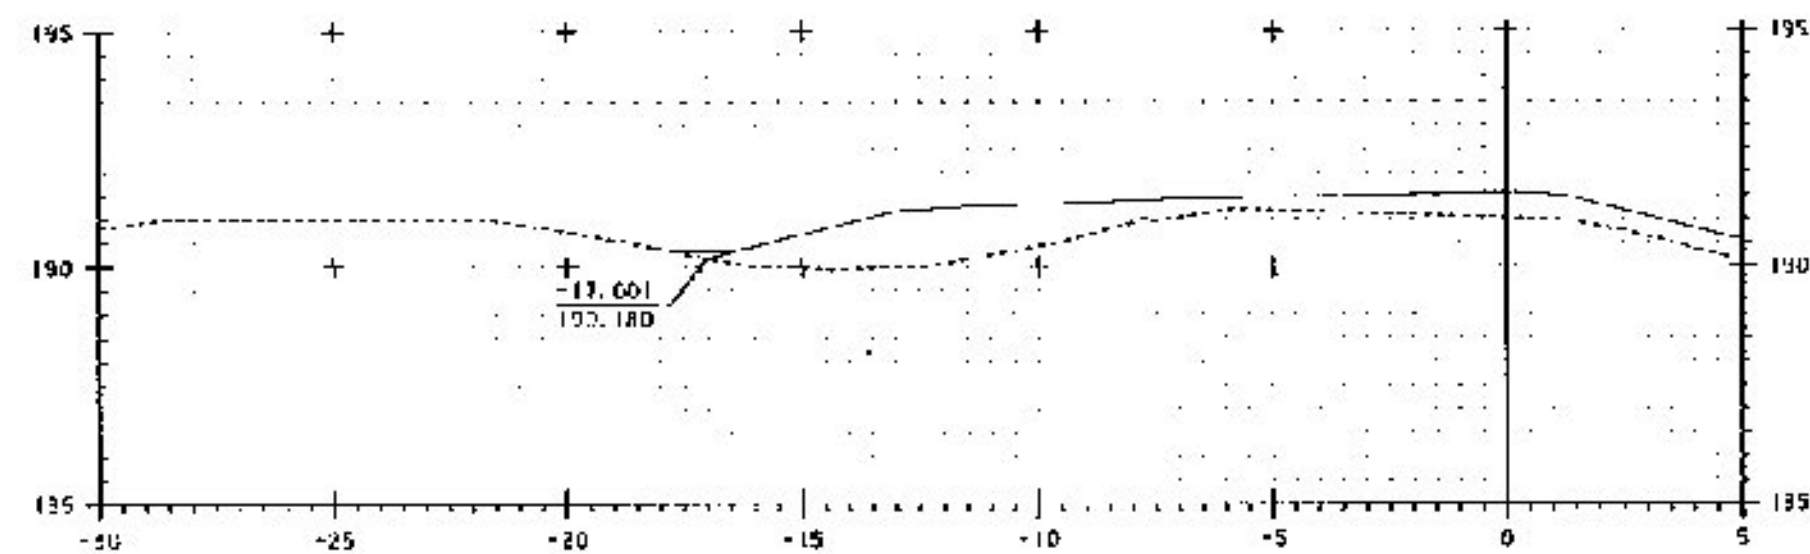

WB 10+760

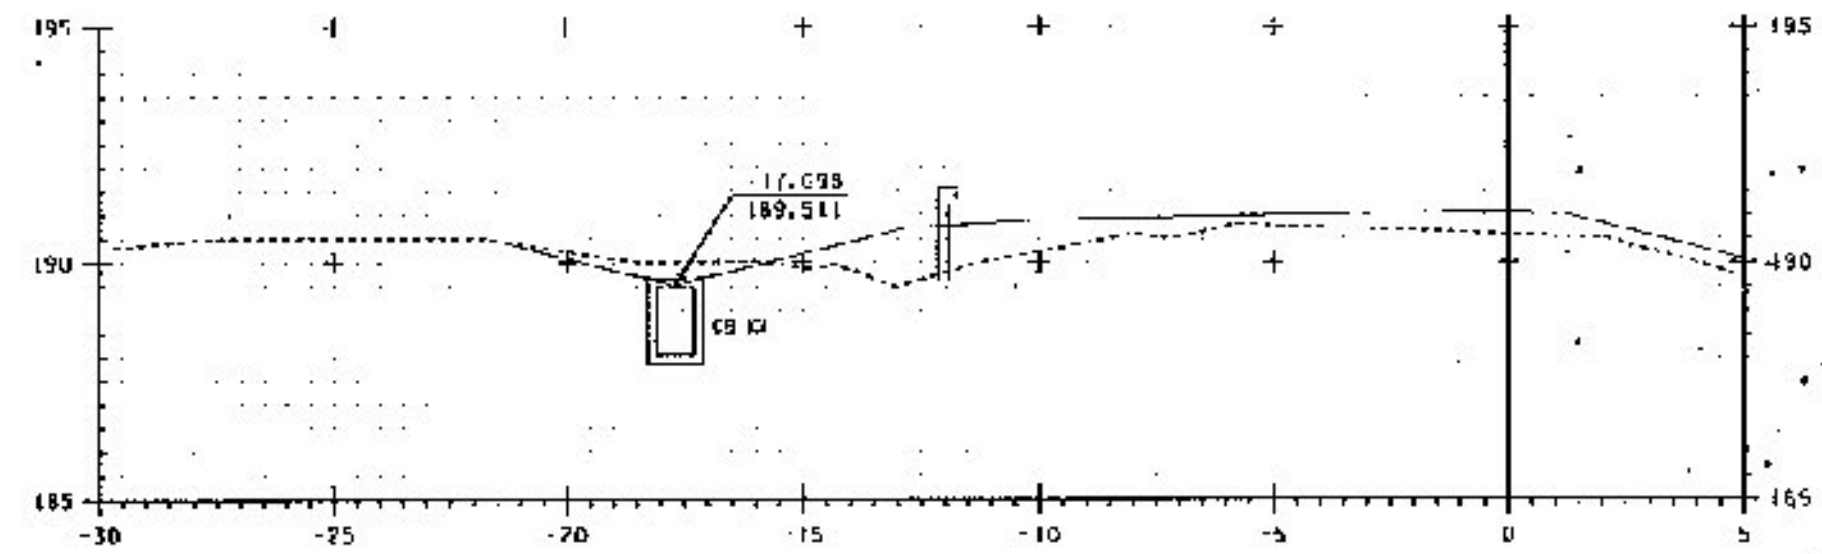


WB 10+790

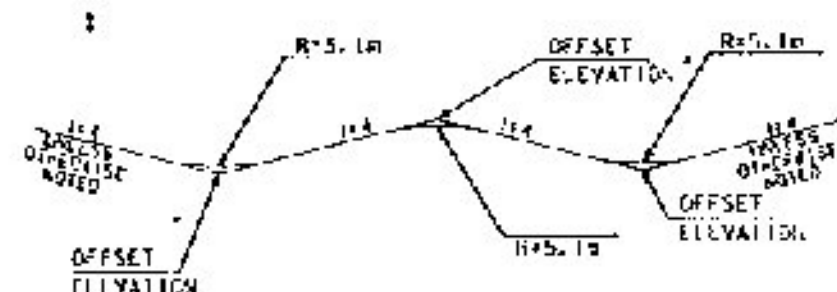

**MEDIAN BERM TYPICAL SECTION**

NOTE:  
ELEVATIONS SHOWN DO NOT TAKE INTO ACCOUNT  
THE 5.0m BERM OF THE TYPICAL SECTION.

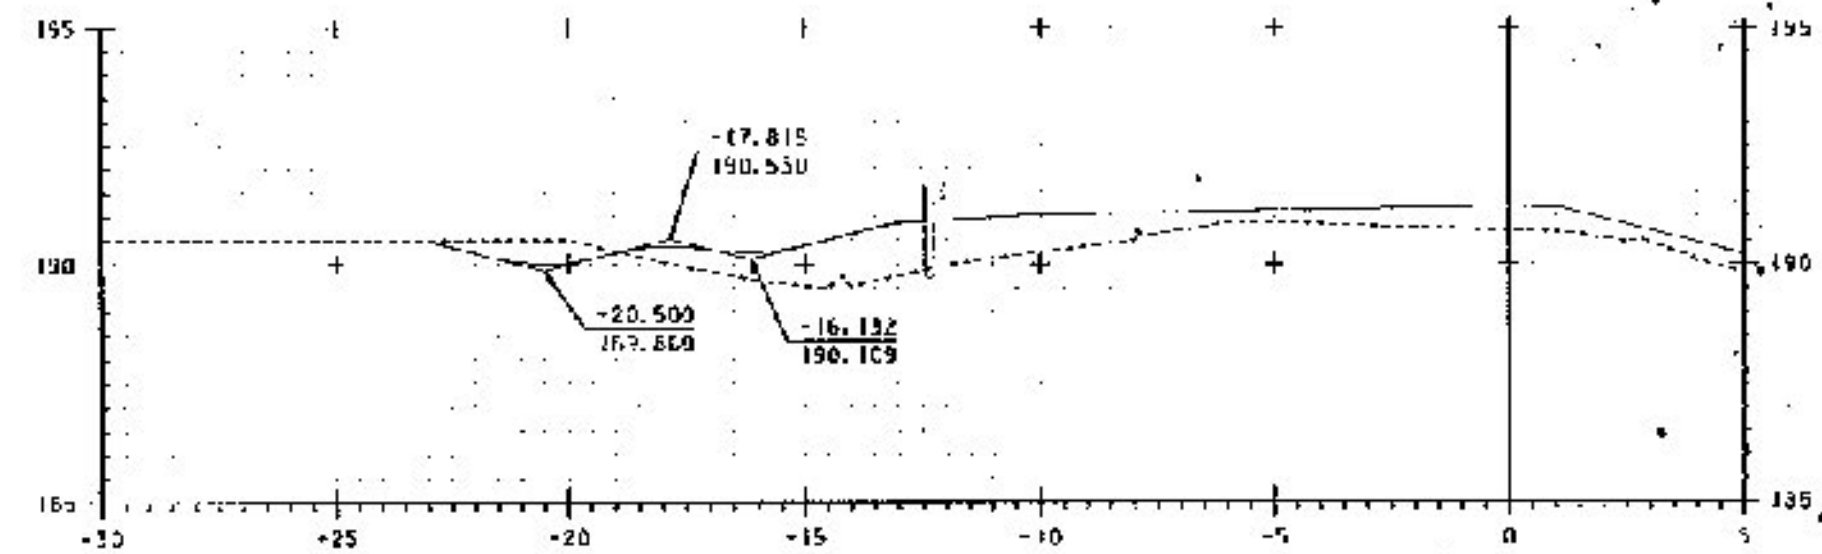

WB 10+780

LIGHT ROLL  
RECORD PLANS