



WB 10+840

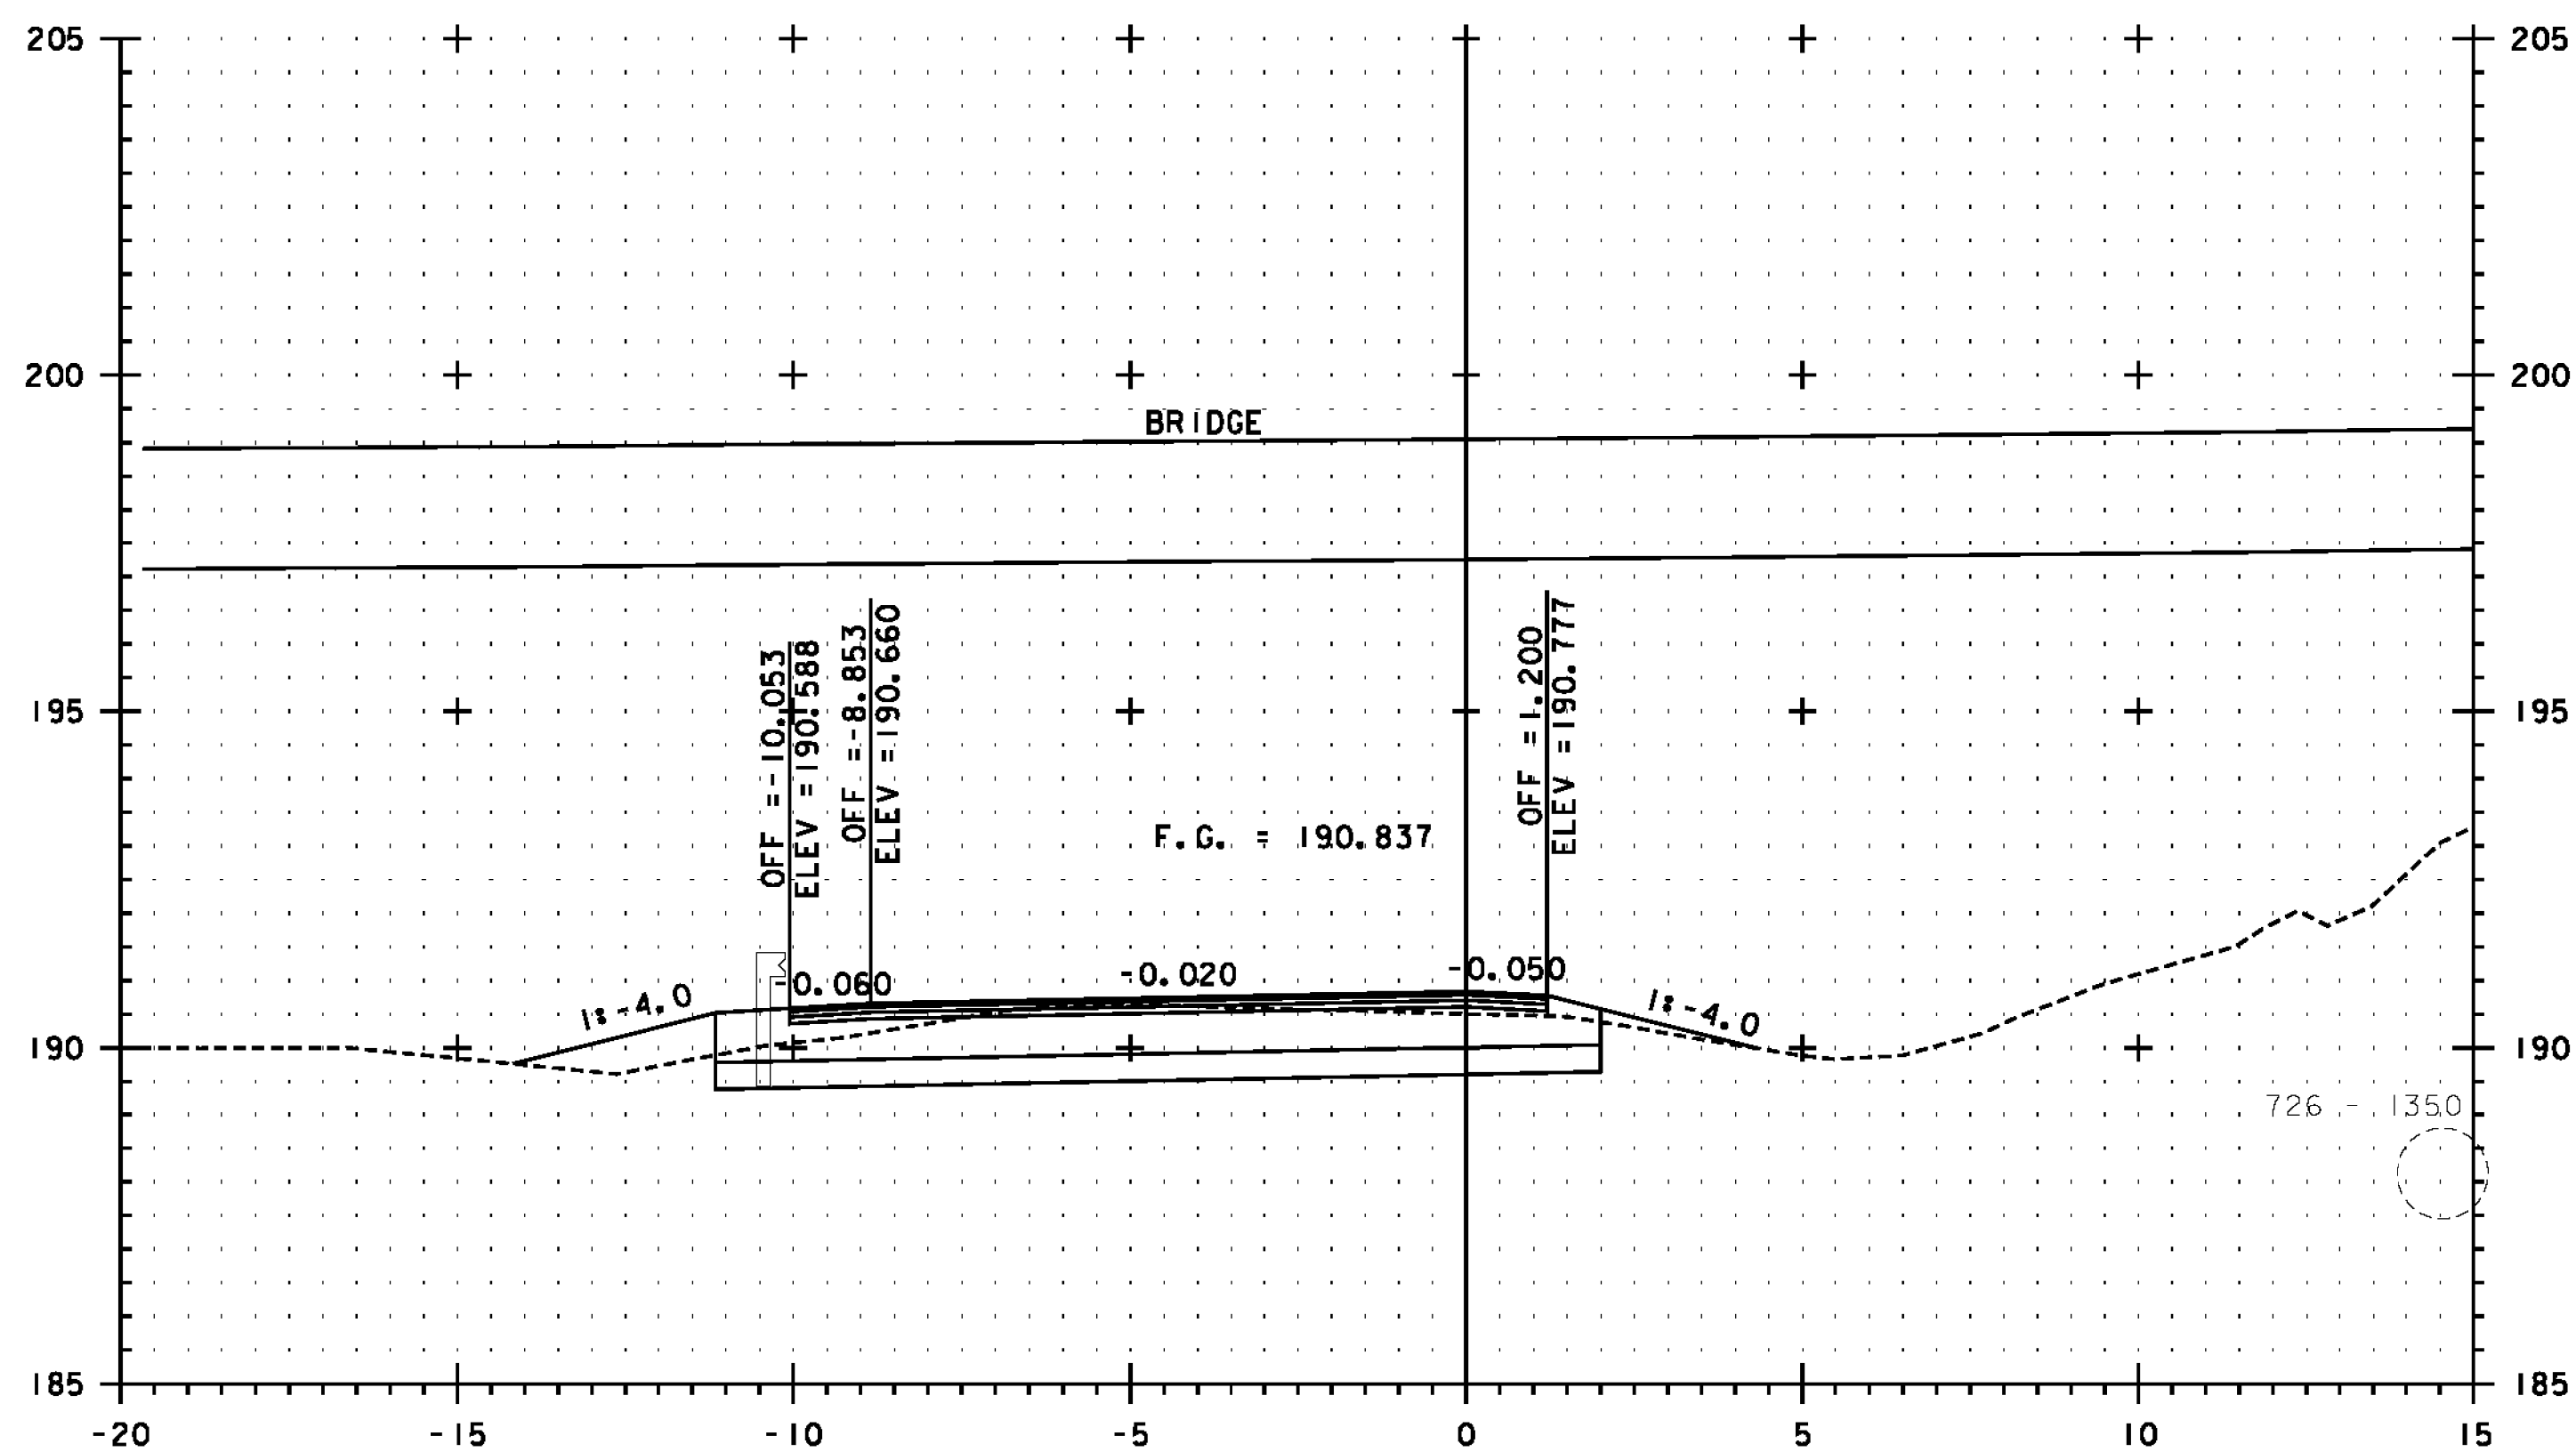


WB 10+820

WB 10+811.456 = G 1+958.387


SEE NOTE ON SHEET 312

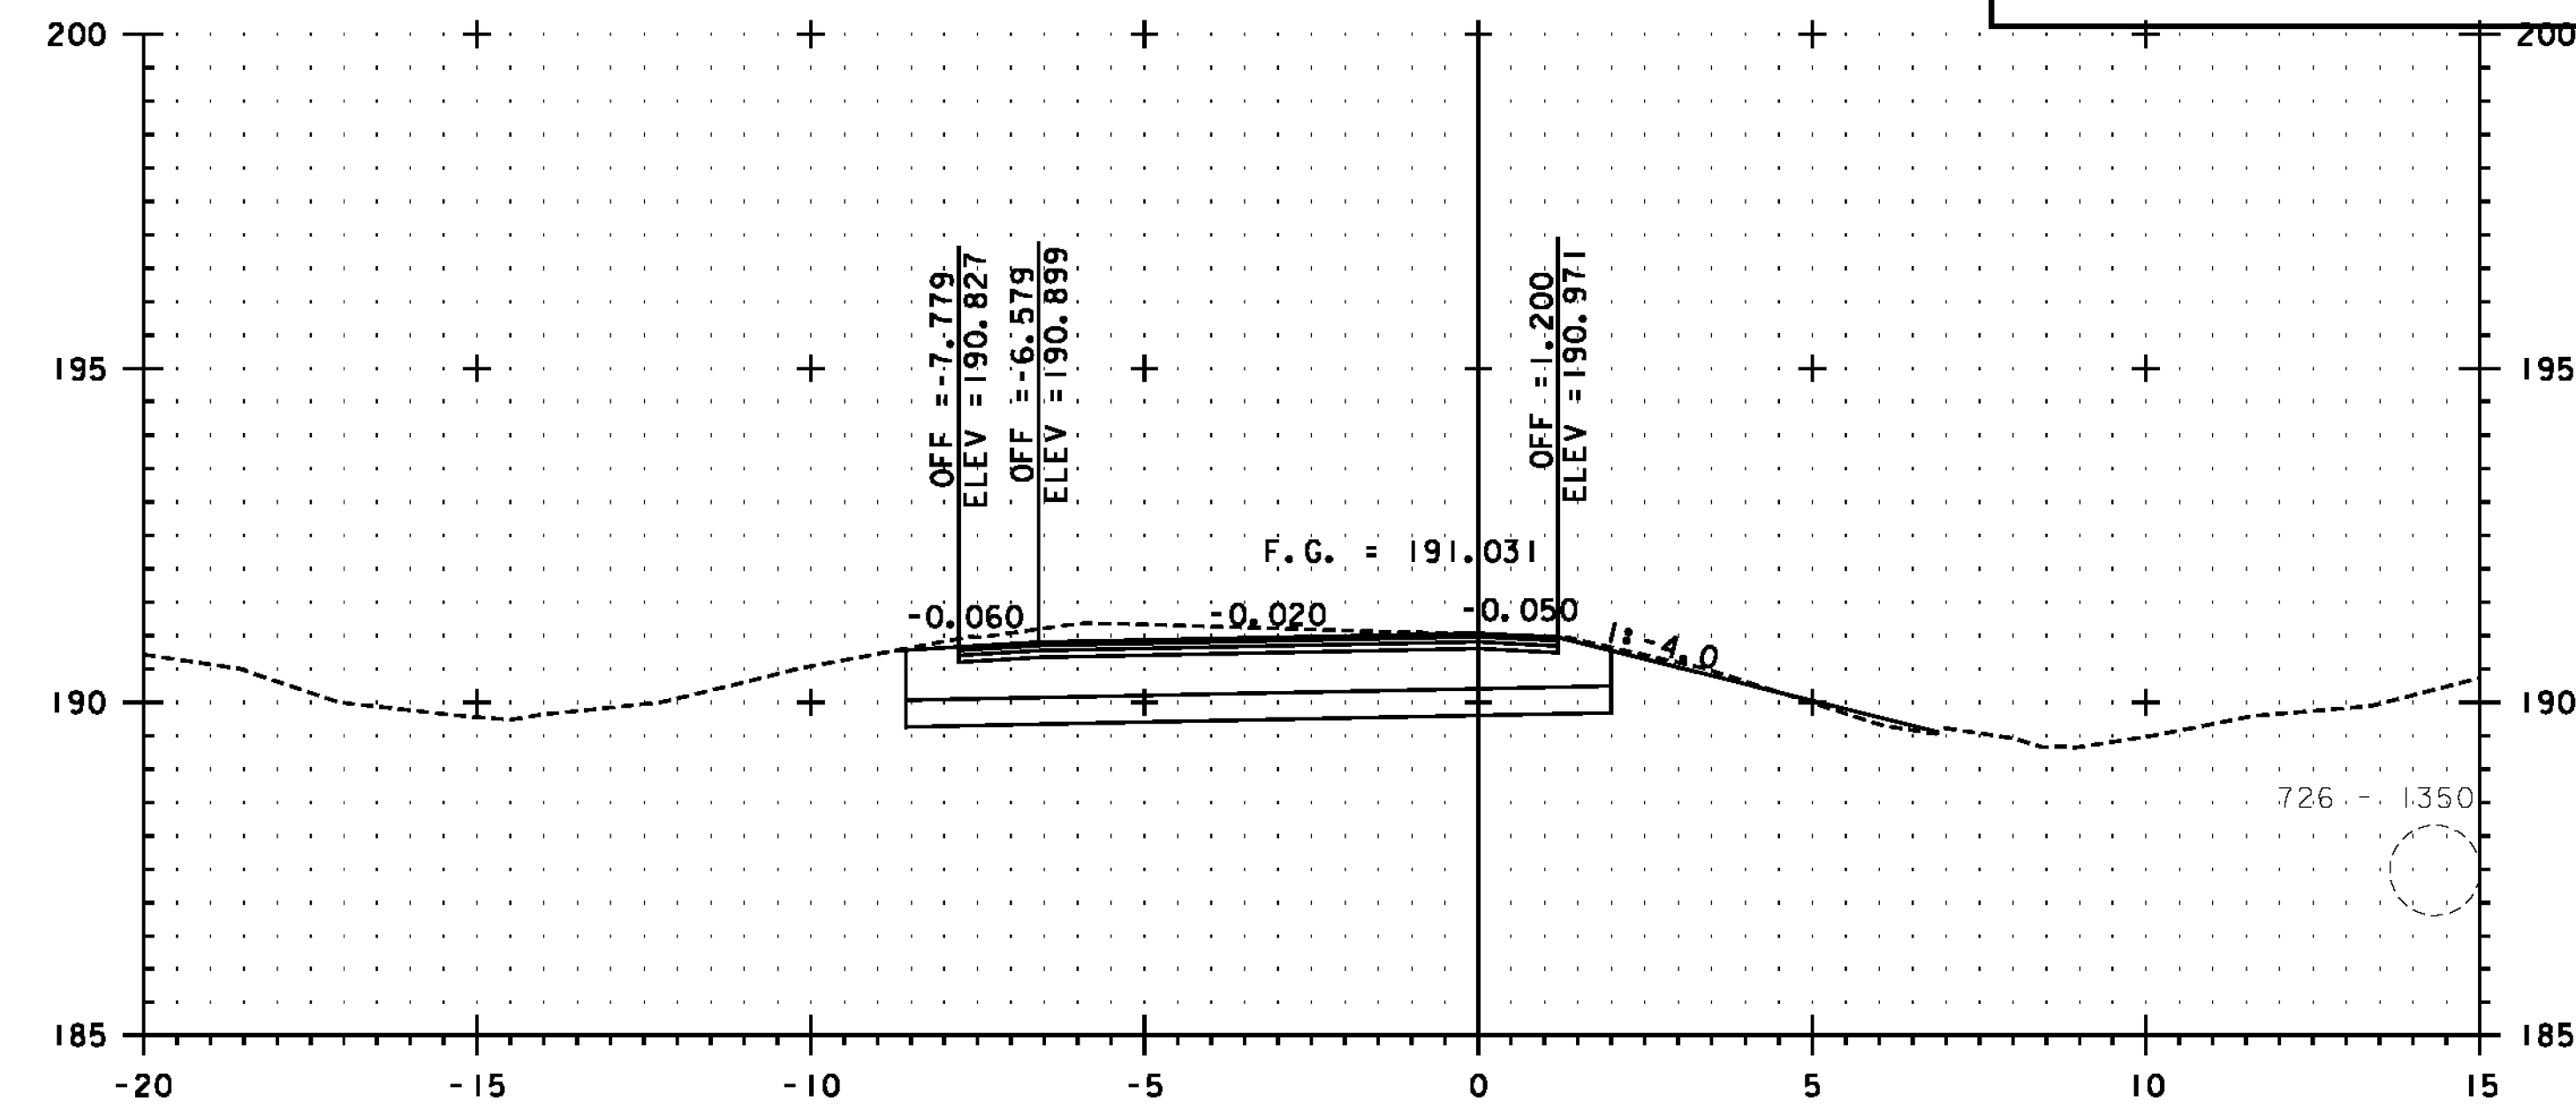

WB 10+880

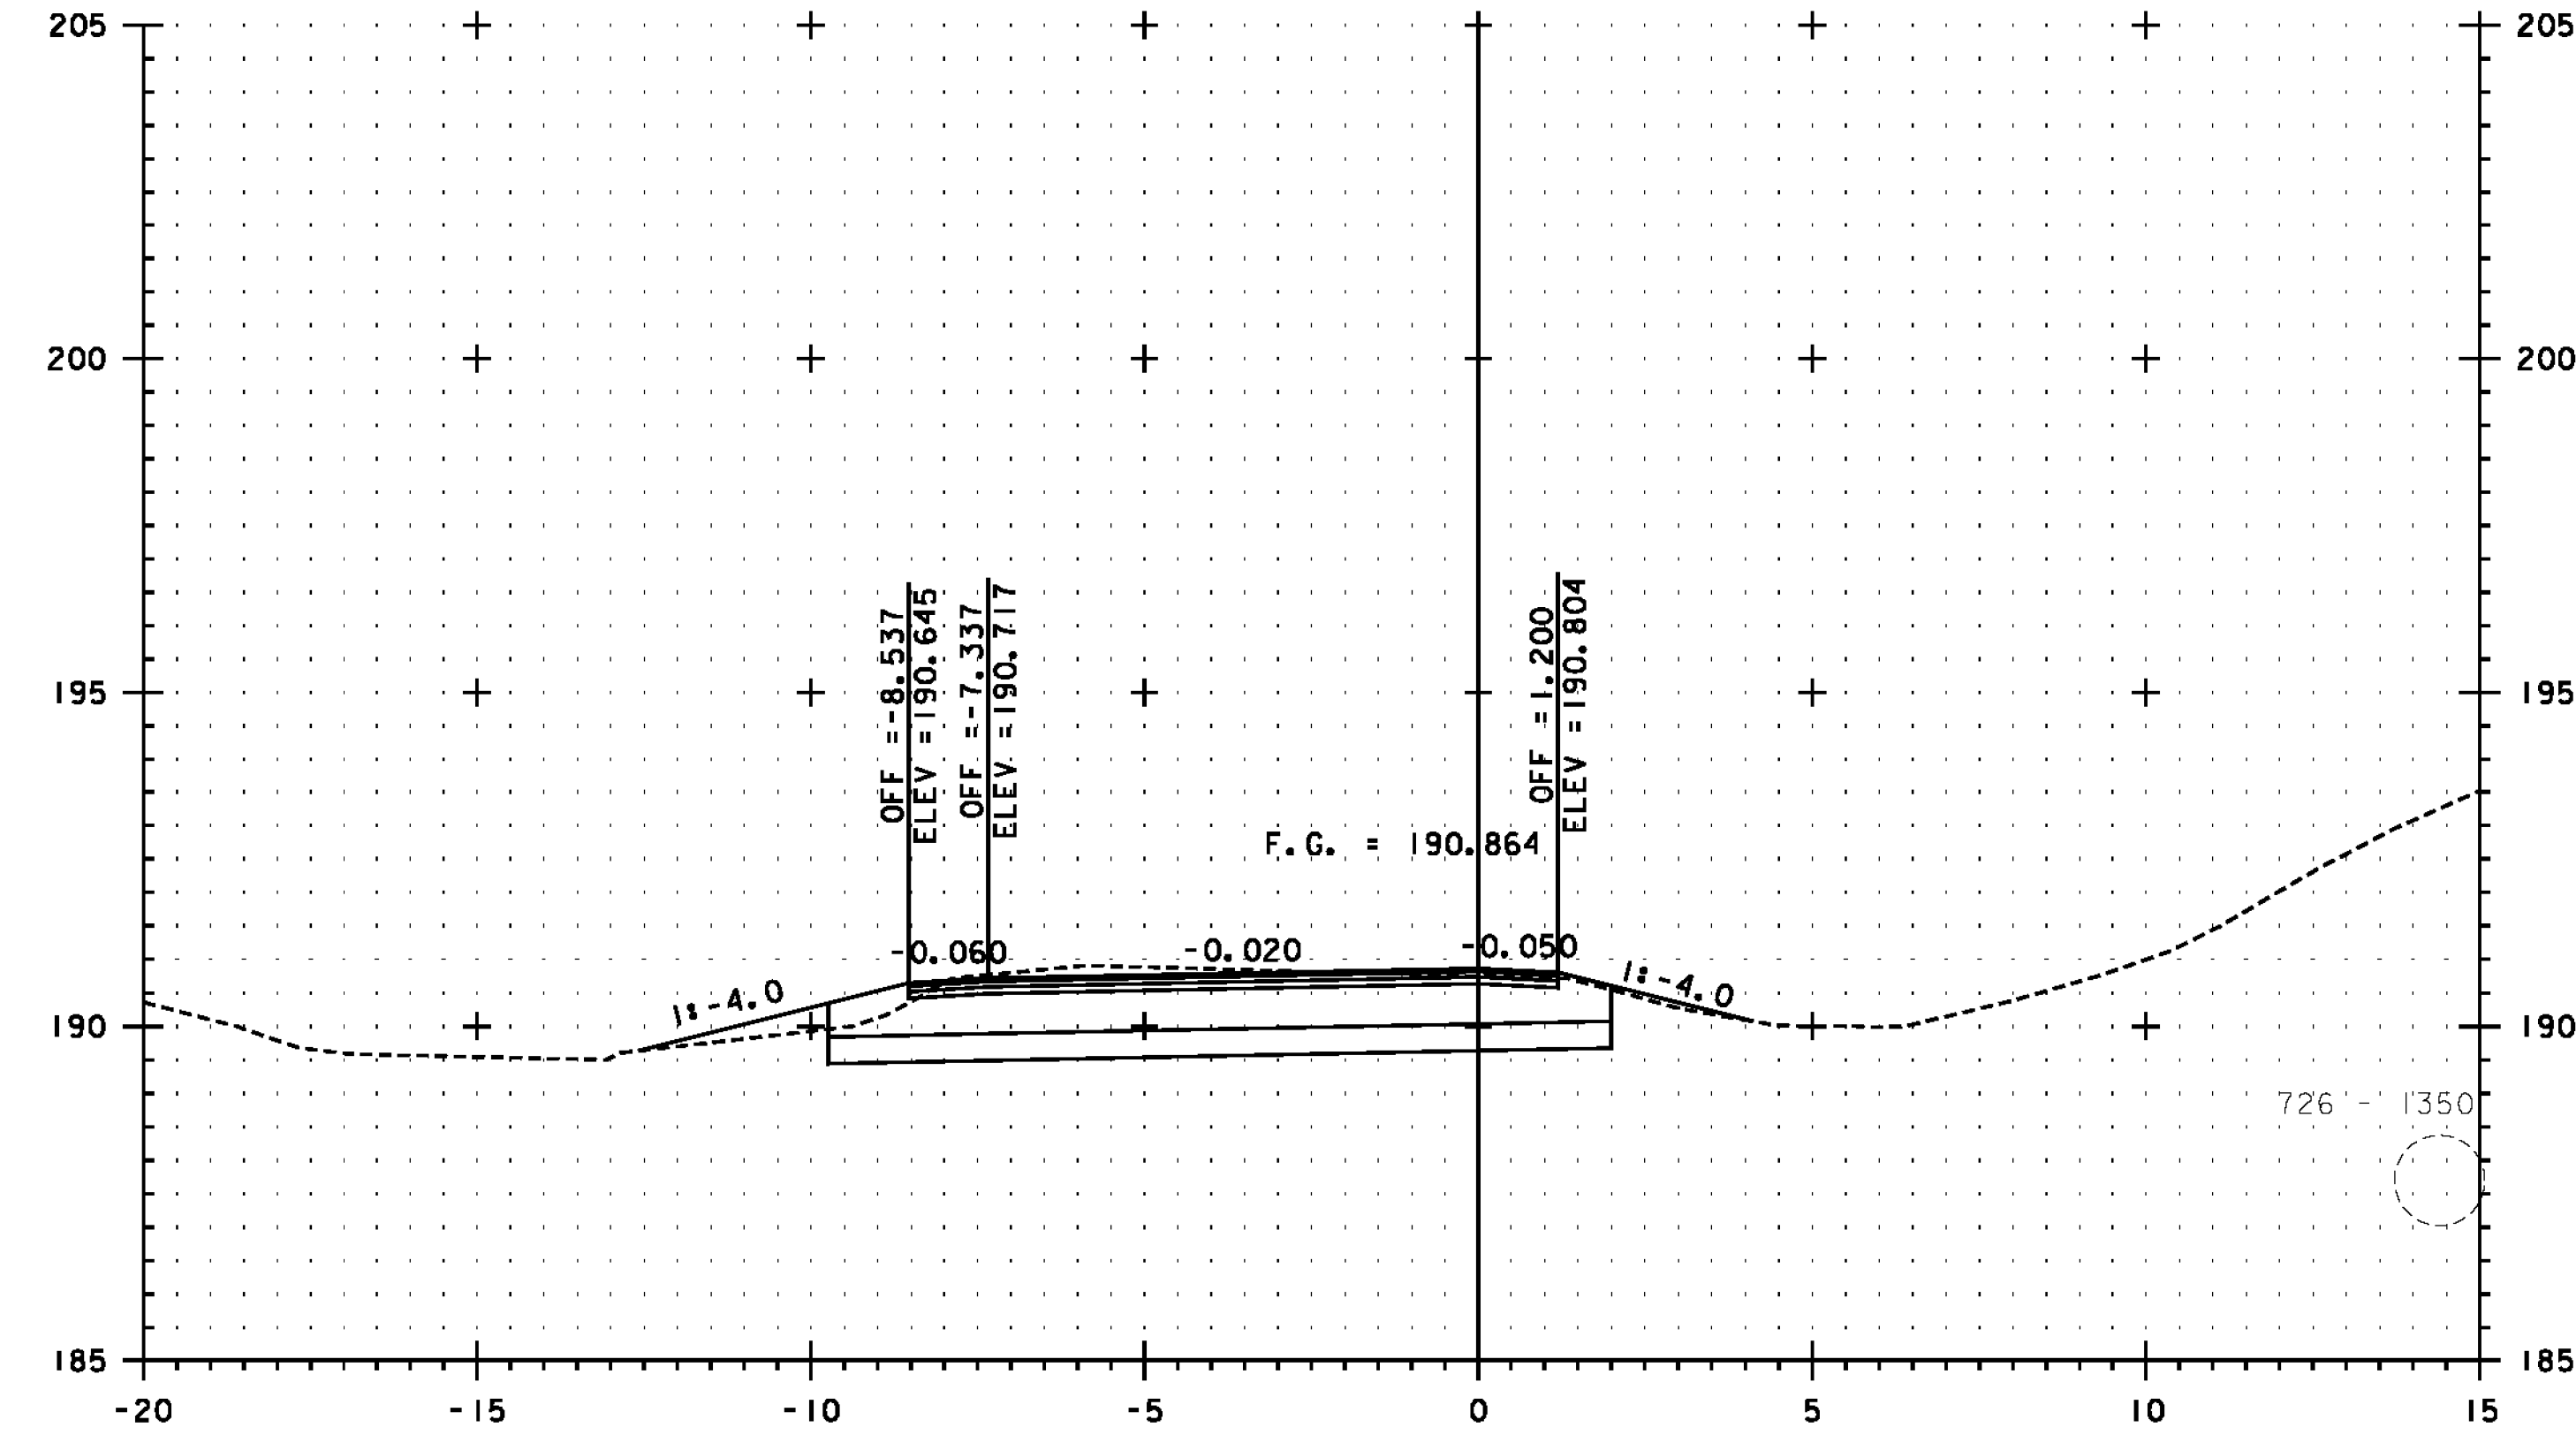

WB 10+860

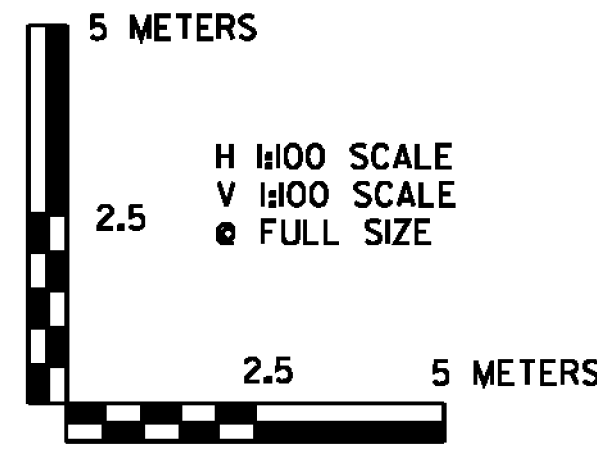

SEE REVISED

PROJECT NAME:	BENNINGTON
PROJECT NUMBER:	NH 019-(154)
FILE NAME:	...plot_files\zd307c4xs.279WB.ptf
DESIGN SUPERVISOR:	GREG EDWARDS
DESIGNED BY:	MARC FOISY
VT 279 WB CROSS SECTION	WBX-26
PLOT DATE:	1/26/2010
DRAWN BY:	STANTEC
CHECKED BY:	GARY SANTY
SHEET	337 OF 468

1/26/2010 4:56:20 PM v:\1953\get\live\1953\0002A\tr\anspor\ref\10n\dr\cm\ng\com\tr\cst_4\p101 - files\z307c4xs.279WB.ptf