




WB 11+020

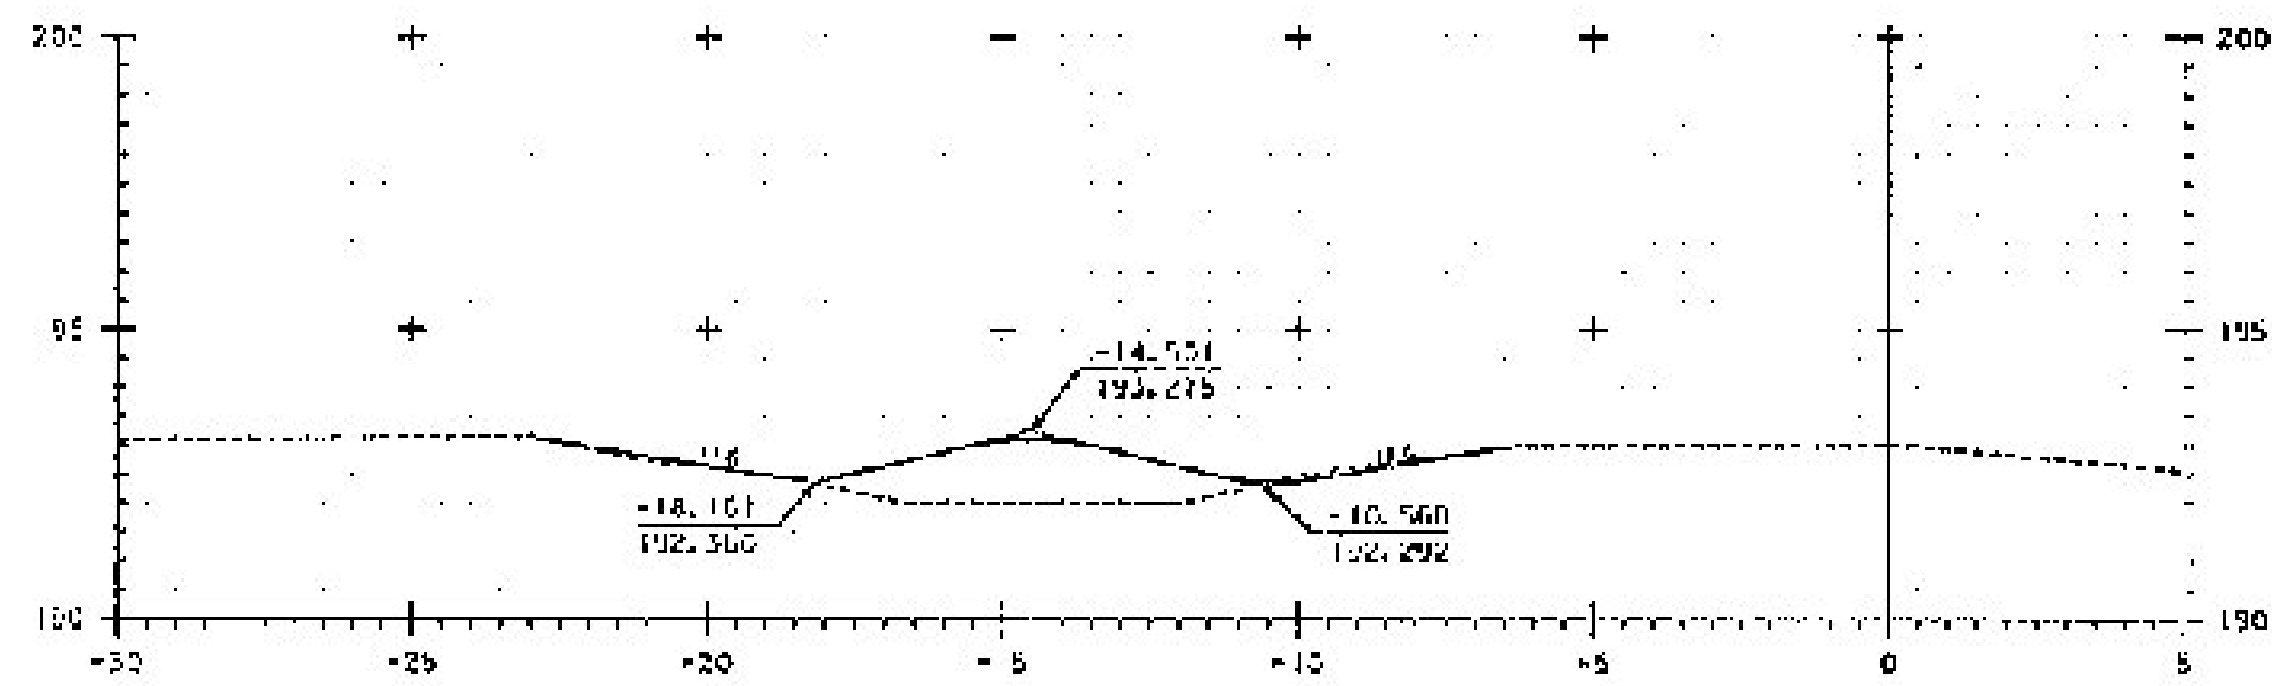

WB 11+000

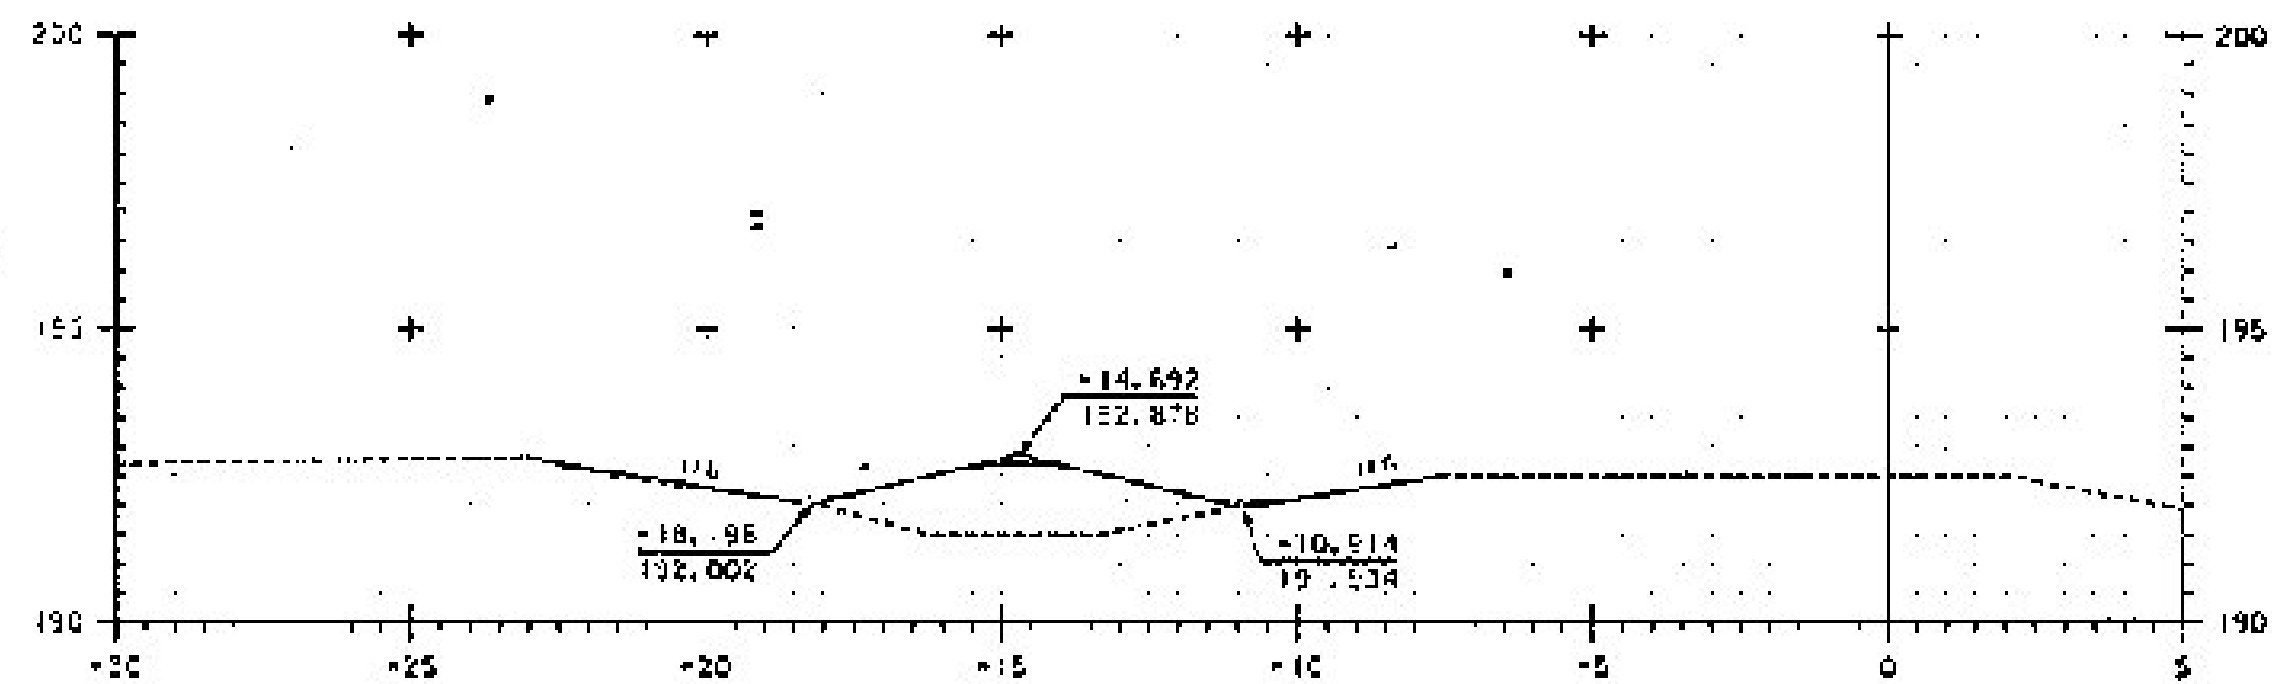

WB 10+980

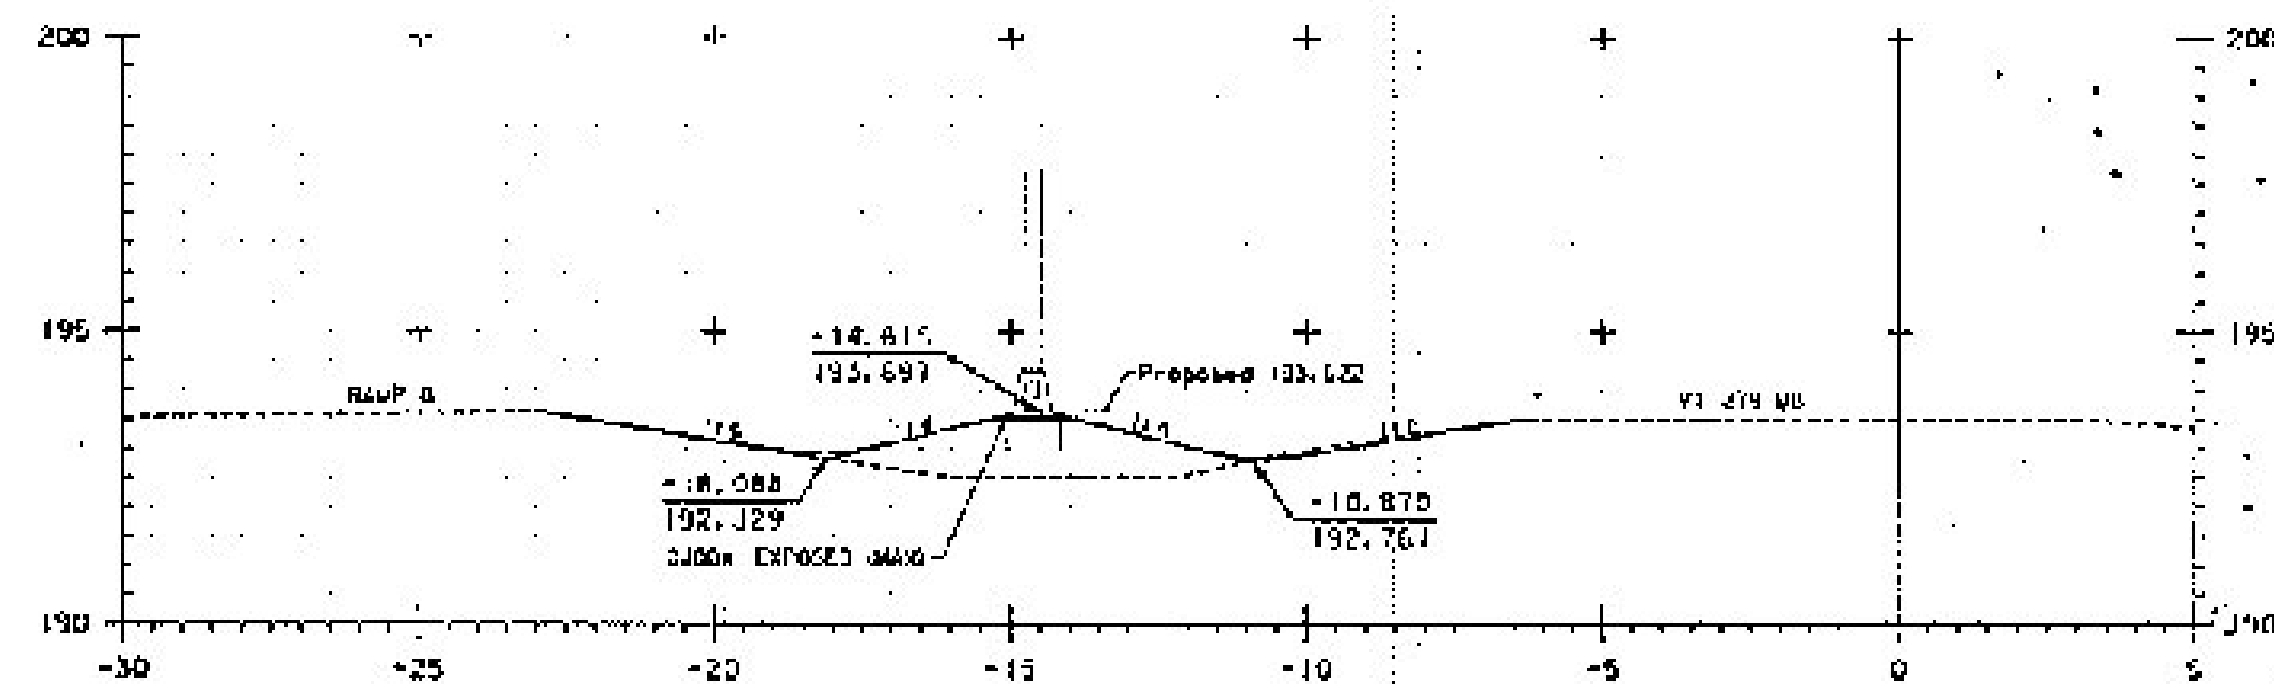

SL-114 (WB 11+026.2)

LIANT ROUE
RECORD PLANS