

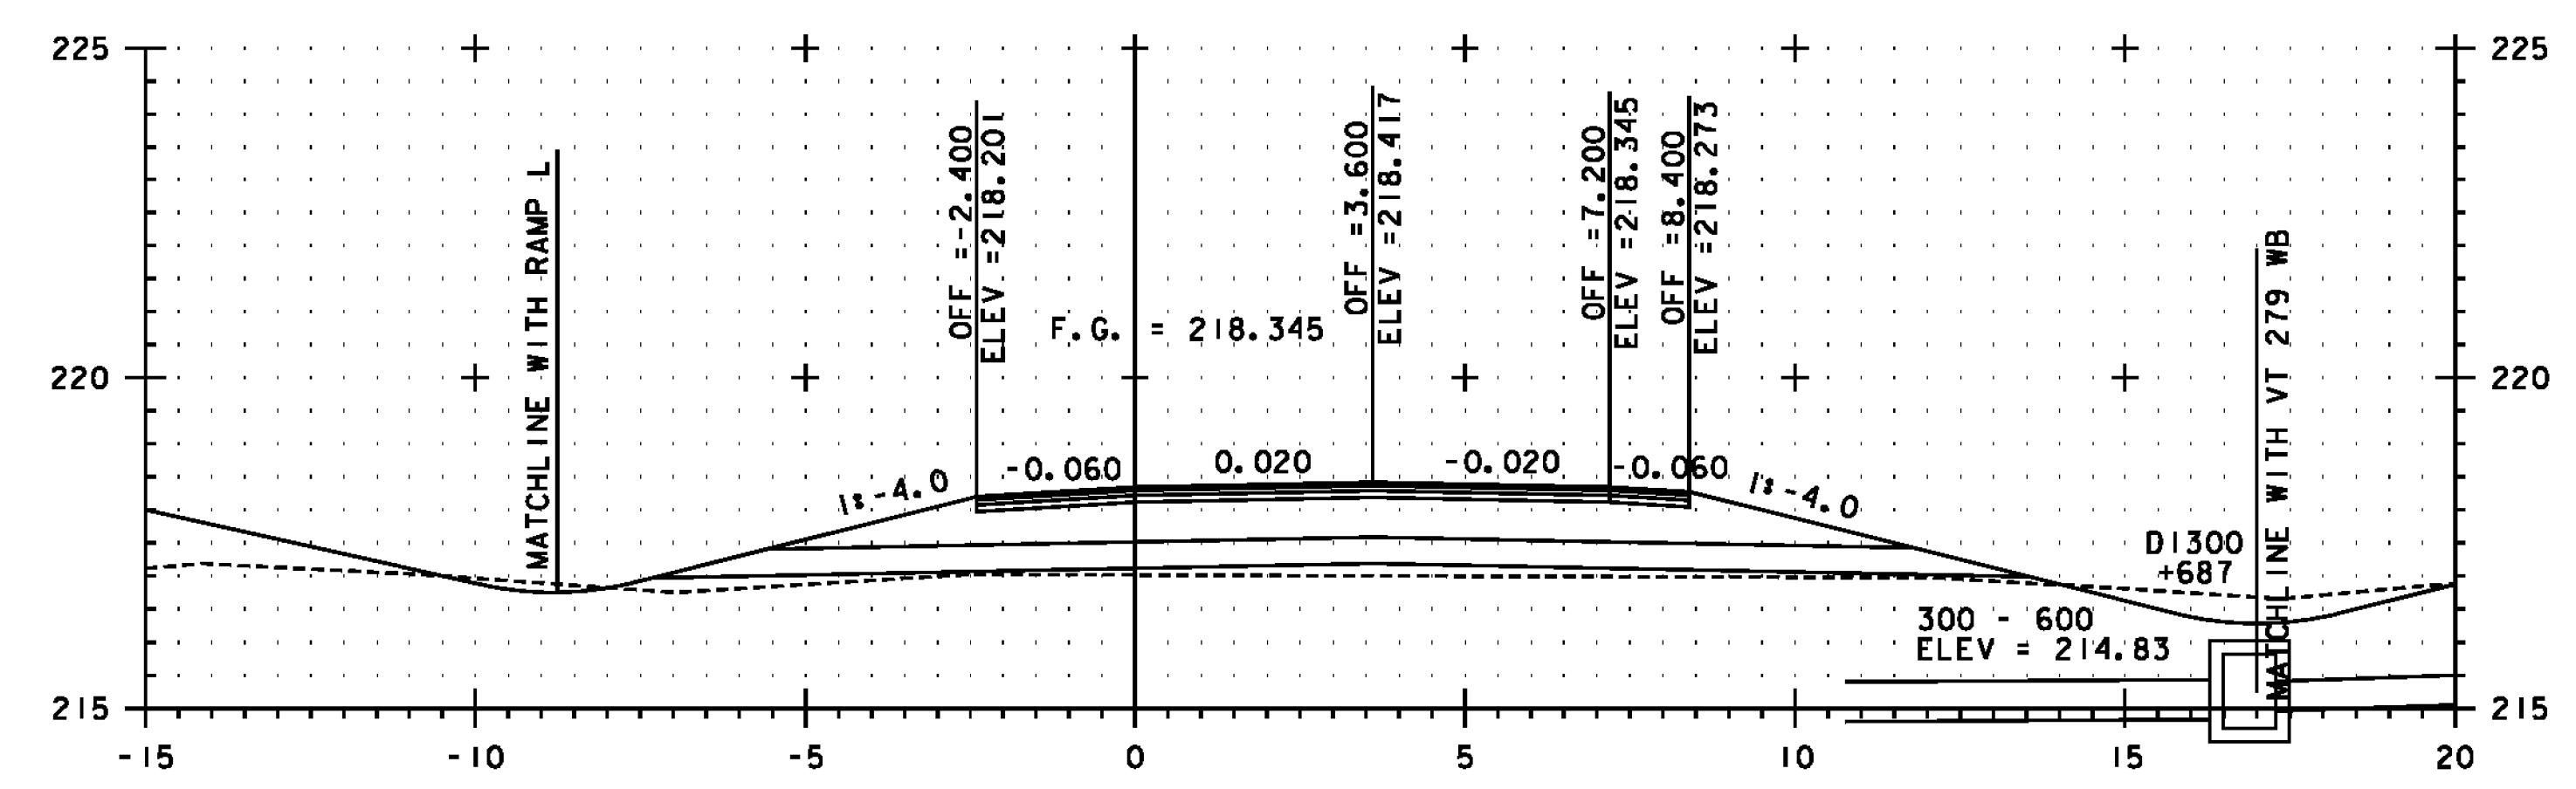


SEE REVISIONS FOR ADDED GUARDRAIL

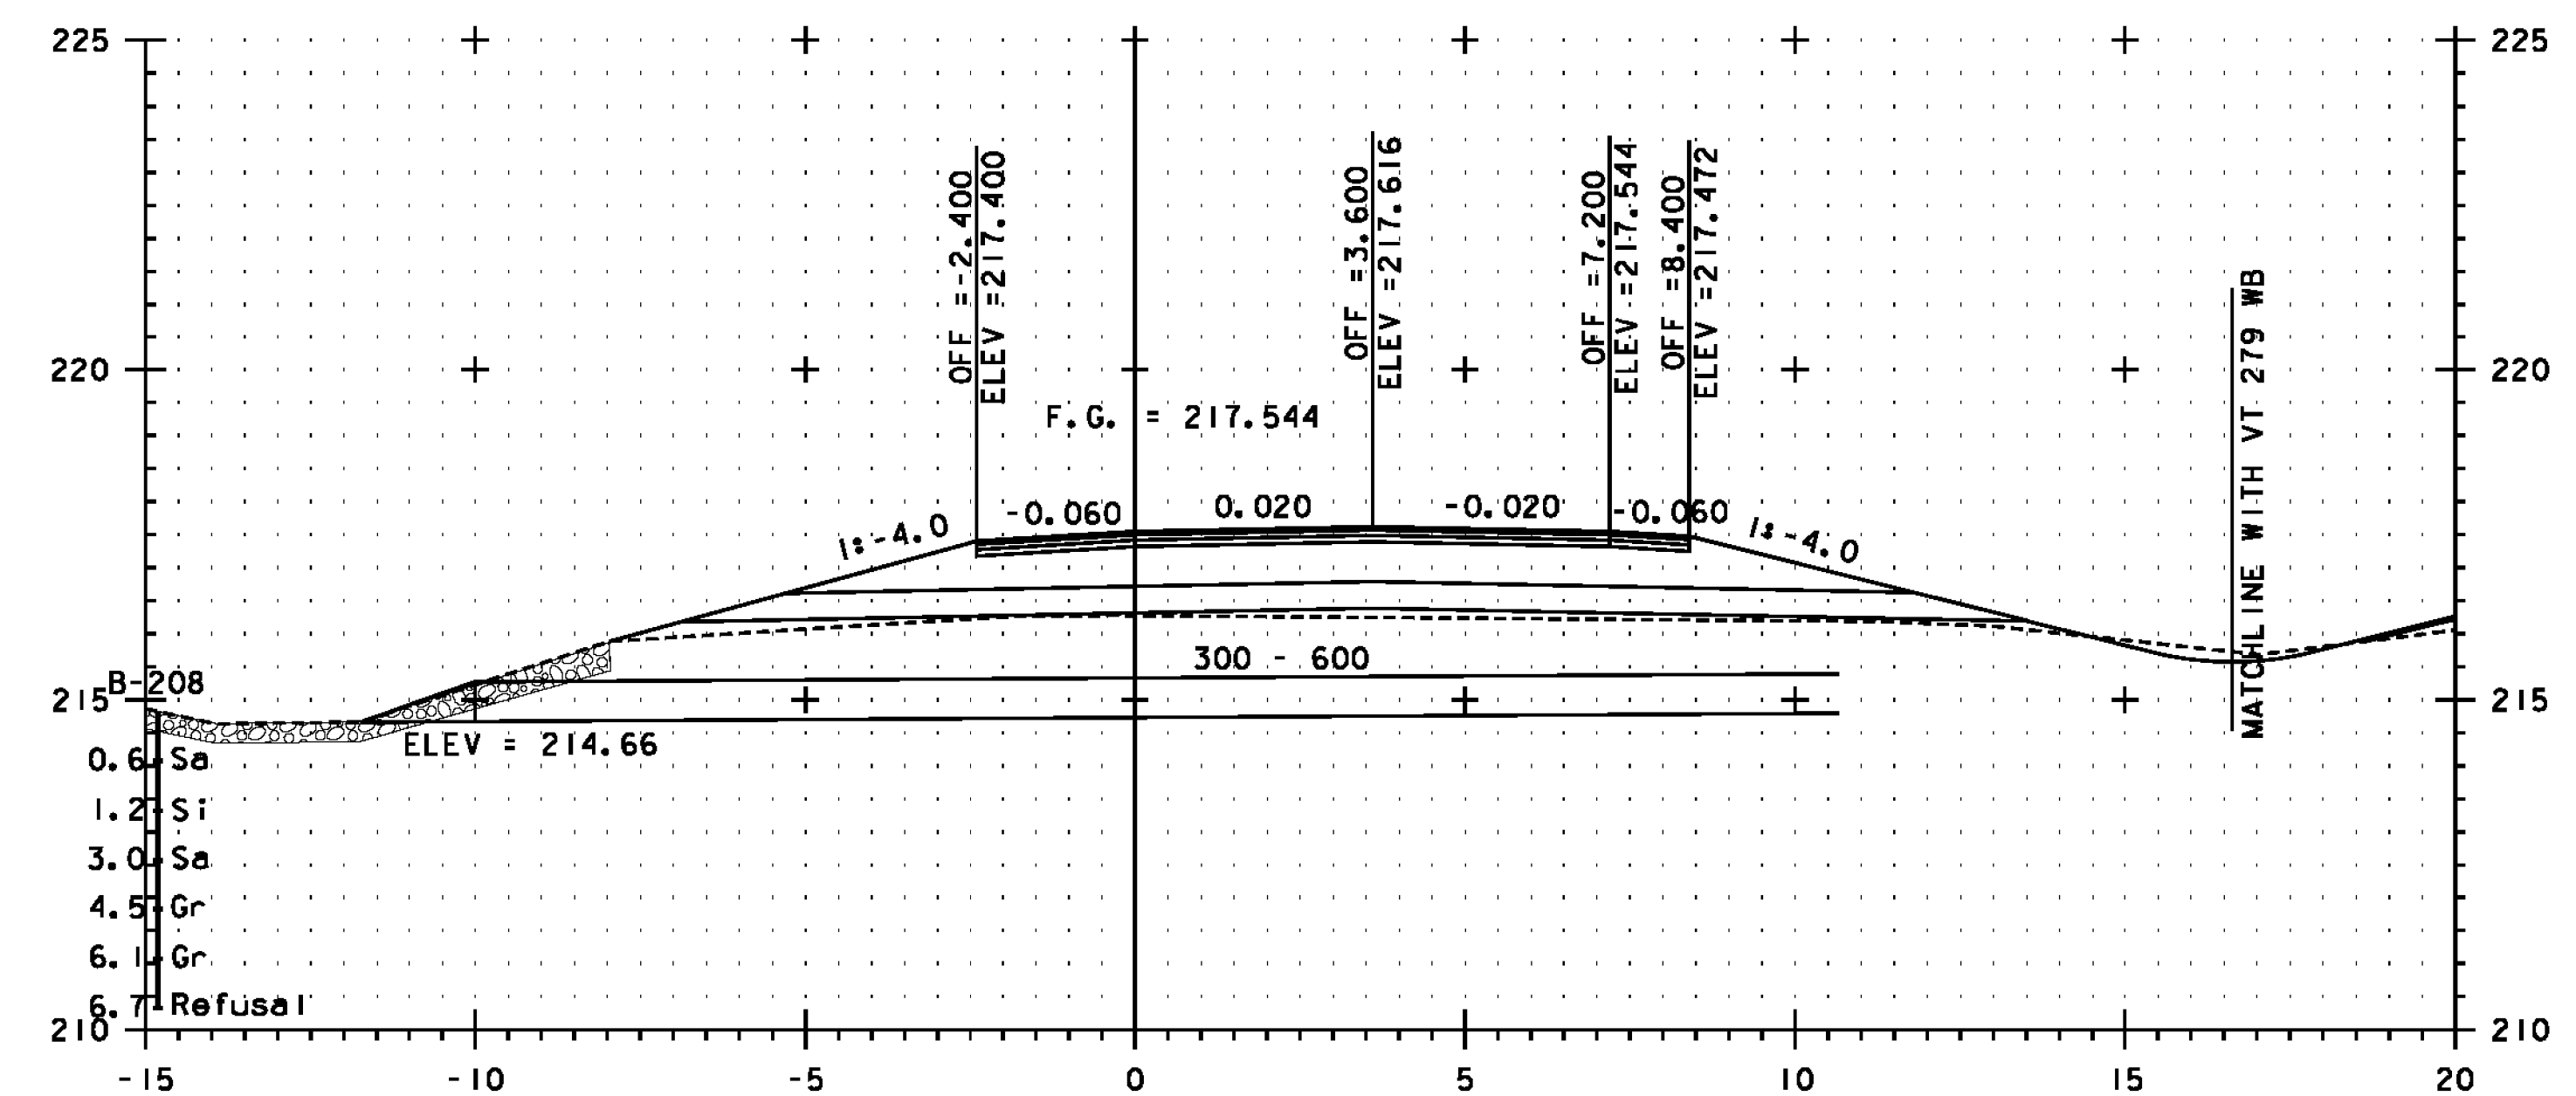

EB 9+612.000 BEGIN APPROACH

NOTE: FINAL CROSS SECTIONS FOR EB ARE CONTAINED IN THE FINAL COMP BOOKS FOR ITEM 203.15 - COMMON EXCAVATION

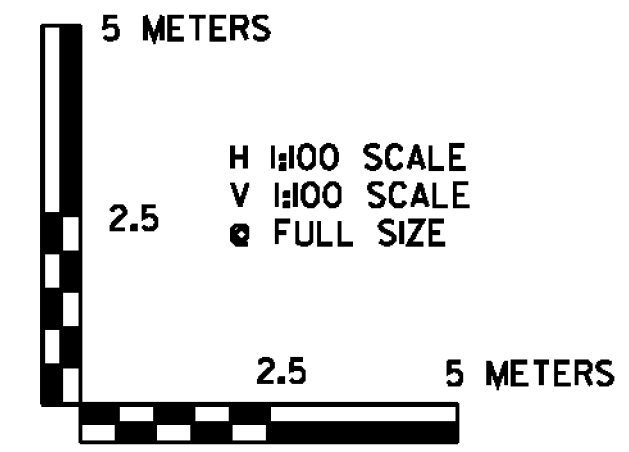

PROJECT NAME:	BENNINGTON
PROJECT NUMBER:	NH 019-(154)
FILE NAME:	...plot_files\zd307c4xs.279EB.ptf
DESIGN SUPERVISOR:	GREG EDWARDS
DESIGNED BY:	MARC FOISY
VT 279 EB CROSS SECTION	EBX-01
PLOT DATE:	1/26/2010
DRAWN BY:	STANTEC
CHECKED BY:	GARY SANTY
SHEET	339 OF 468

1/26/2010 4:56:26 PM v:\1953\getlive\19530002\tr\anspor\101\dr\cm\ng\com\tr\c01_4\plot_files\zd307c4xs.279EB.ptf