



EB 9+660

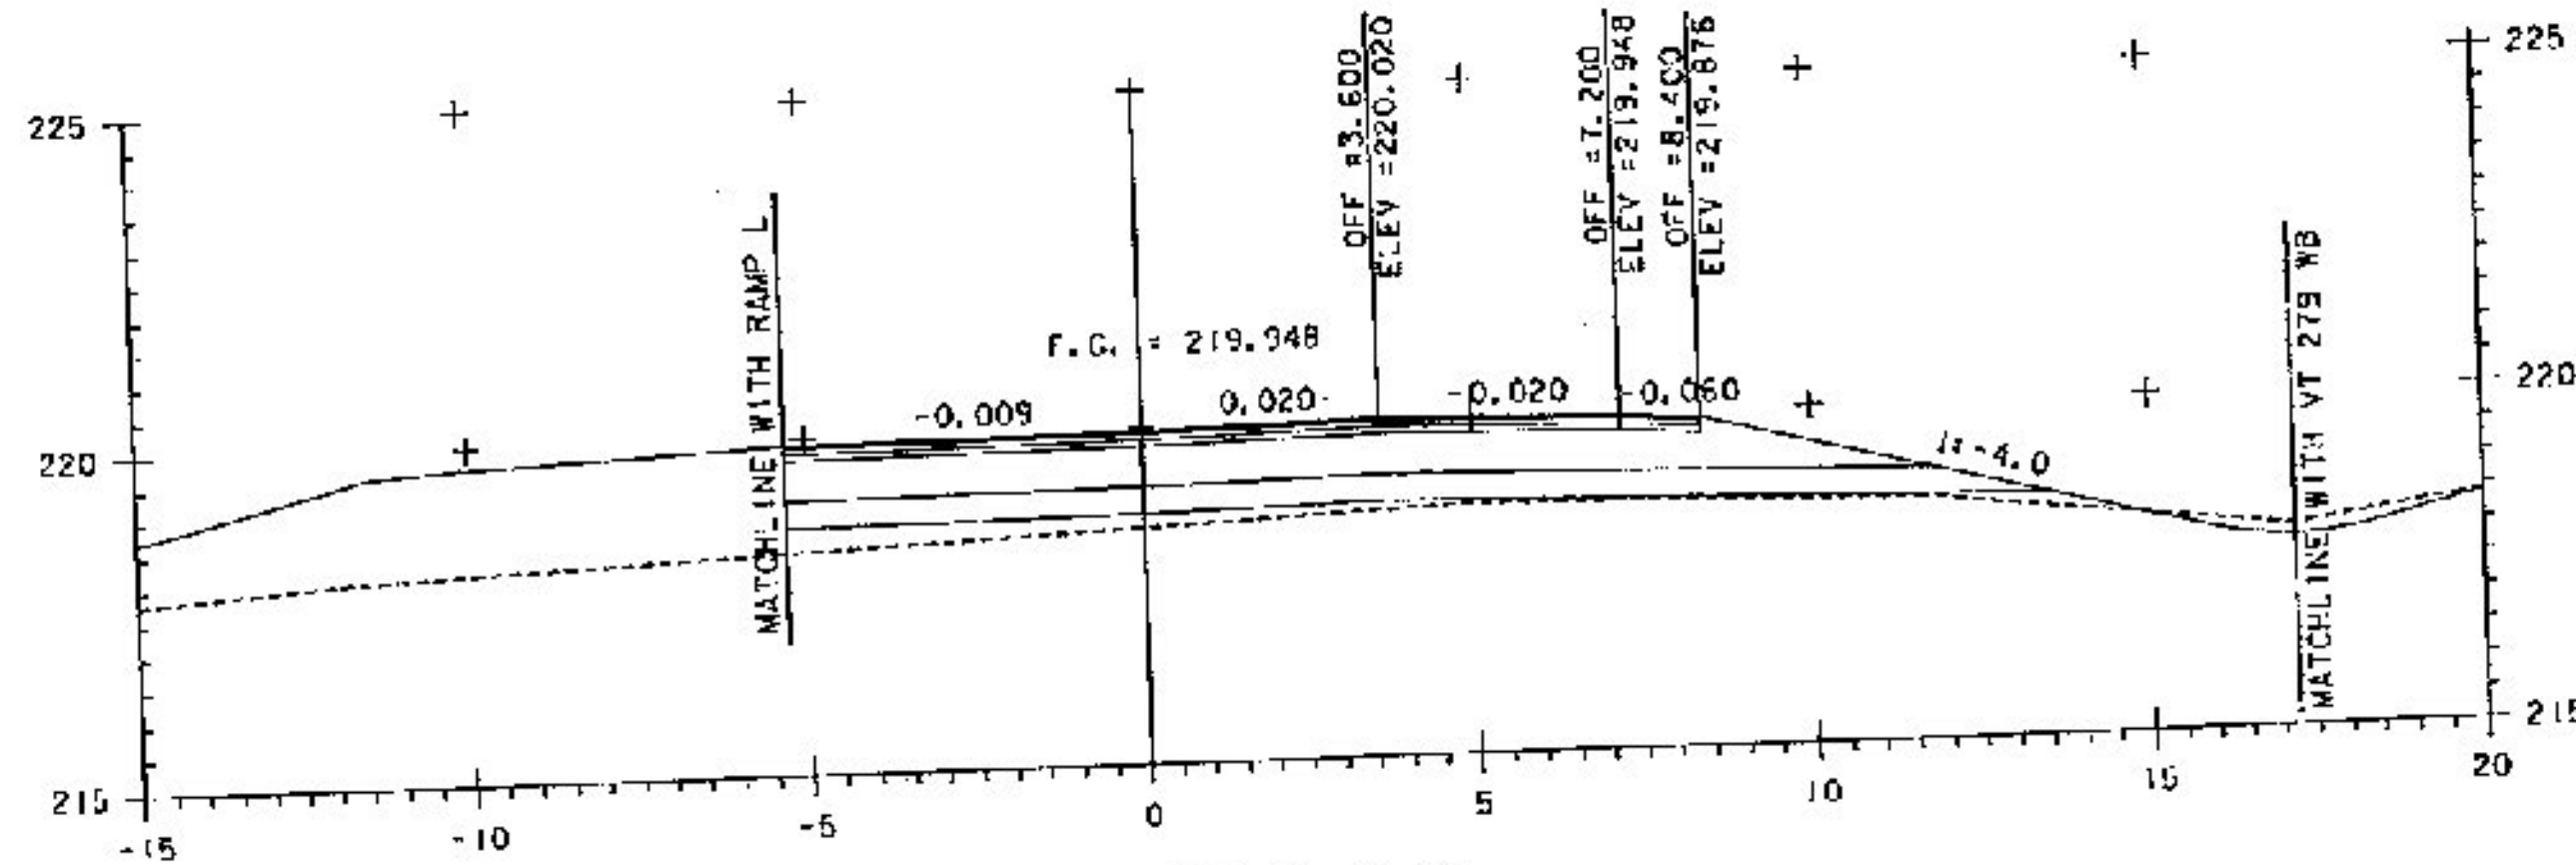


EB 9+640

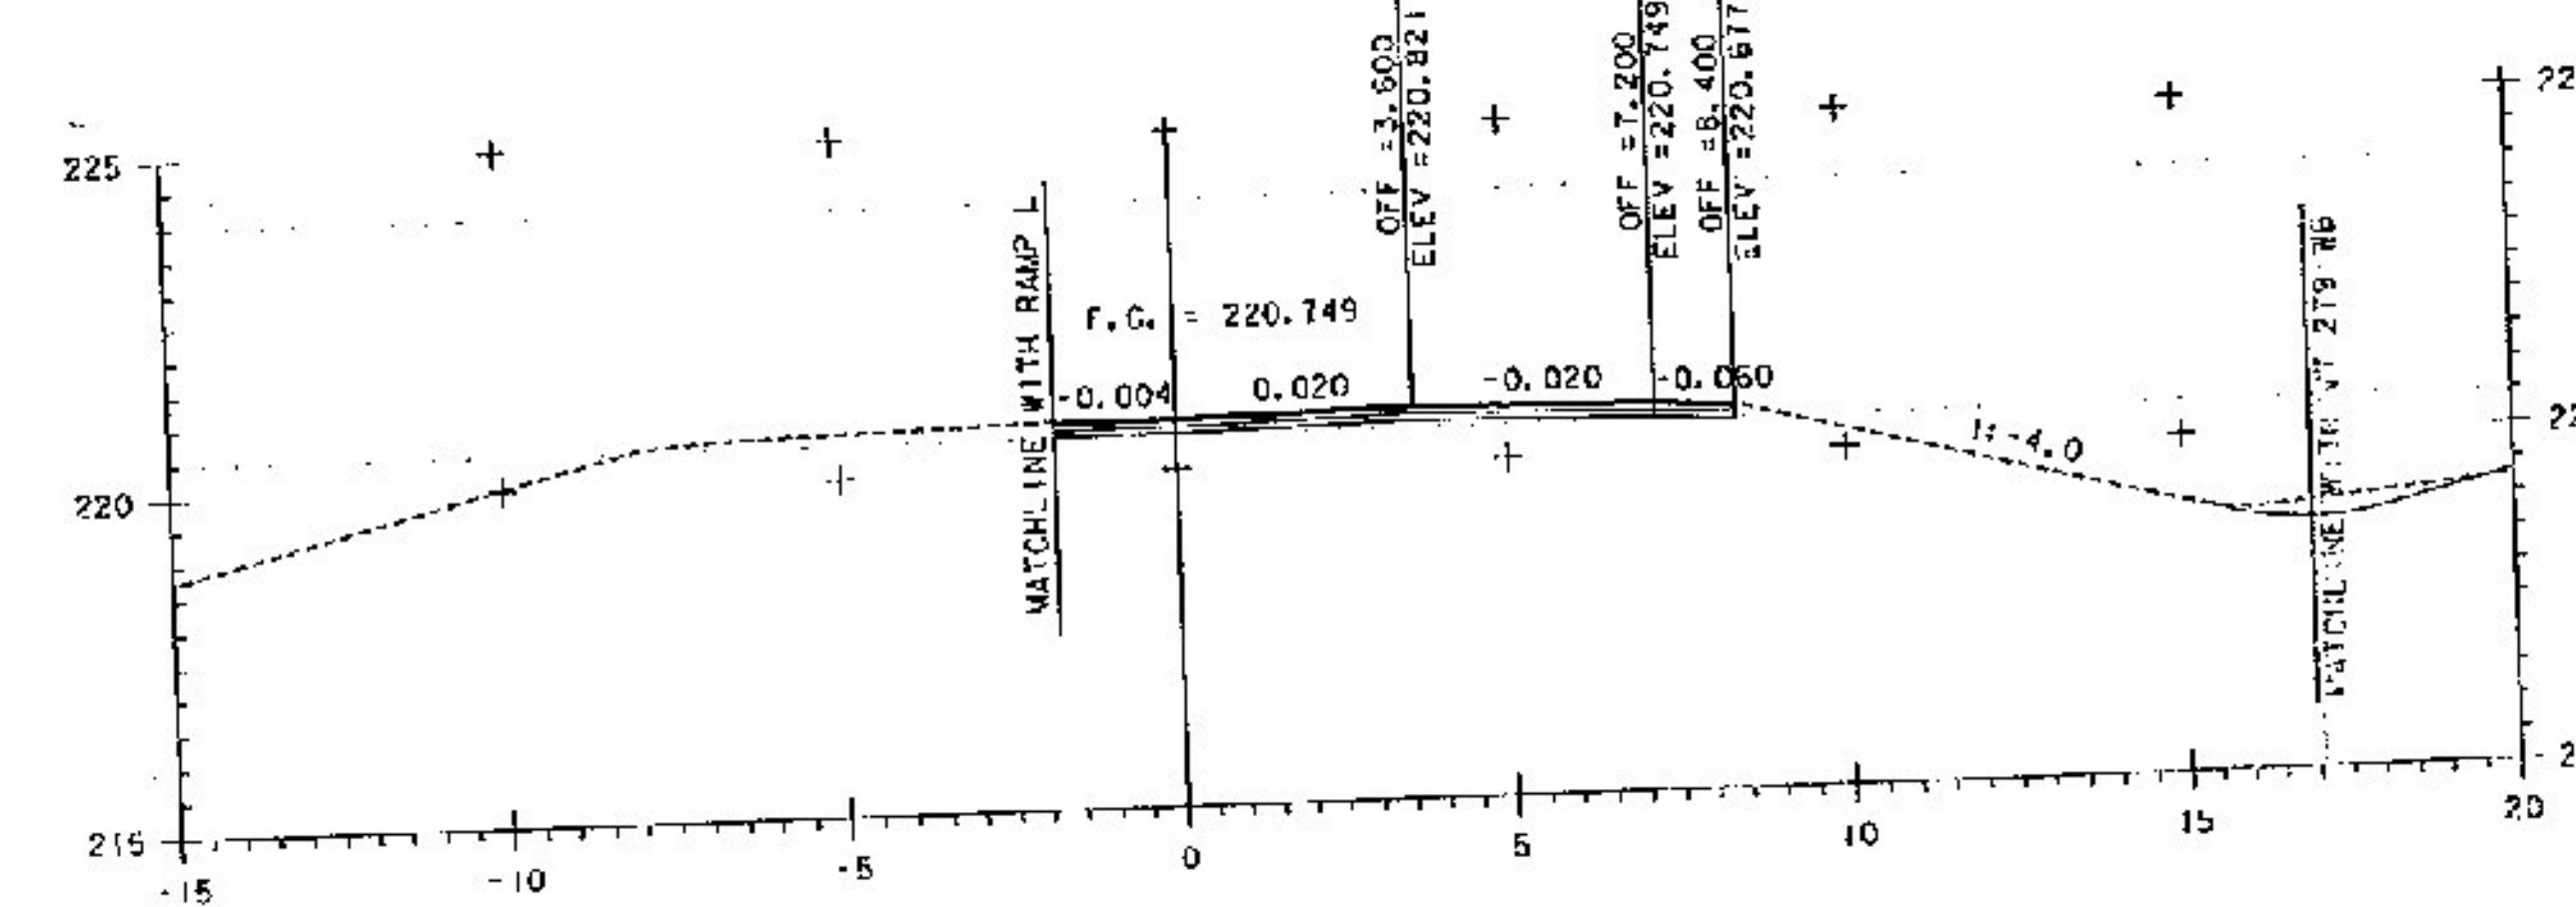


EB 9+620.000

EB 9+612.000 BEGIN APPROACH


Added Guardrail *Record Plans*

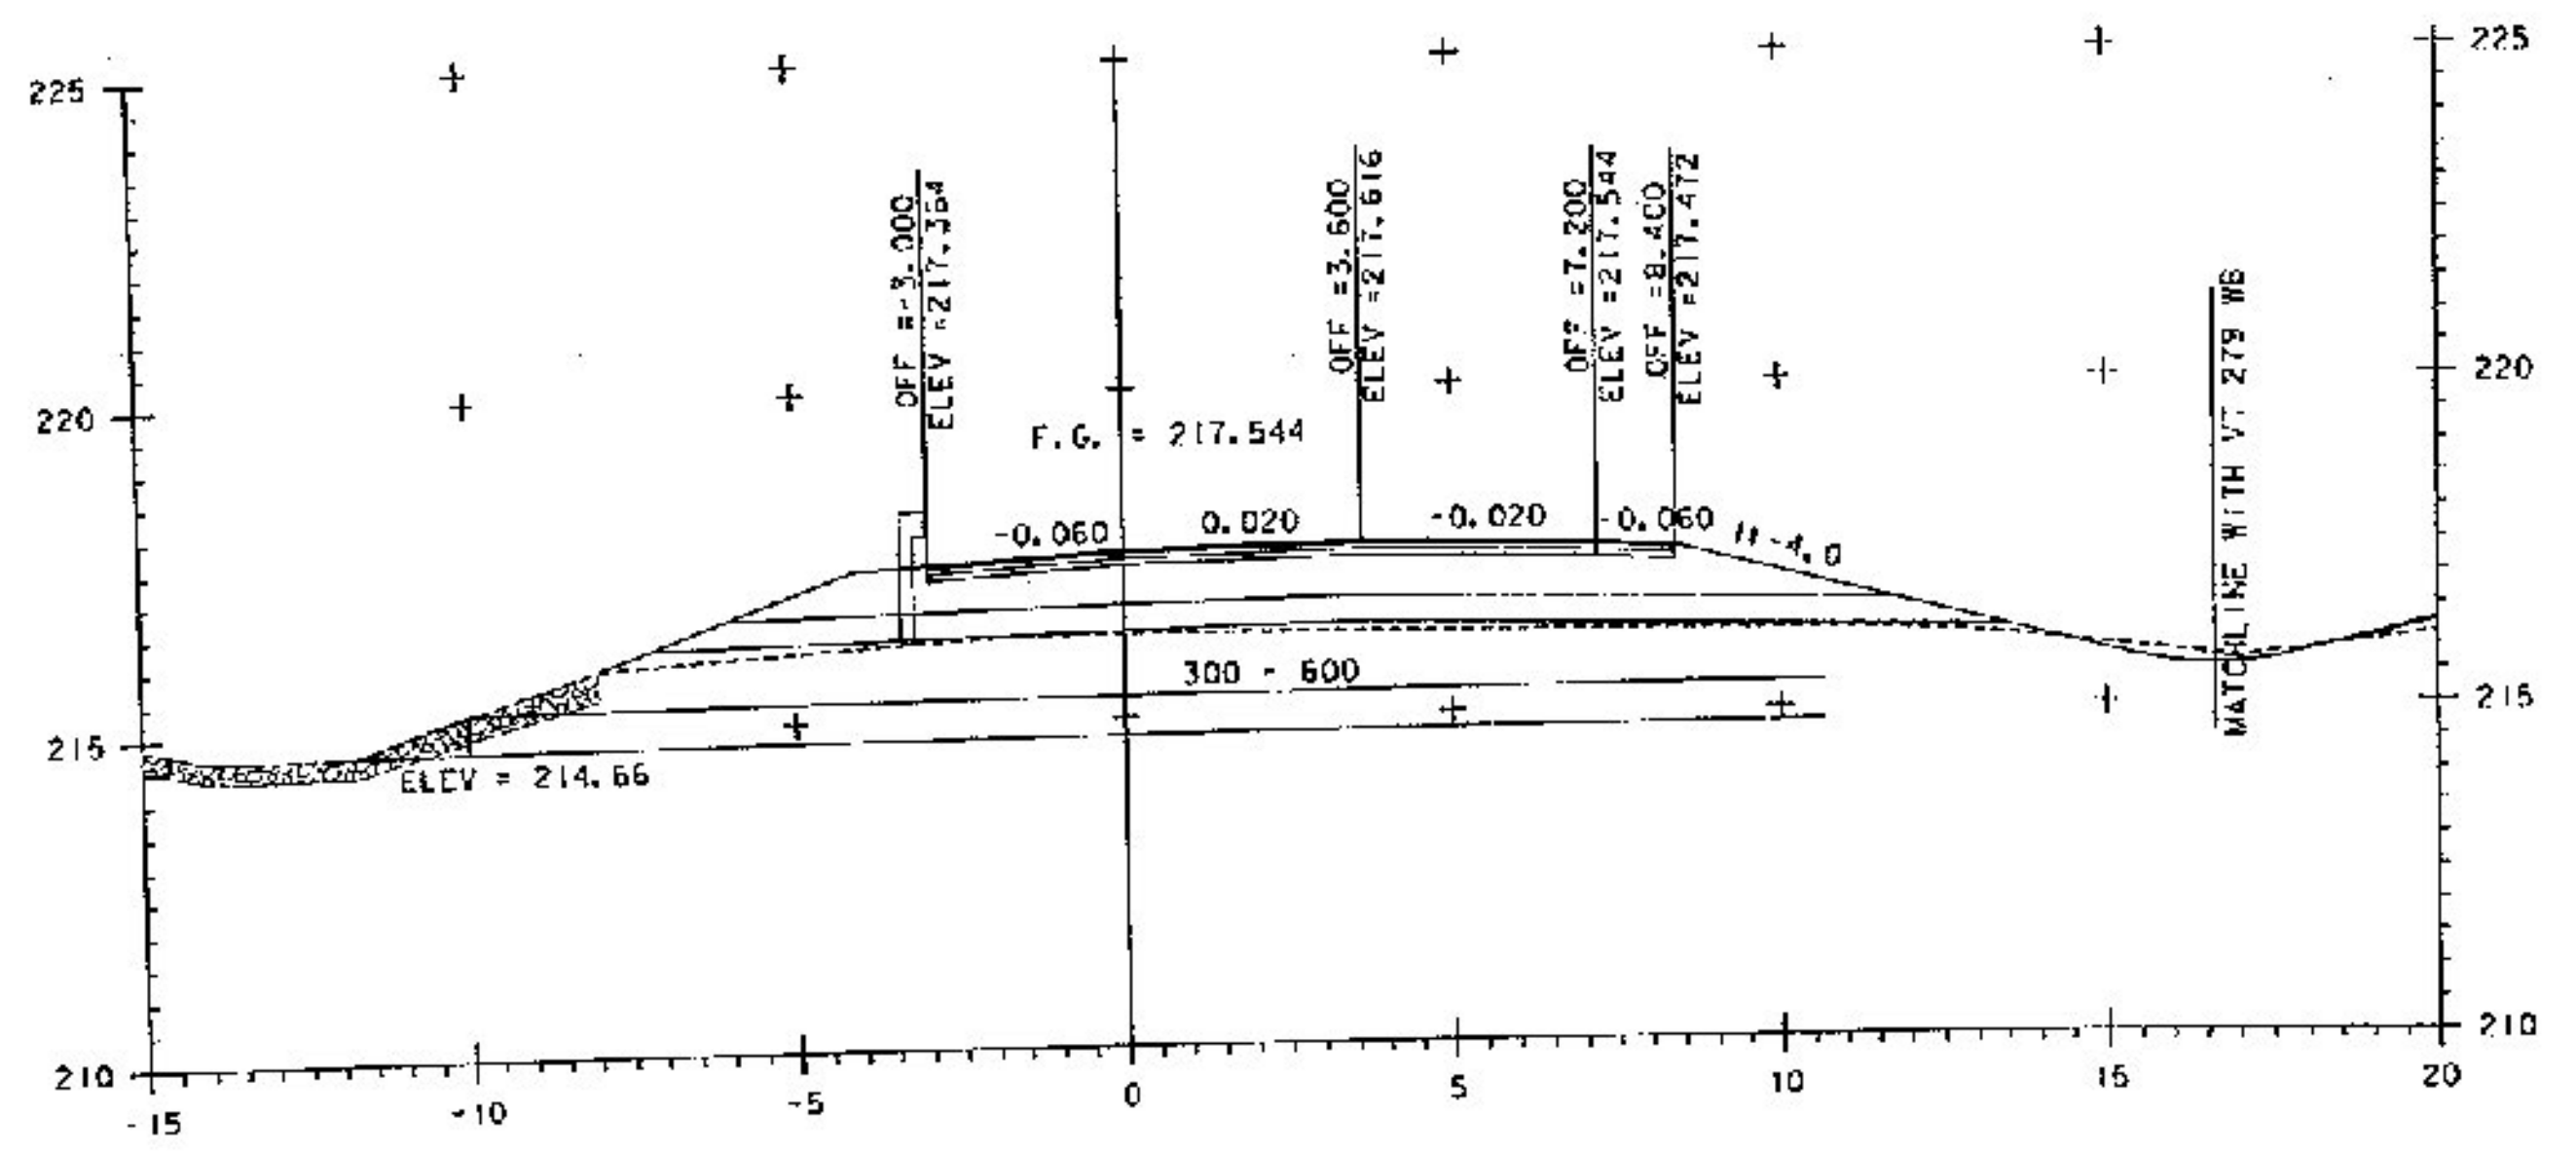

EB 9+700

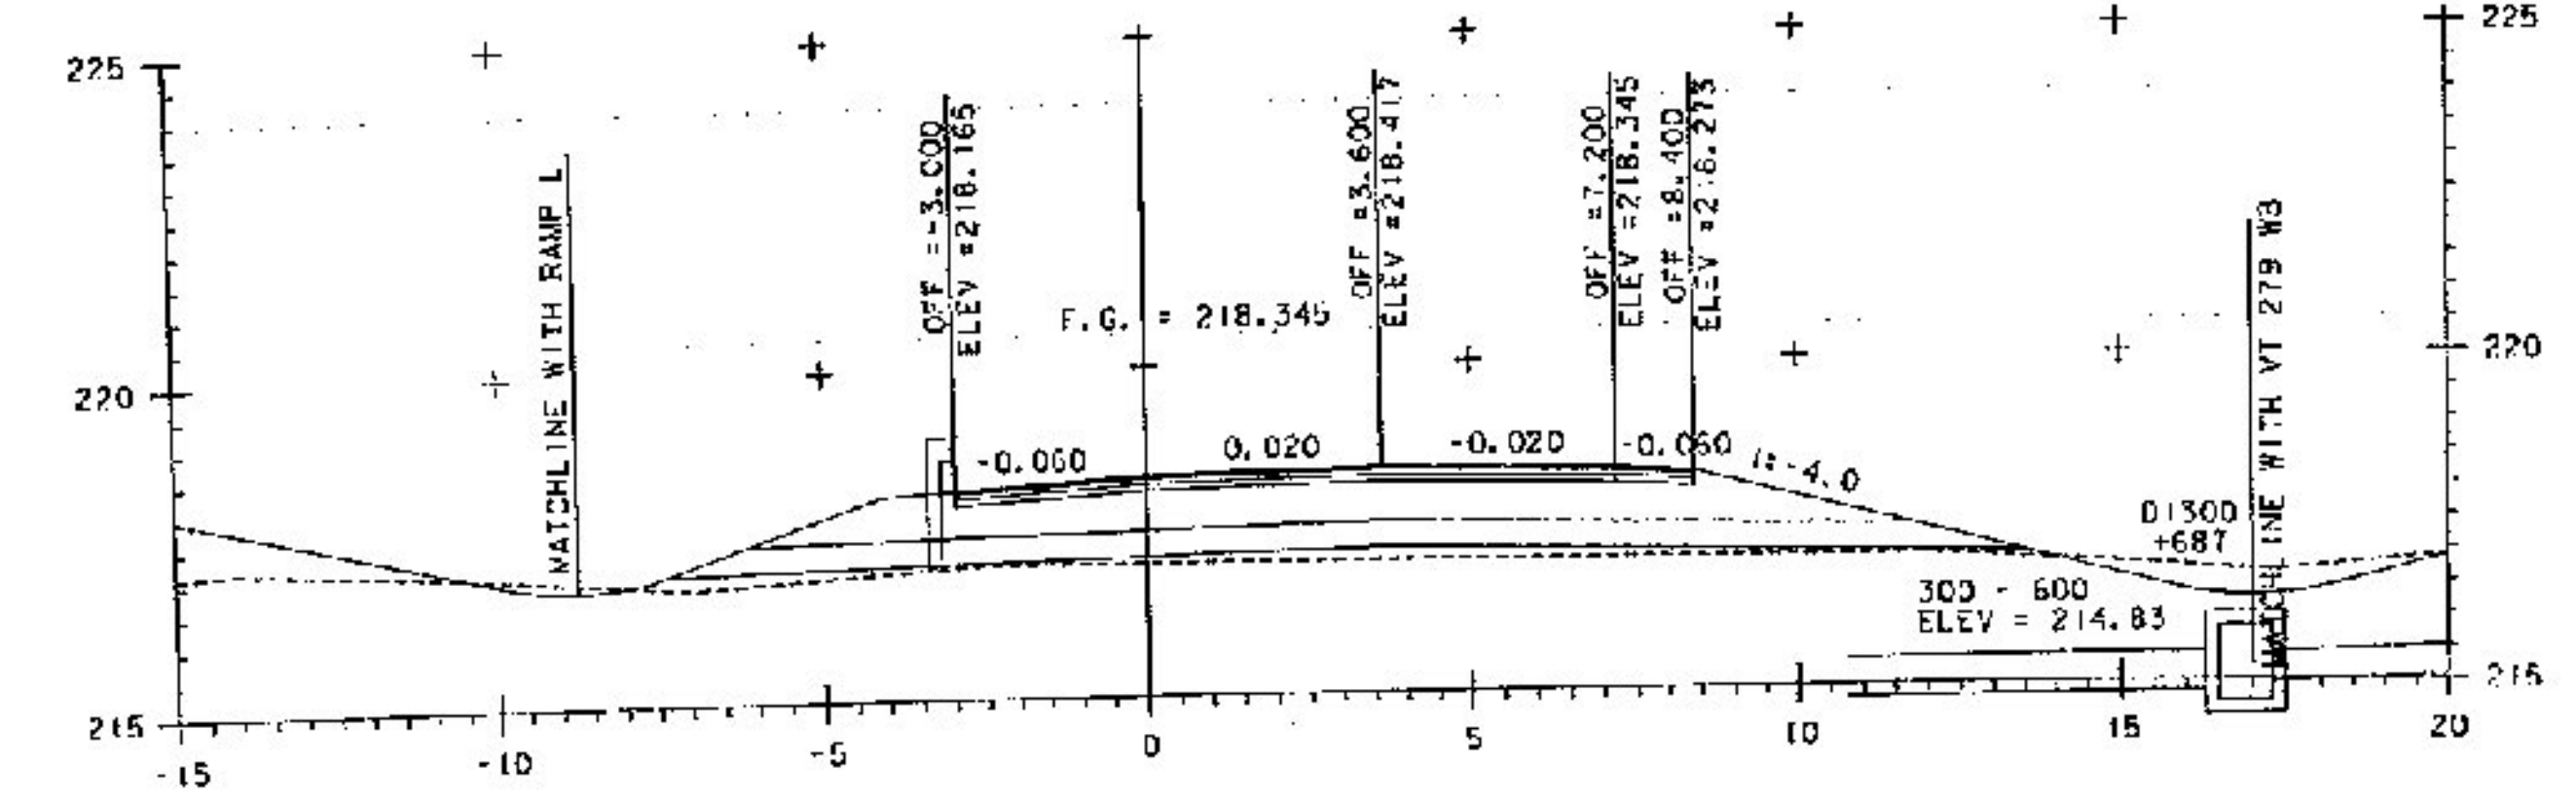

EB 9+680

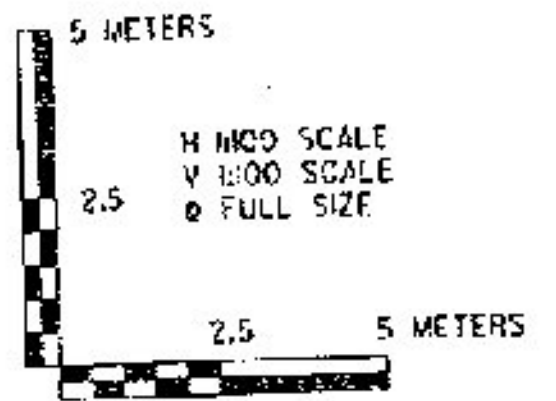

PROJECT NAME:	BENNINGTON
PROJECT NUMBER:	NH 019-K54
FILE NAME:	...npt01_48d3zd307c4xs.279EB.dwg
DESIGN SUPERVISOR:	DREG EDWARDS
DESIGNED BY:	MARC FOISY
VT 279 EB CROSS SECTION:	EBX-01
PLOT DATE:	9/4/2012
DRAWN BY:	STANTEC
CHECKED BY:	GARY SANTY
SHEET:	339 OF 468

GUARDRAIL #3