

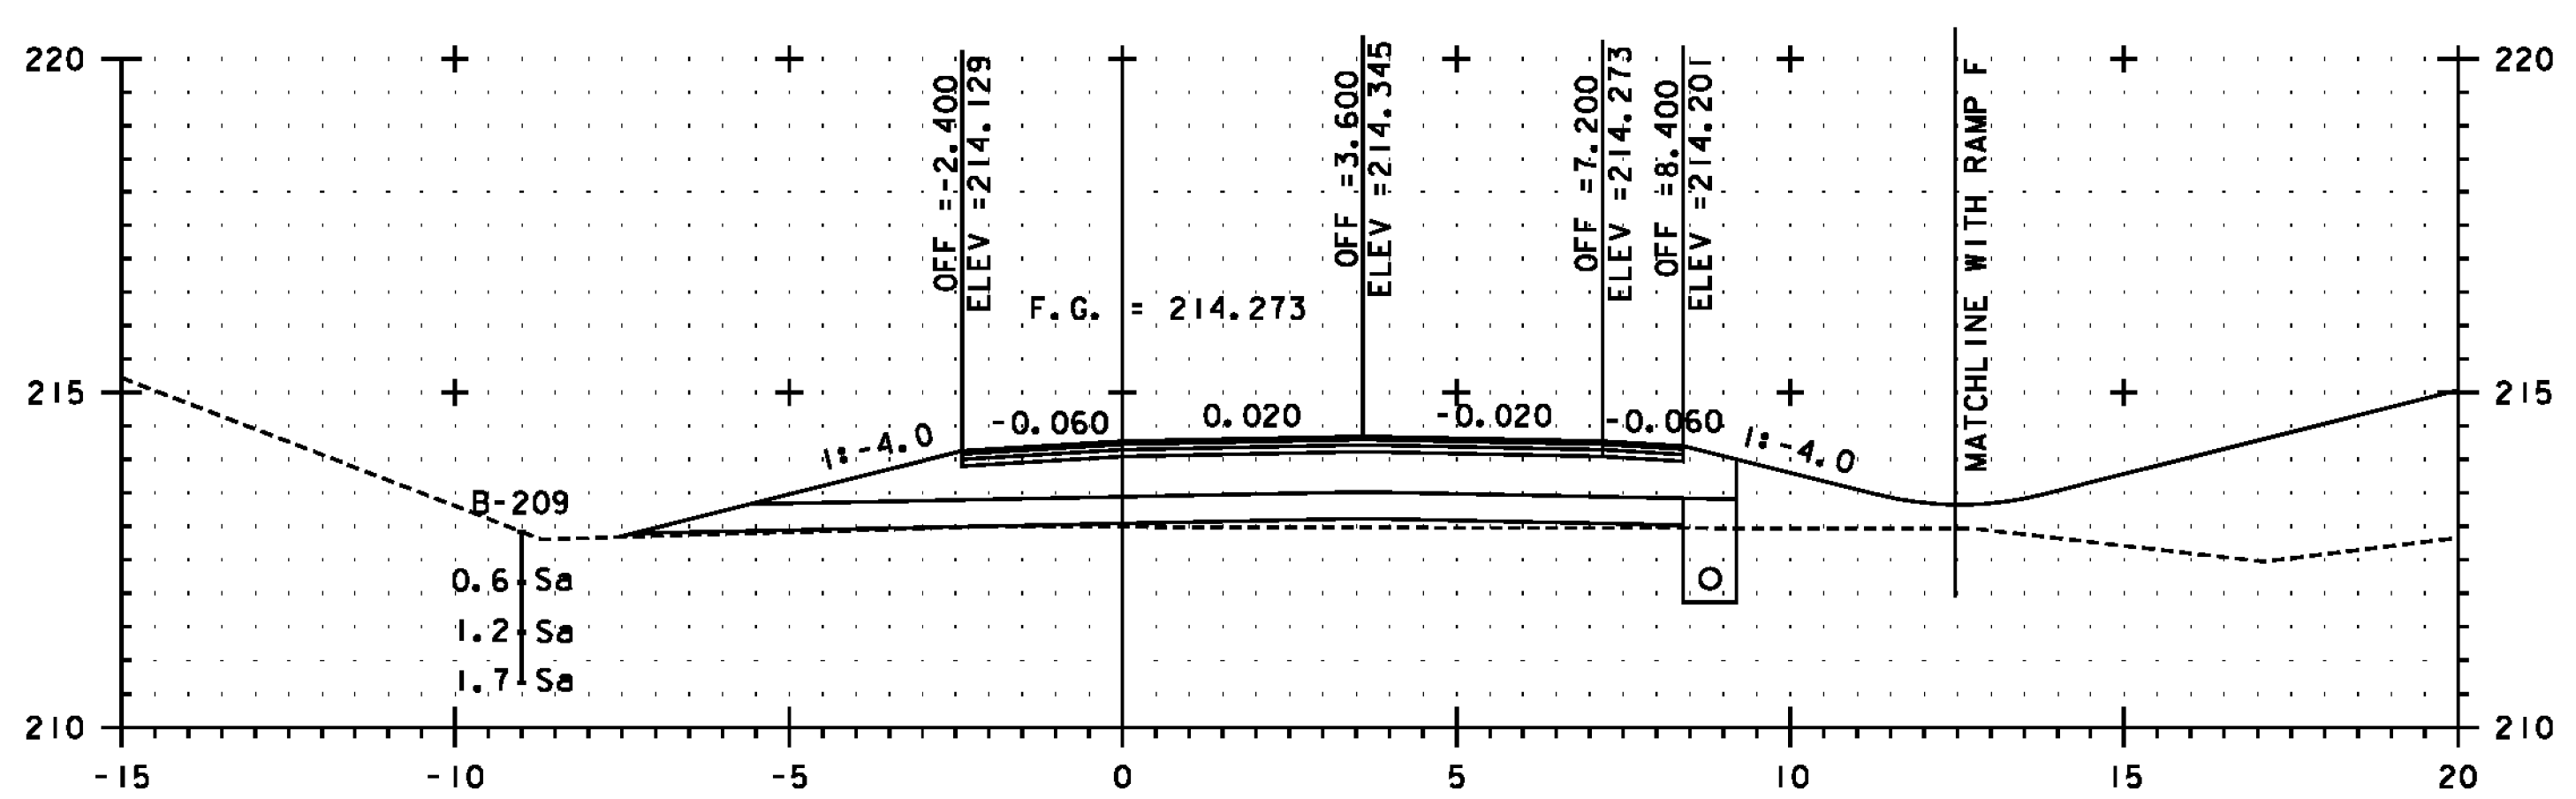
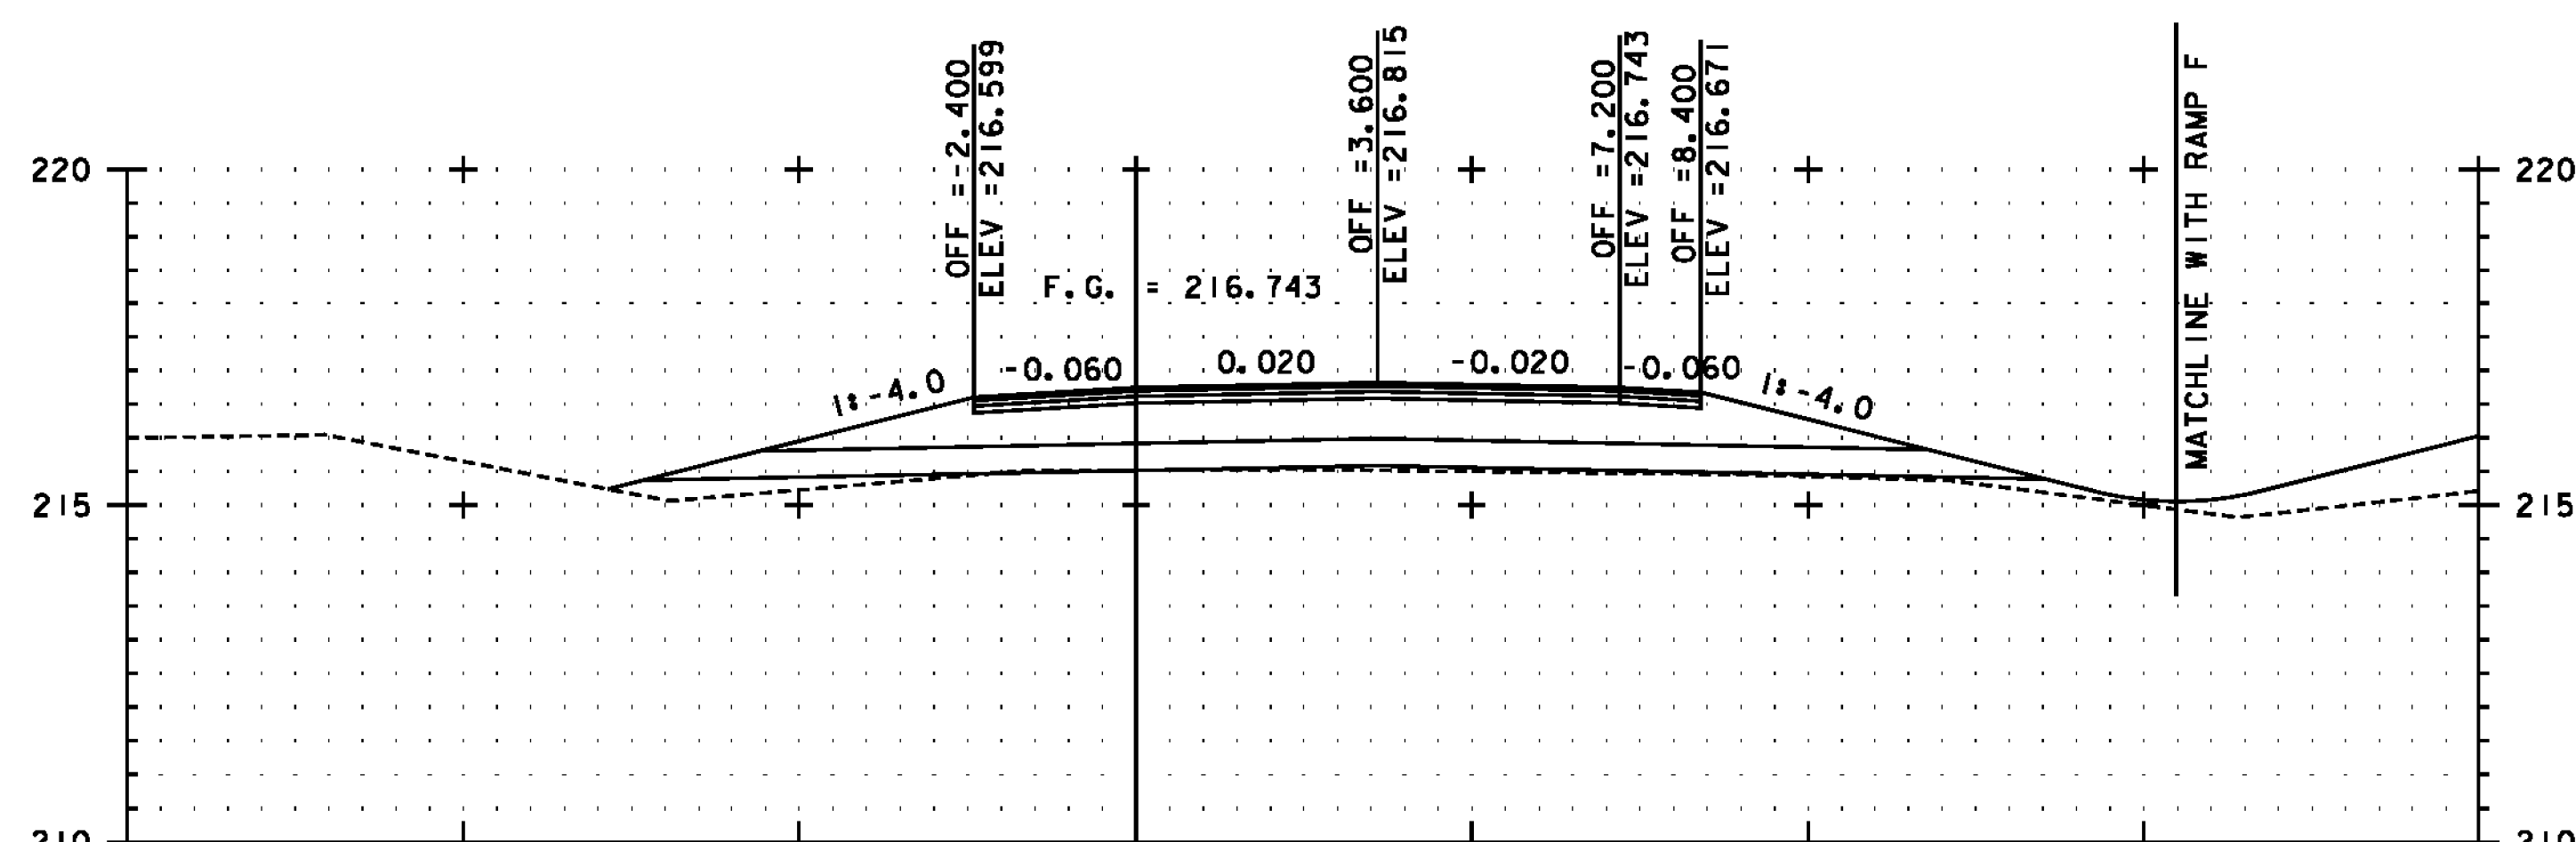
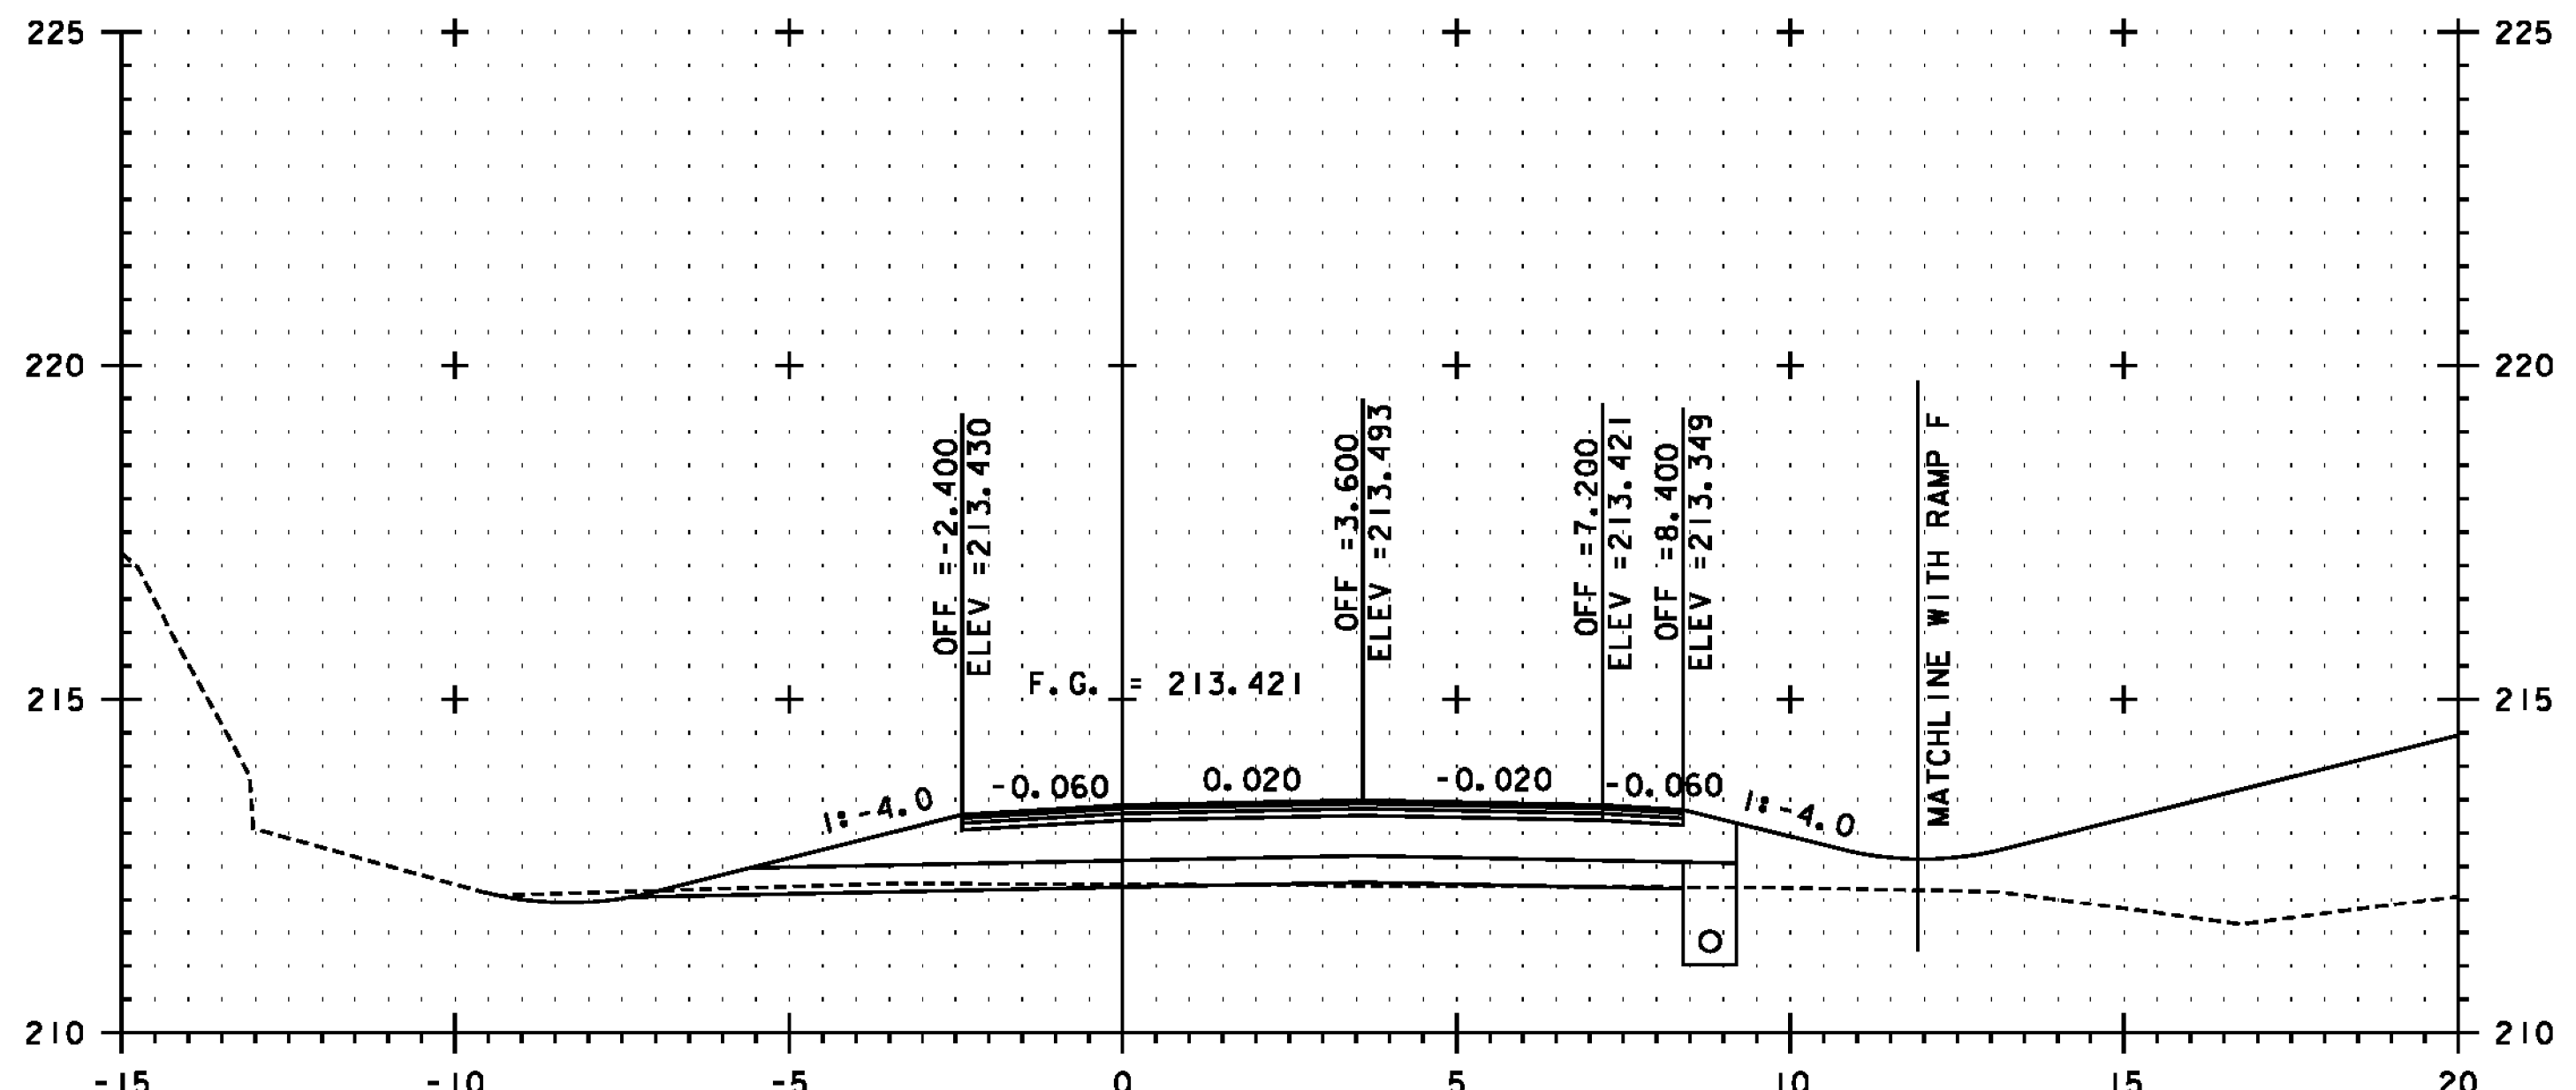


SEE REVISIONS
FOR ADDED
GUARDRAIL

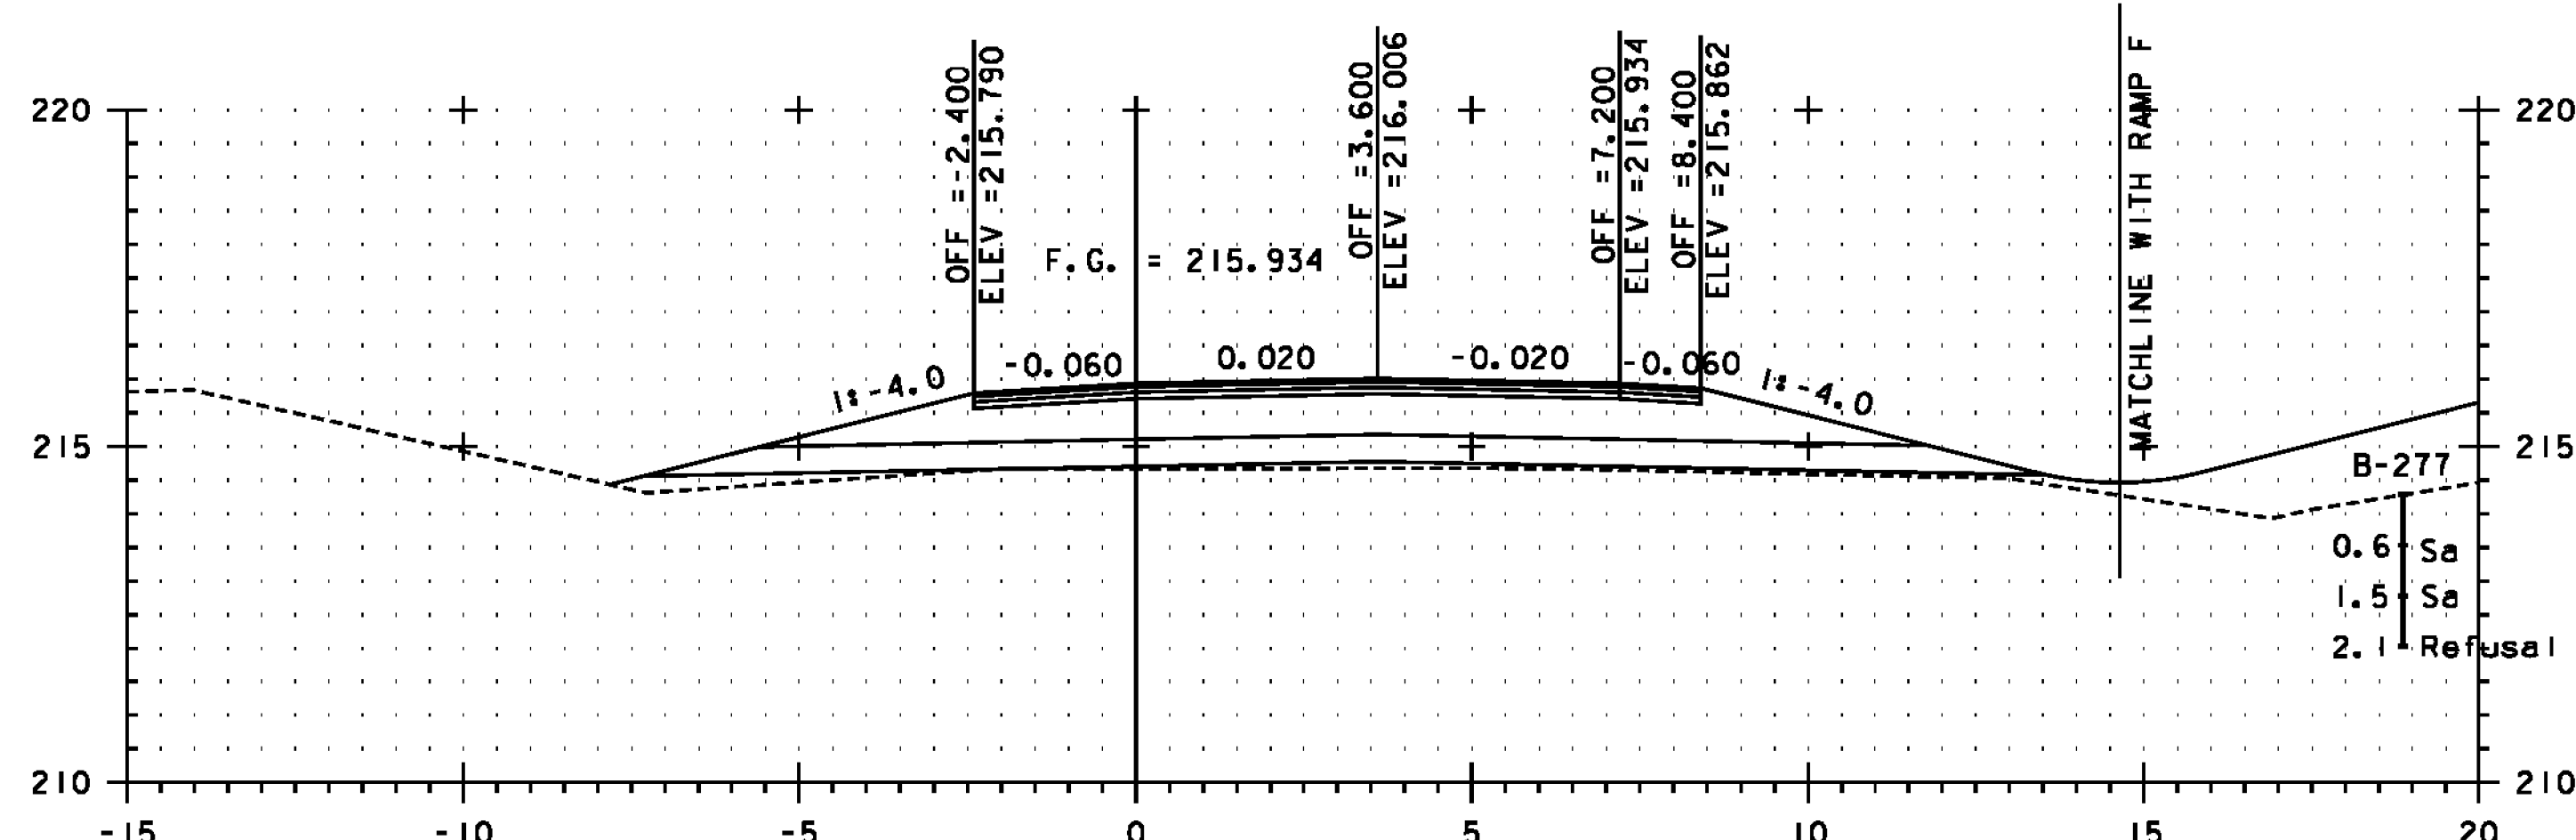

SEE NOTE ON
SHEET 339

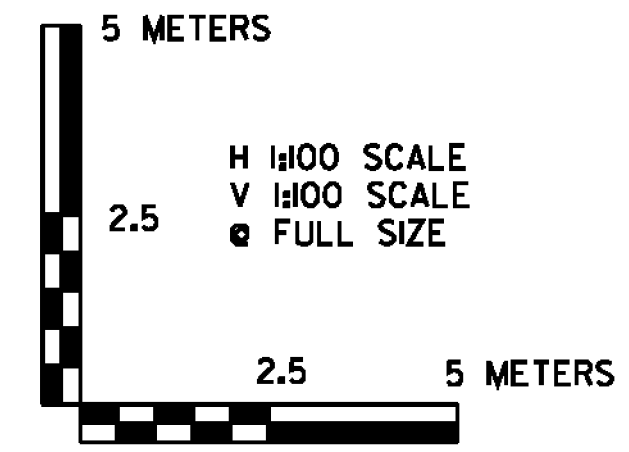

PROJECT NAME:	BENNINGTON
PROJECT NUMBER:	NH 019-(154)
FILE NAME:	...plot_files\zd307c4xs.279EB.ptf
DESIGN SUPERVISOR:	GREG EDWARDS
DESIGNED BY:	MARC FOISY
VT 279 EB CROSS SECTION	EBX-02
PLOT DATE:	1/26/2010
DRAWN BY:	STANTEC
CHECKED BY:	GARY SANTY
SHEET	340 OF 468

1/26/2010 4:56:27 PM v:\1953\getlive\1953\0002\tr\anspor\getlive\dwg\com\tr\001_4\plot_files\zd307c4xs.279EB.ptf