



EB 9+760

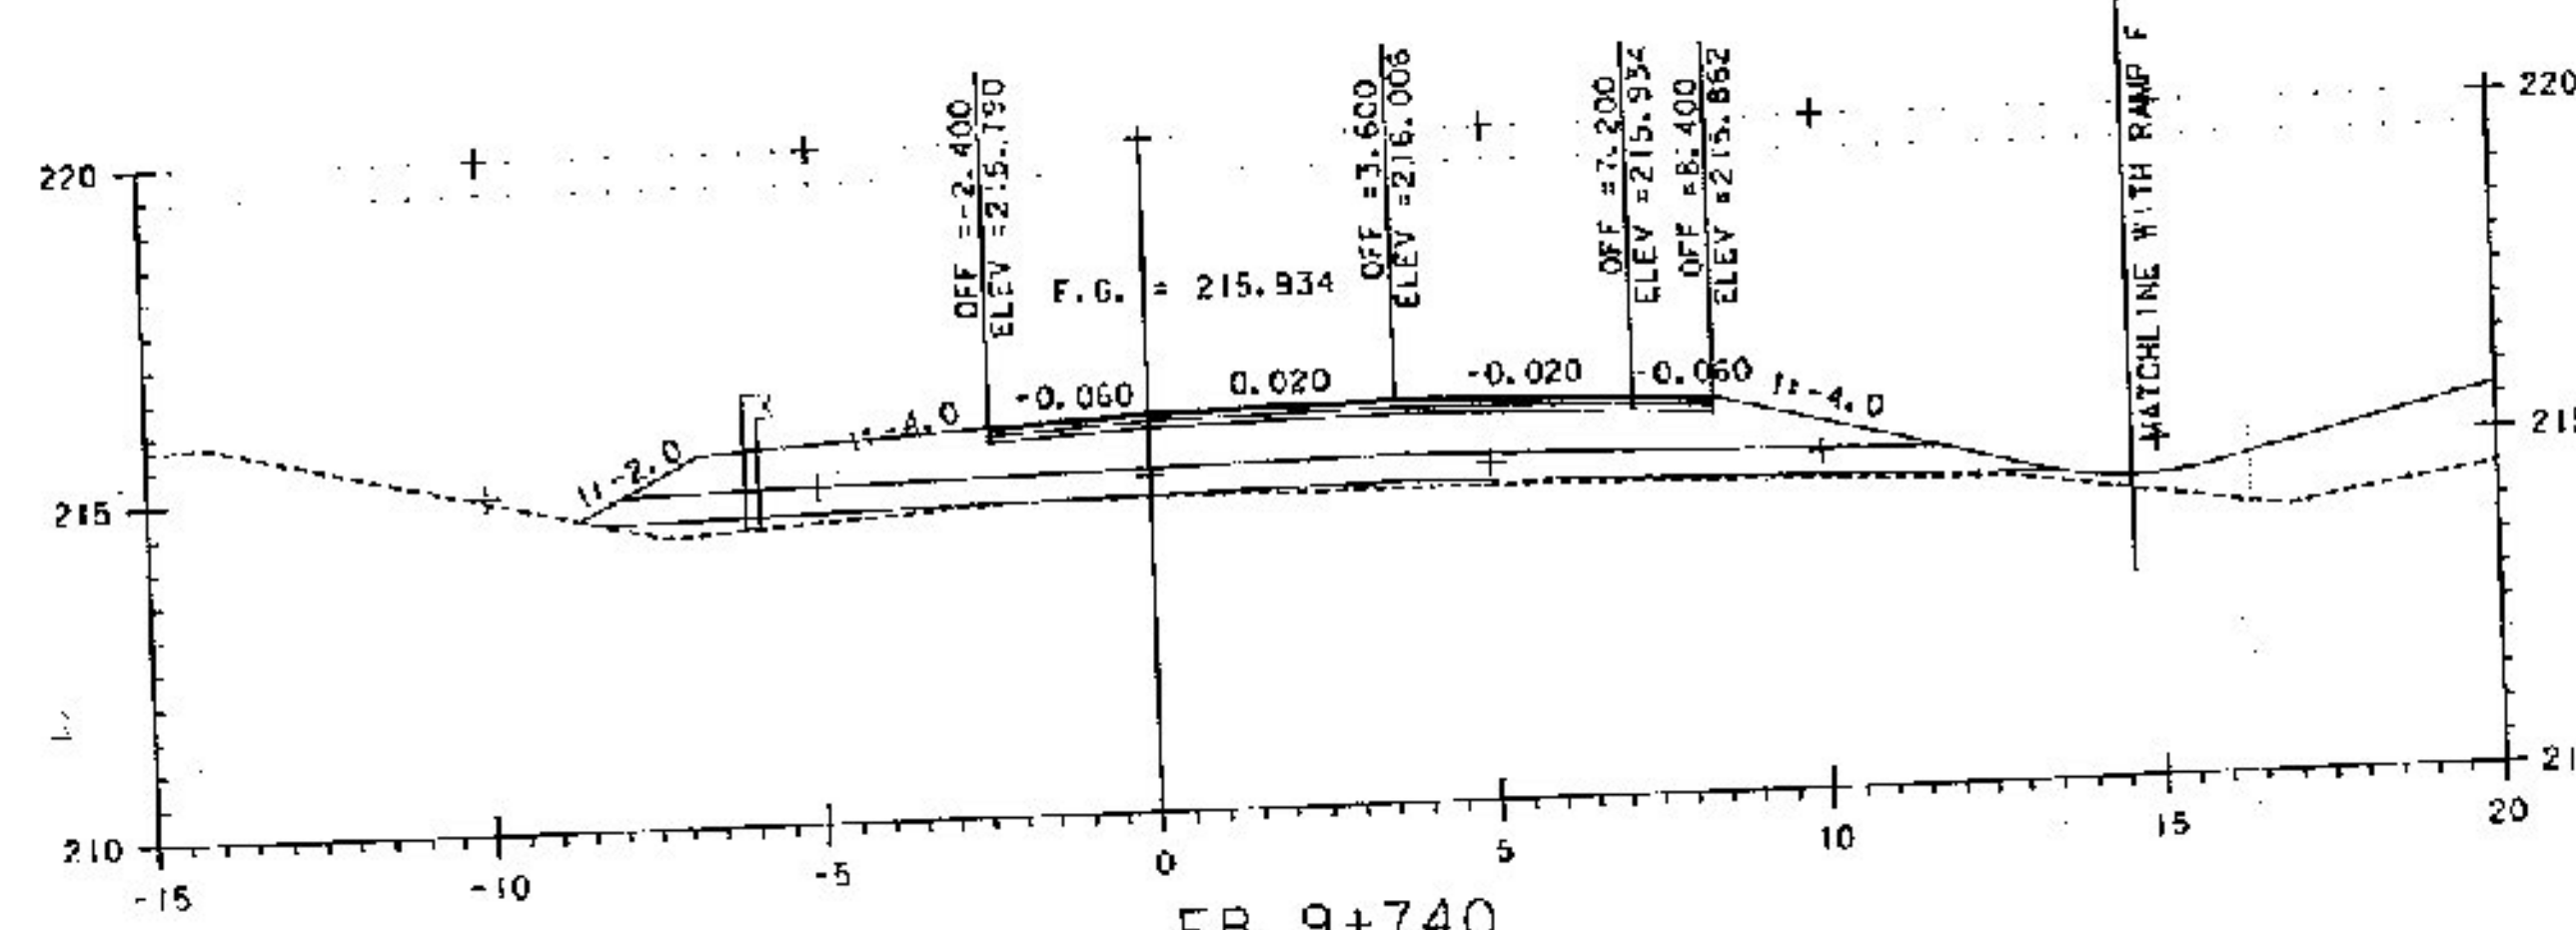


EB 9+740

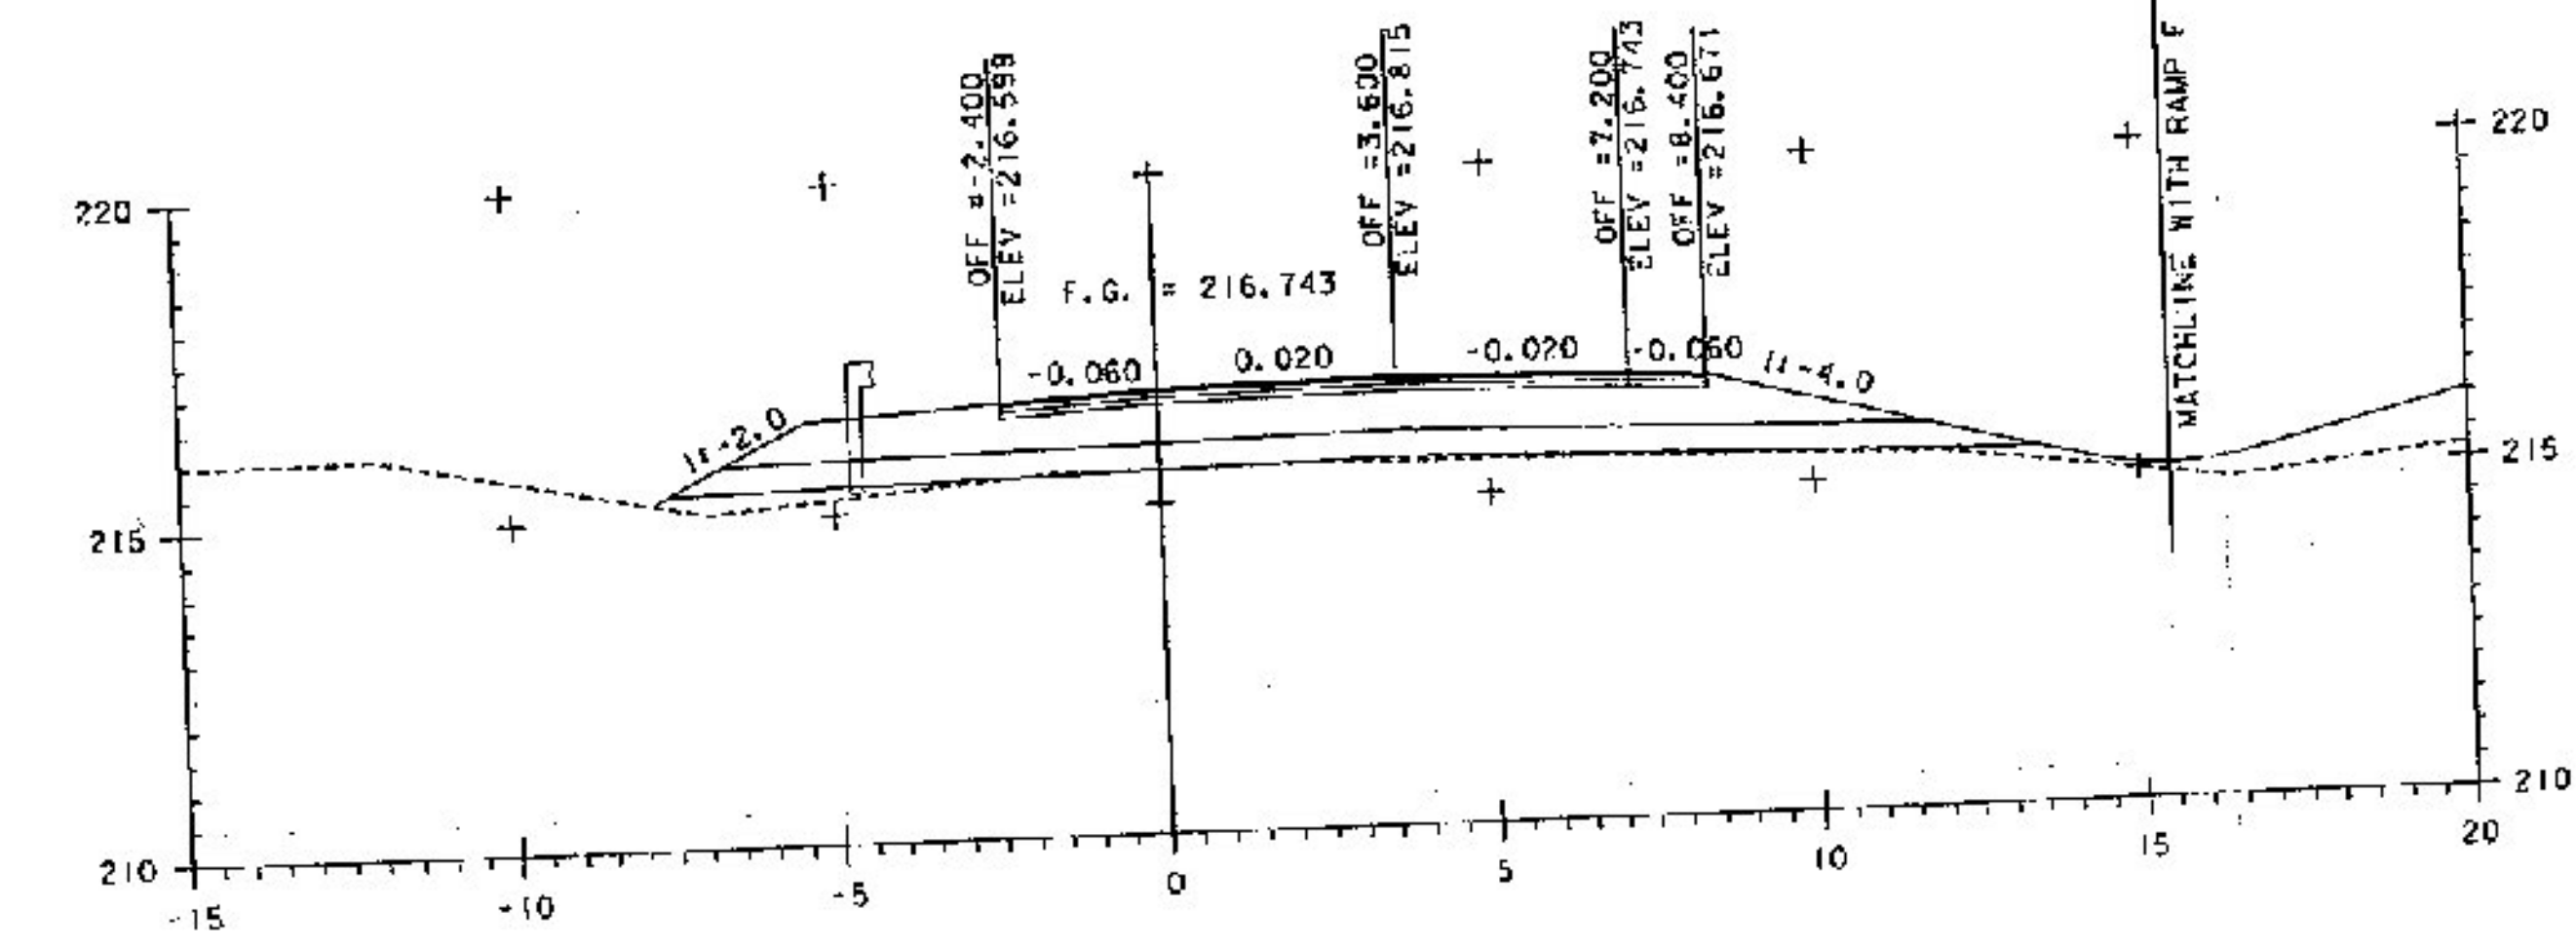


EB 9+720

Added
Guardrail


Record Plans

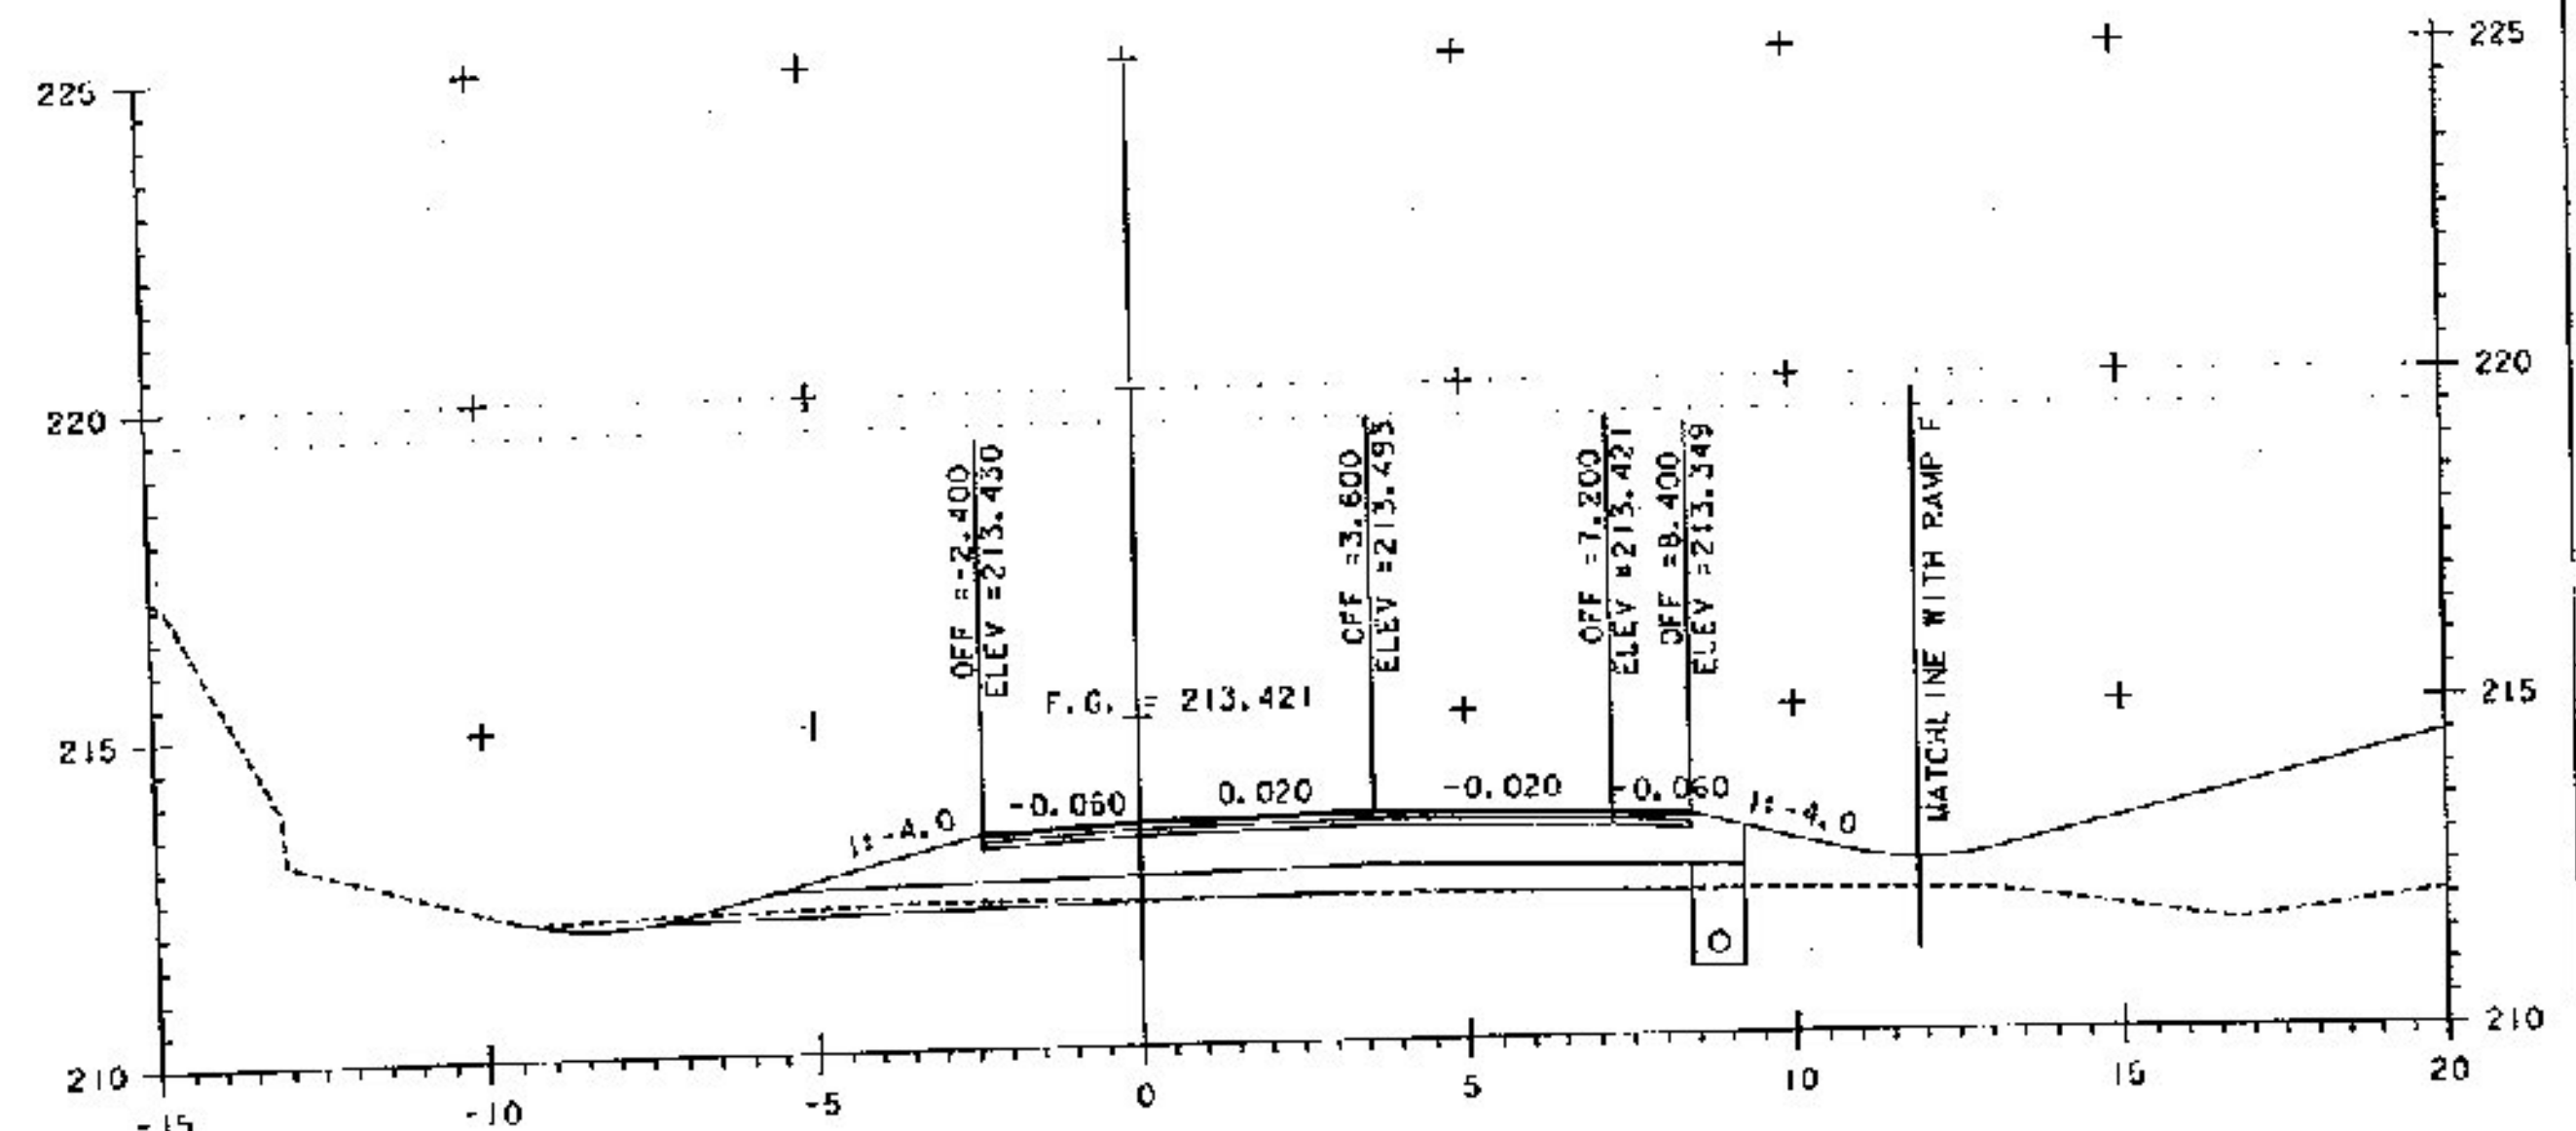

EB 9+800

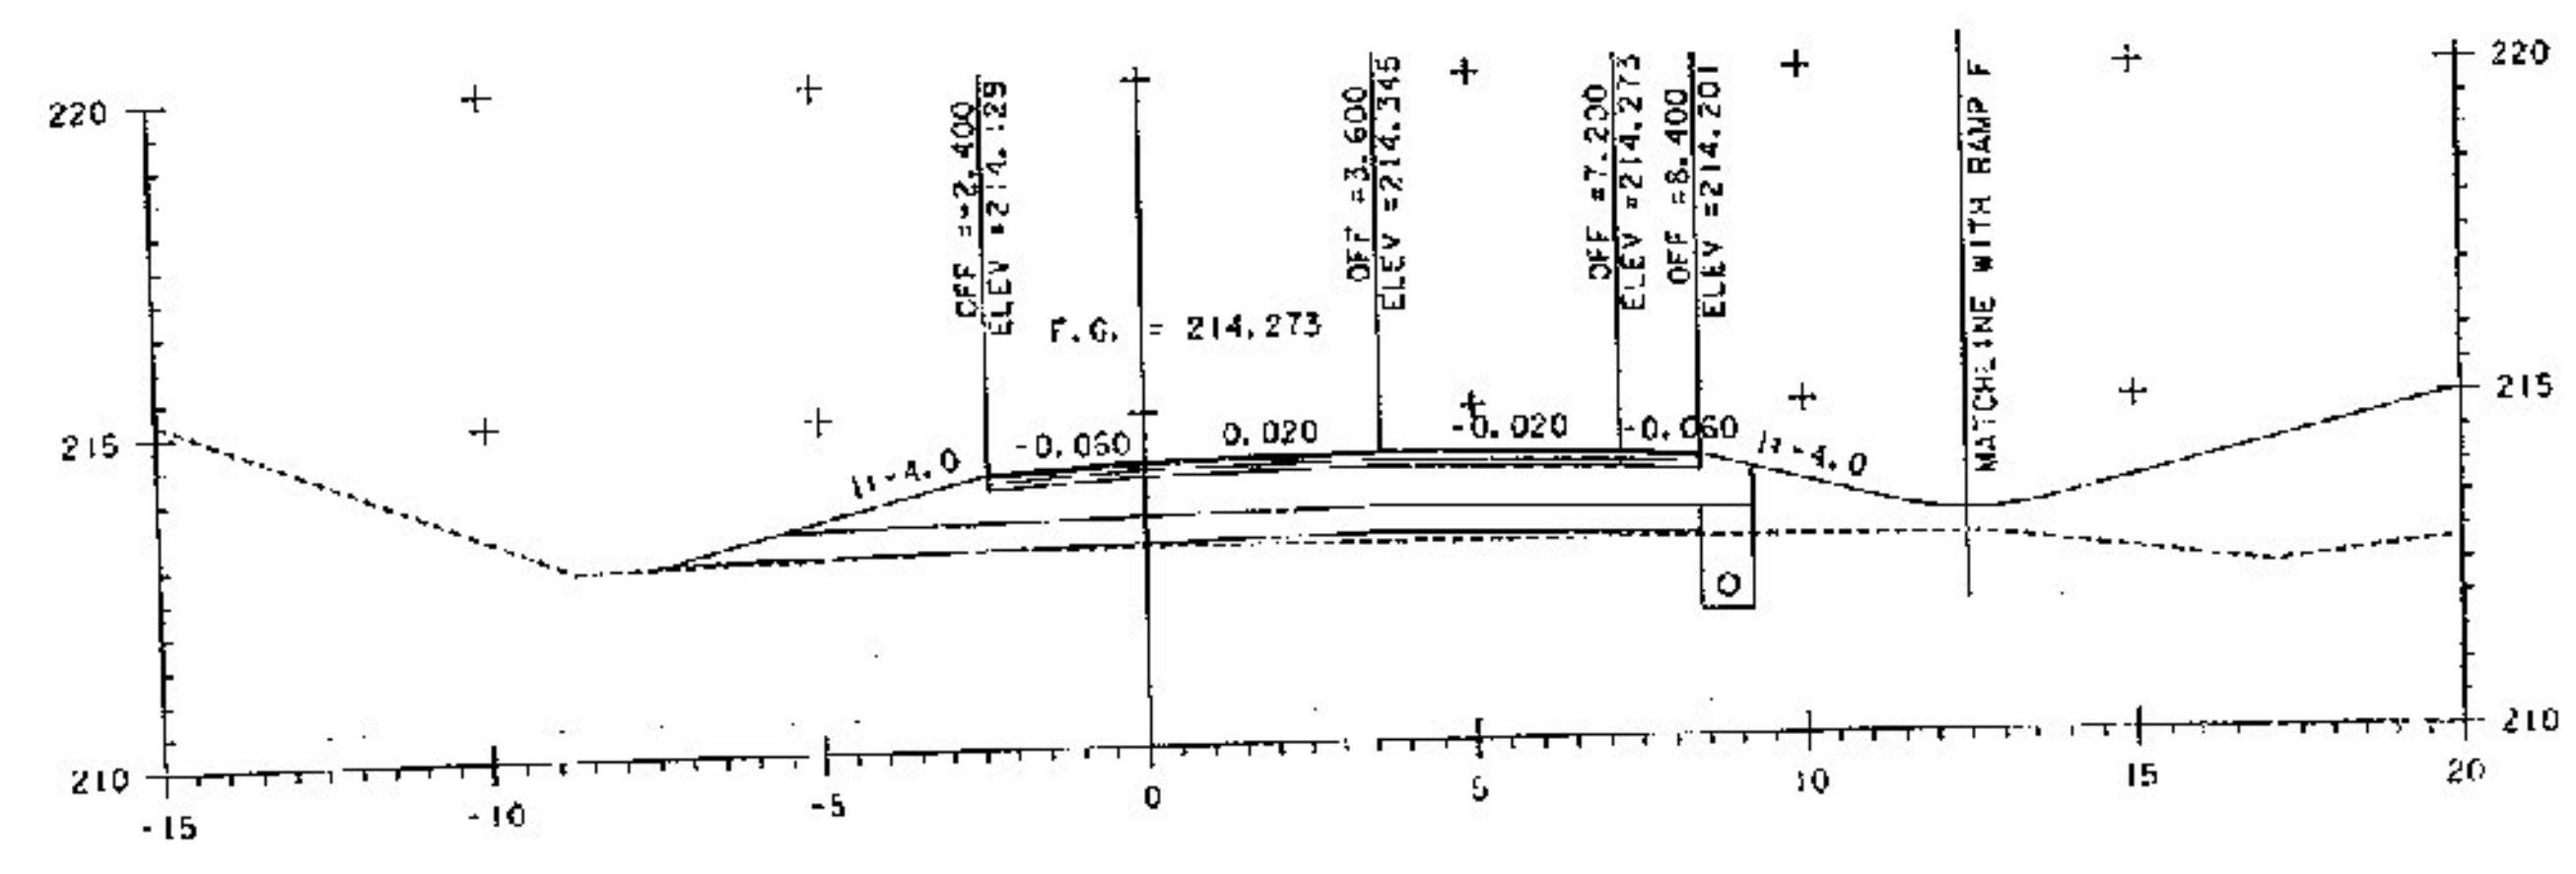

EB 9+780

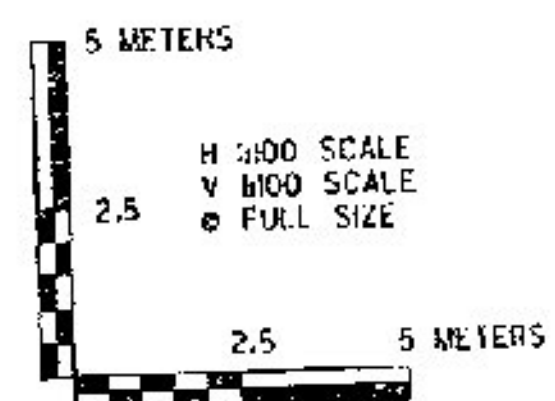

PROJECT NAME:	RENNINGTON
PROJECT NUMBER:	NH 019-1154
FILE NAME:	...plot_fbsevzd307c4ks.279EB.ptf
DESIGN SUPERVISOR:	GREG EDWARDS
DESIGNED BY:	MARC FOISY
VT 279 EB CROSS SECTION:	EBX-02
PLOT DATE:	9/4/2012
DRAWN BY:	STANTEC
CHECKED BY:	CARY SANTY
SHEET:	340 OF 468

GUARDRAIL #4