




EB 10+000

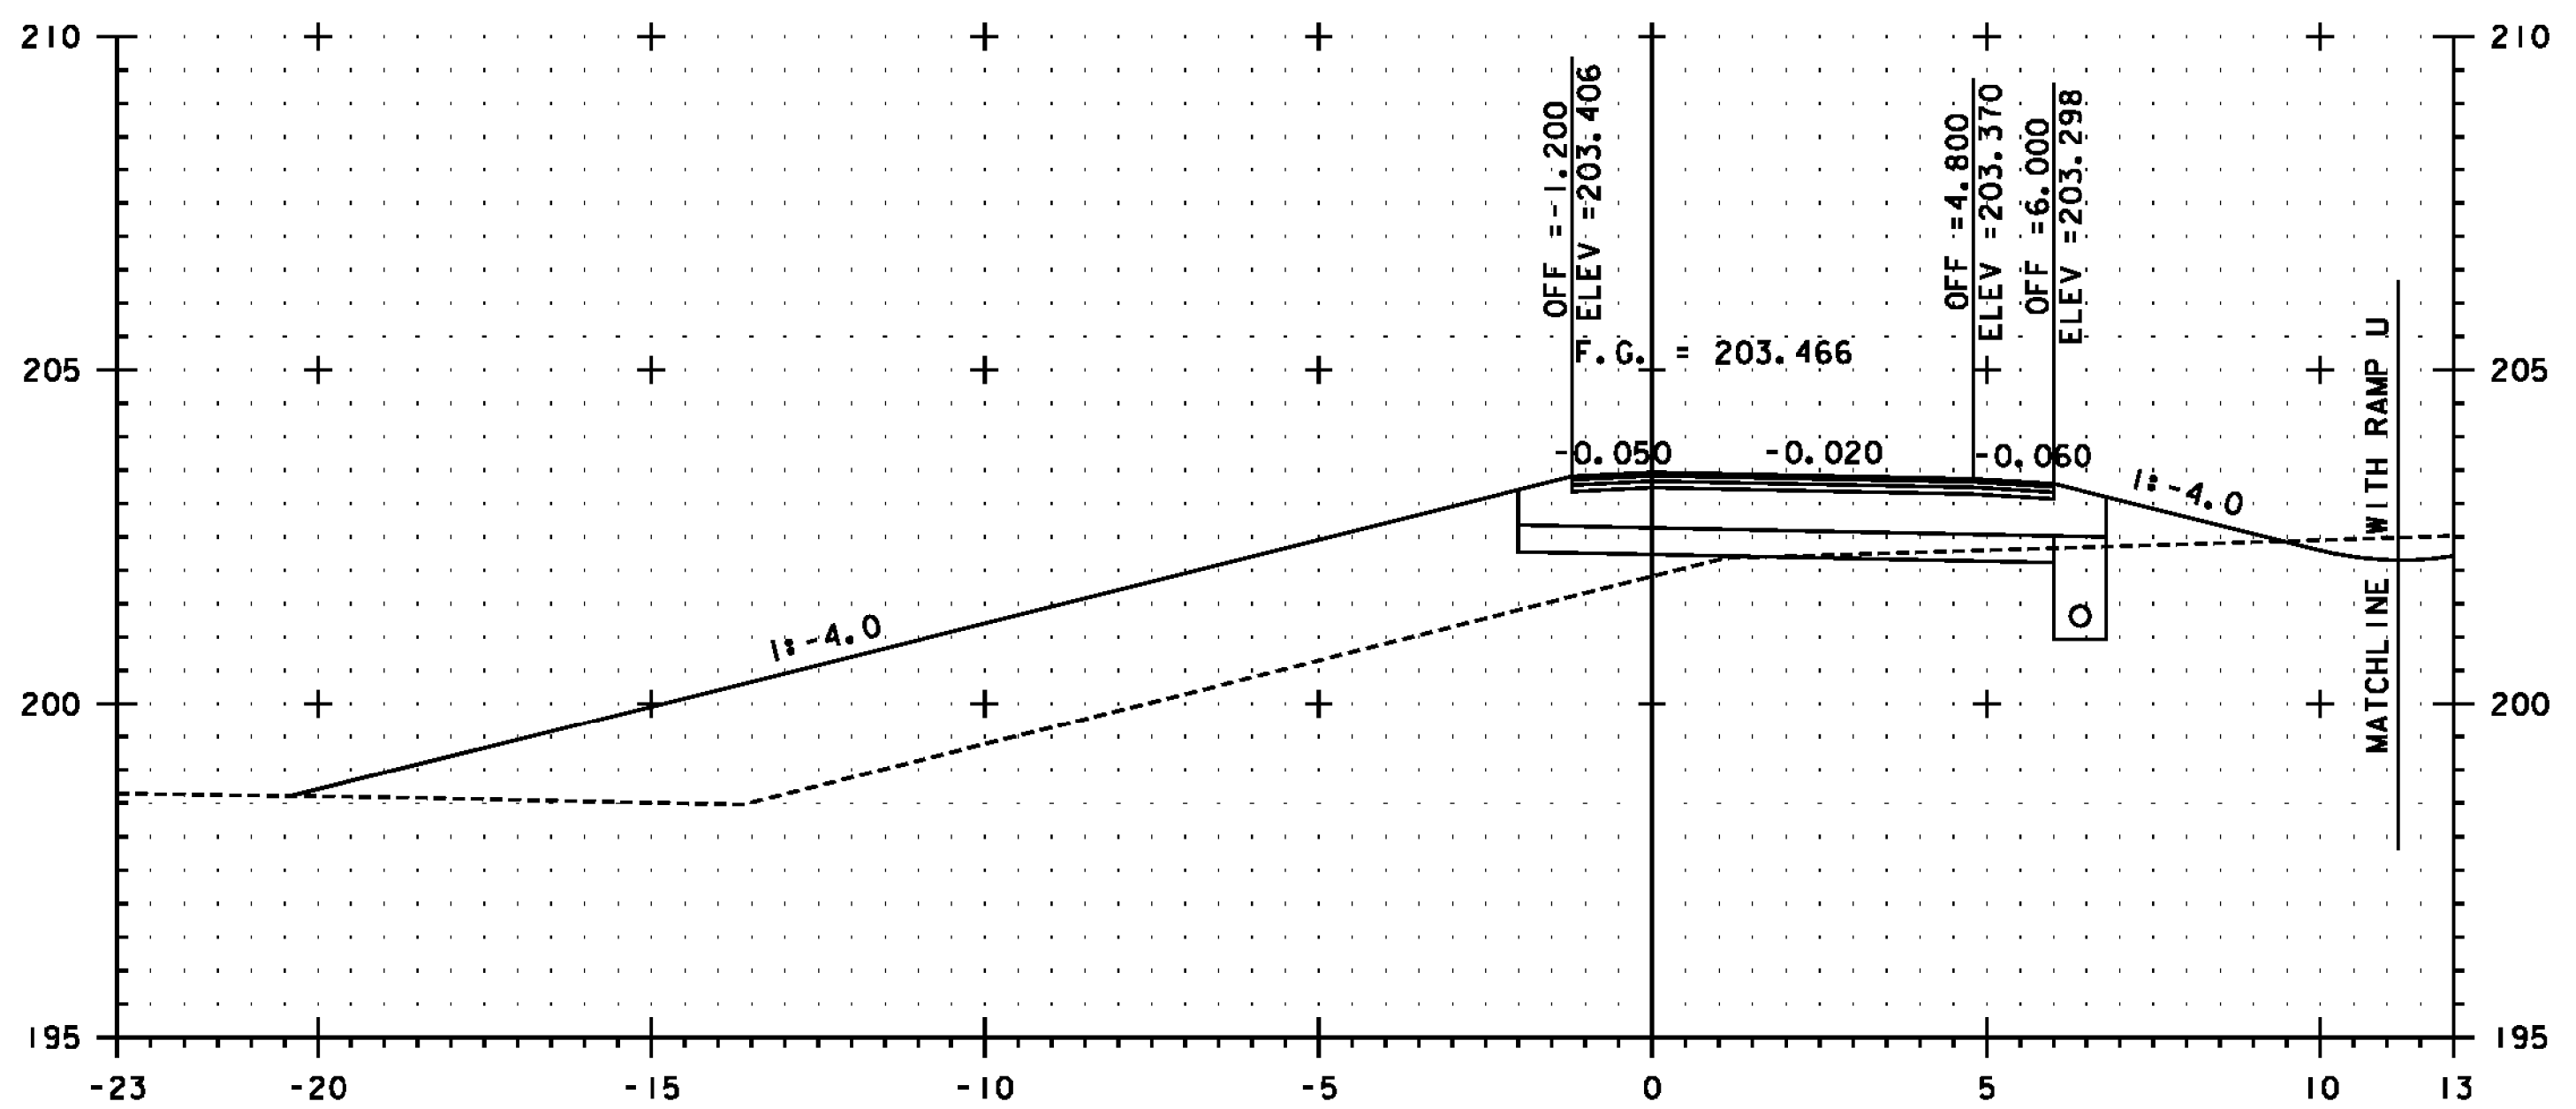

EB 10+040

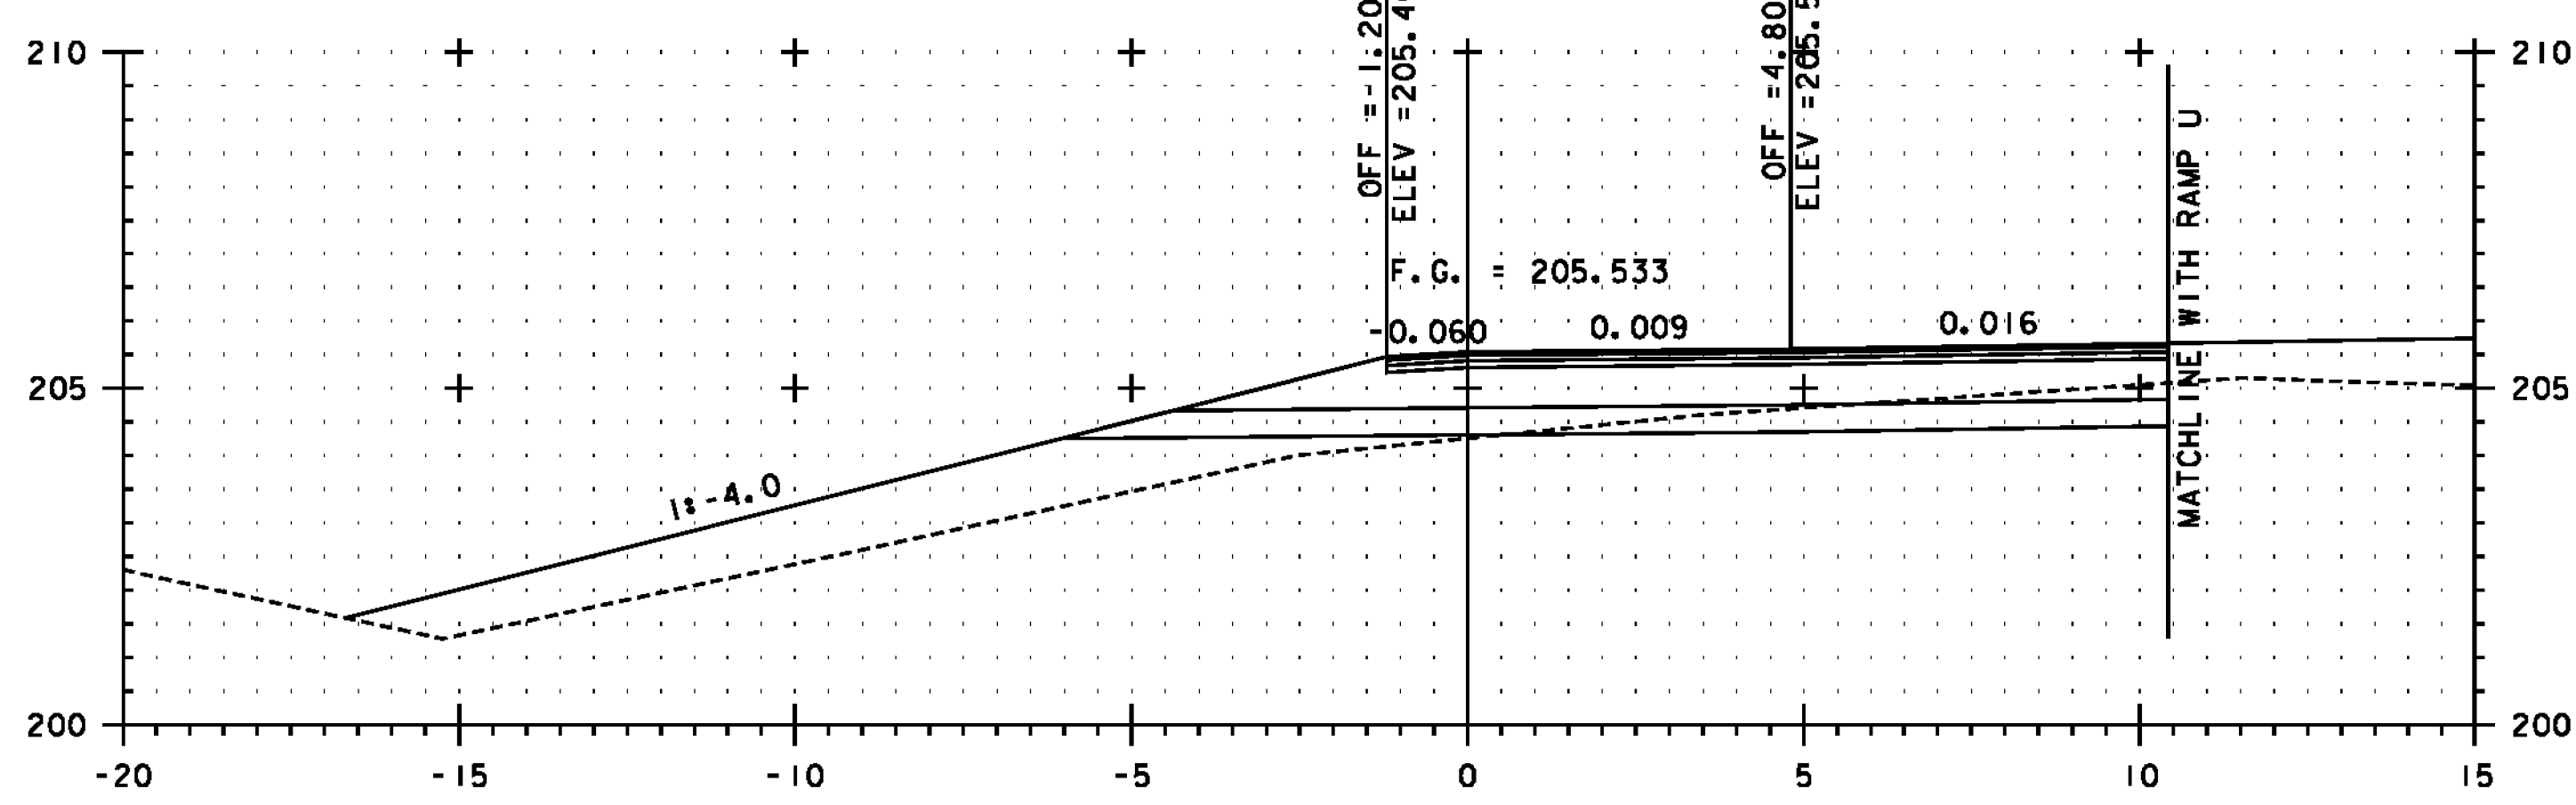


EB 9+980

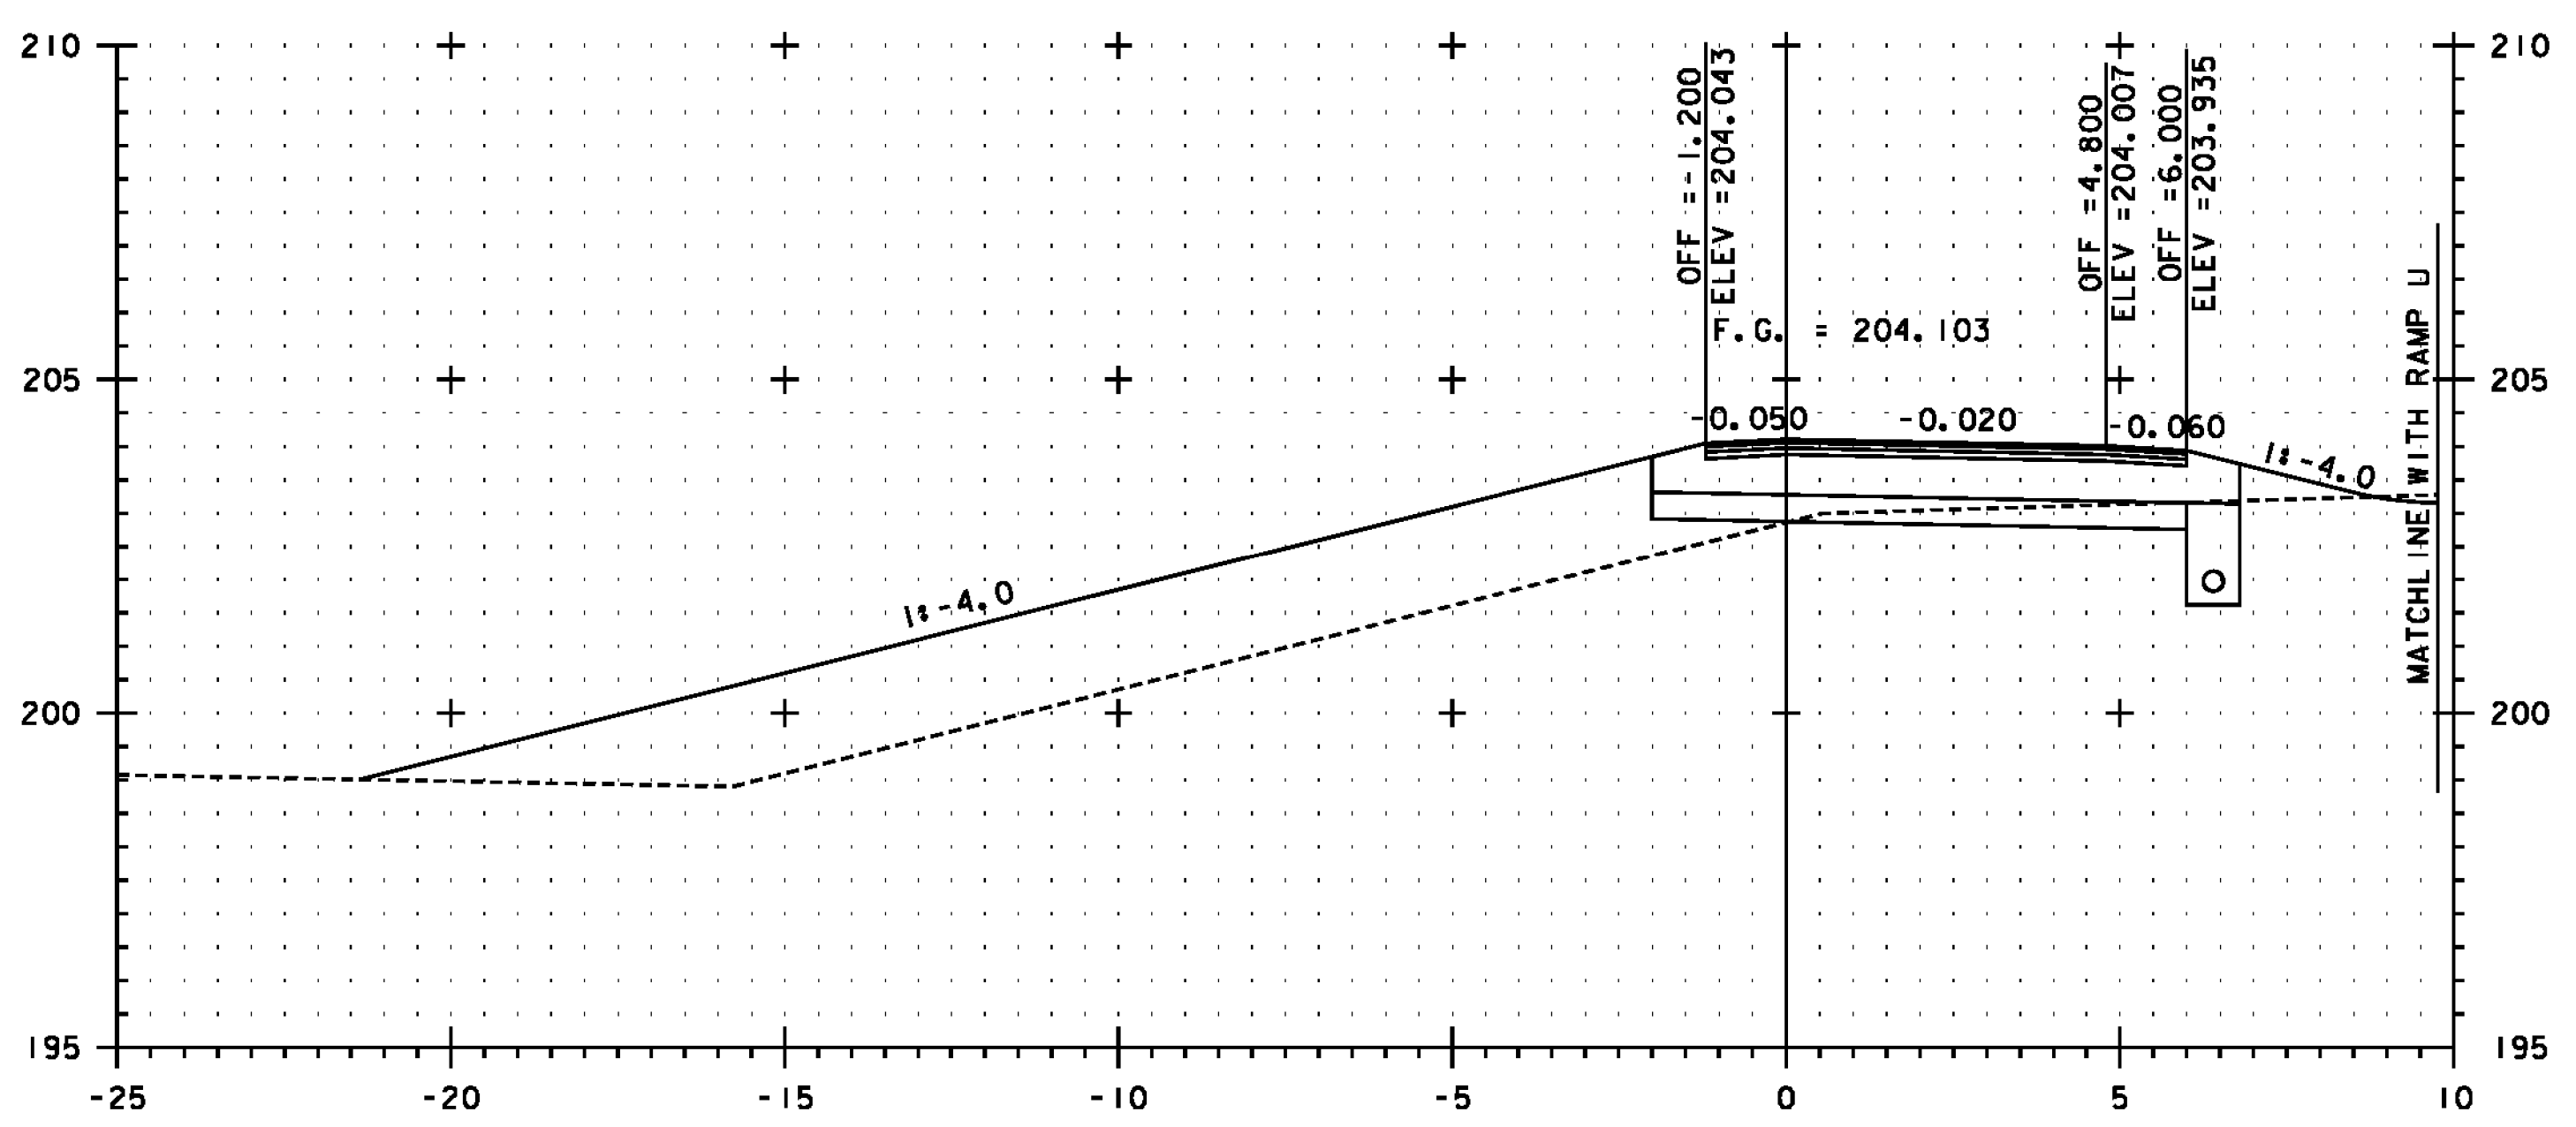

EB 10+020

SEE NOTE ON SHEET 339

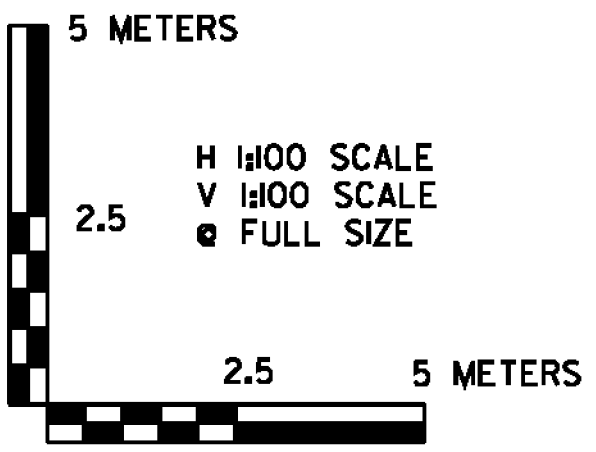

PROJECT NAME:	BENNINGTON
PROJECT NUMBER:	NH 019-(154)
FILE NAME:	...plot_files\zd307c4xs.279EB.ptf
DESIGN SUPERVISOR:	GREG EDWARDS
DESIGNED BY:	MARC FOISY
VT 279 EB CROSS SECTION	EBX-05
PLOT DATE:	1/26/2010
DRAWN BY:	STANTEC
CHECKED BY:	GARY SANTY
SHEET	343 OF 468

1/26/2010 4:56:30 PM v:\1953\getlive\1953\0002\tr\anspor\top\ion\dr\cm\ng\con\tr\cst\_4\p\ot\_files\zd307c4xs.279EB.ptf