

EB 10+080


EB 10+140

EB 10+120

EB 10+060

EB 10+100

SEE NOTE ON SHEET 339

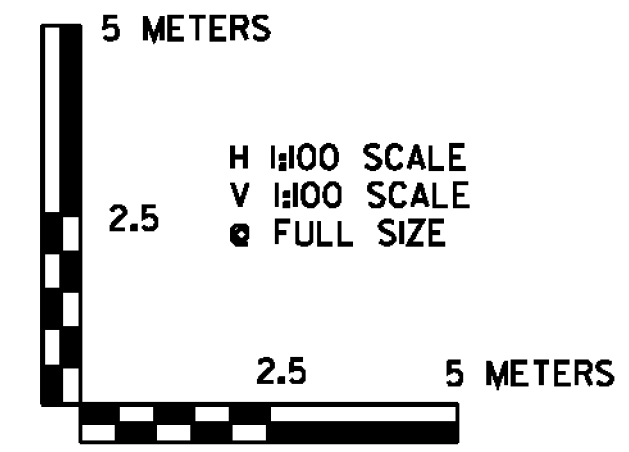

PROJECT NAME: BENNINGTON  
 PROJECT NUMBER: NH 019-(154)

FILE NAME: ...plot\_files\zd307c4xs.279EB.ptf PLOT DATE: 1/26/2010  
 DESIGN SUPERVISOR: GREG EDWARDS DRAWN BY: STANTEC  
 DESIGNED BY: MARC FOISY CHECKED BY: GARY SANTY  
 VT 279 EB CROSS SECTION EBX-06 SHEET 344 OF 468

1/26/2010 4:56:31 PM v:\1953\getlive\19530002\tr\anspor\ref\ion\dr\w\ng\com\tr\cp\4\plot\_files\zd307c4xs.279EB.ptf