


SEE NOTE ON SHEET 339

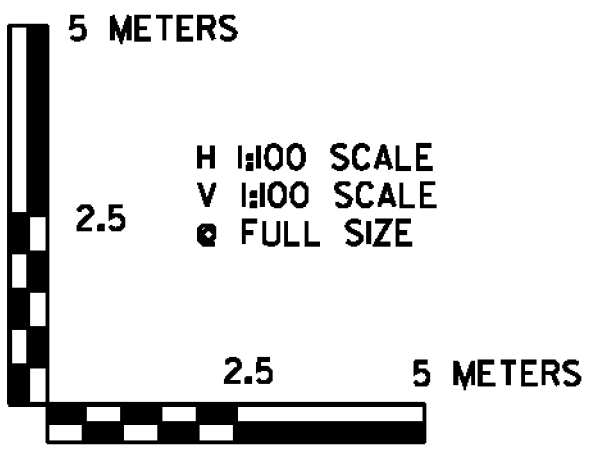

PROJECT NAME:	BENNINGTON
PROJECT NUMBER:	NH 019-(154)
FILE NAME:	...plot_files\zd307c4xs.279EB.ptf
DESIGN SUPERVISOR:	GREG EDWARDS
DESIGNED BY:	MARC FOISY
VT 279 EB CROSS SECTION	EBX-07
PLOT DATE:	1/26/2010
DRAWN BY:	STANTEC
CHECKED BY:	GARY SANTY
SHEET	345 OF 468

1/26/2010 4:56:32 PM V:\1953\getlive\19530002\tr\anspor\ref10n\dr\cm\ng\com\tr\cp1_4\p101_files\z307c4xs.279EB.ptf