




EB 10+520

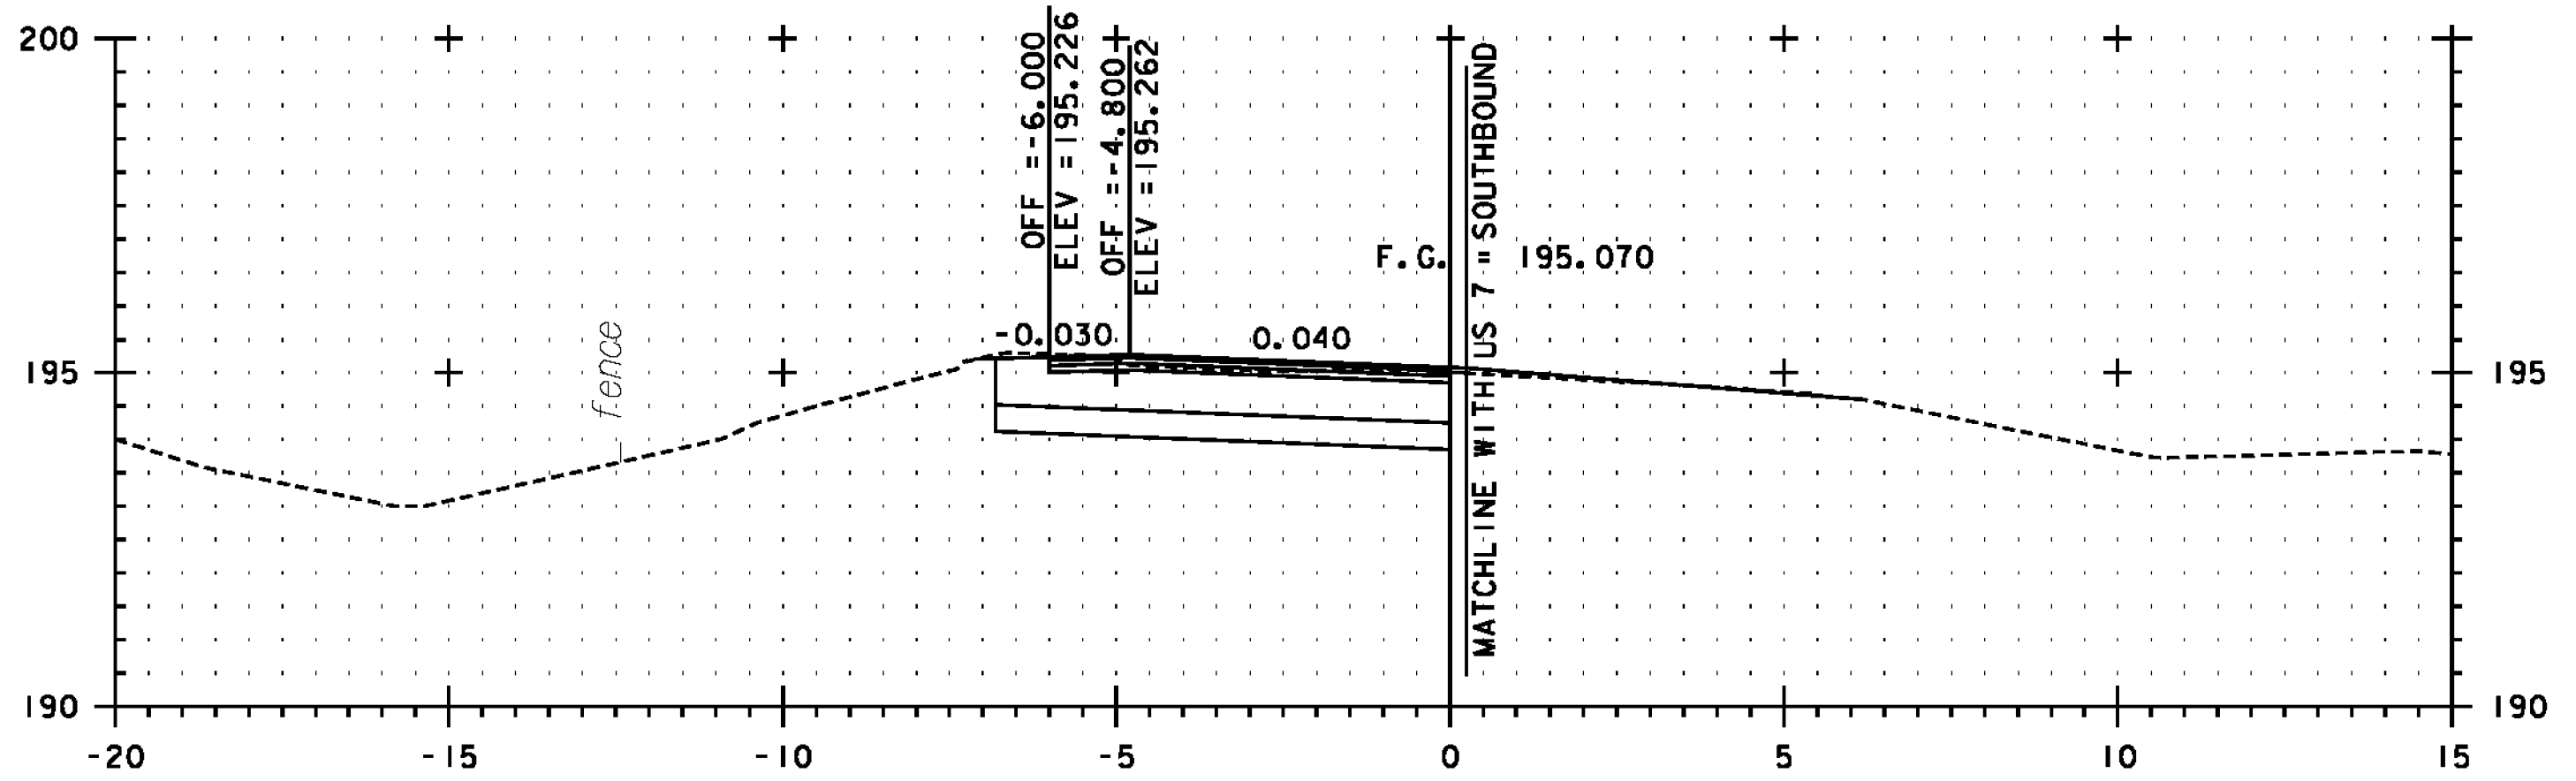


EB 10+567.592 = SB 10+567.592

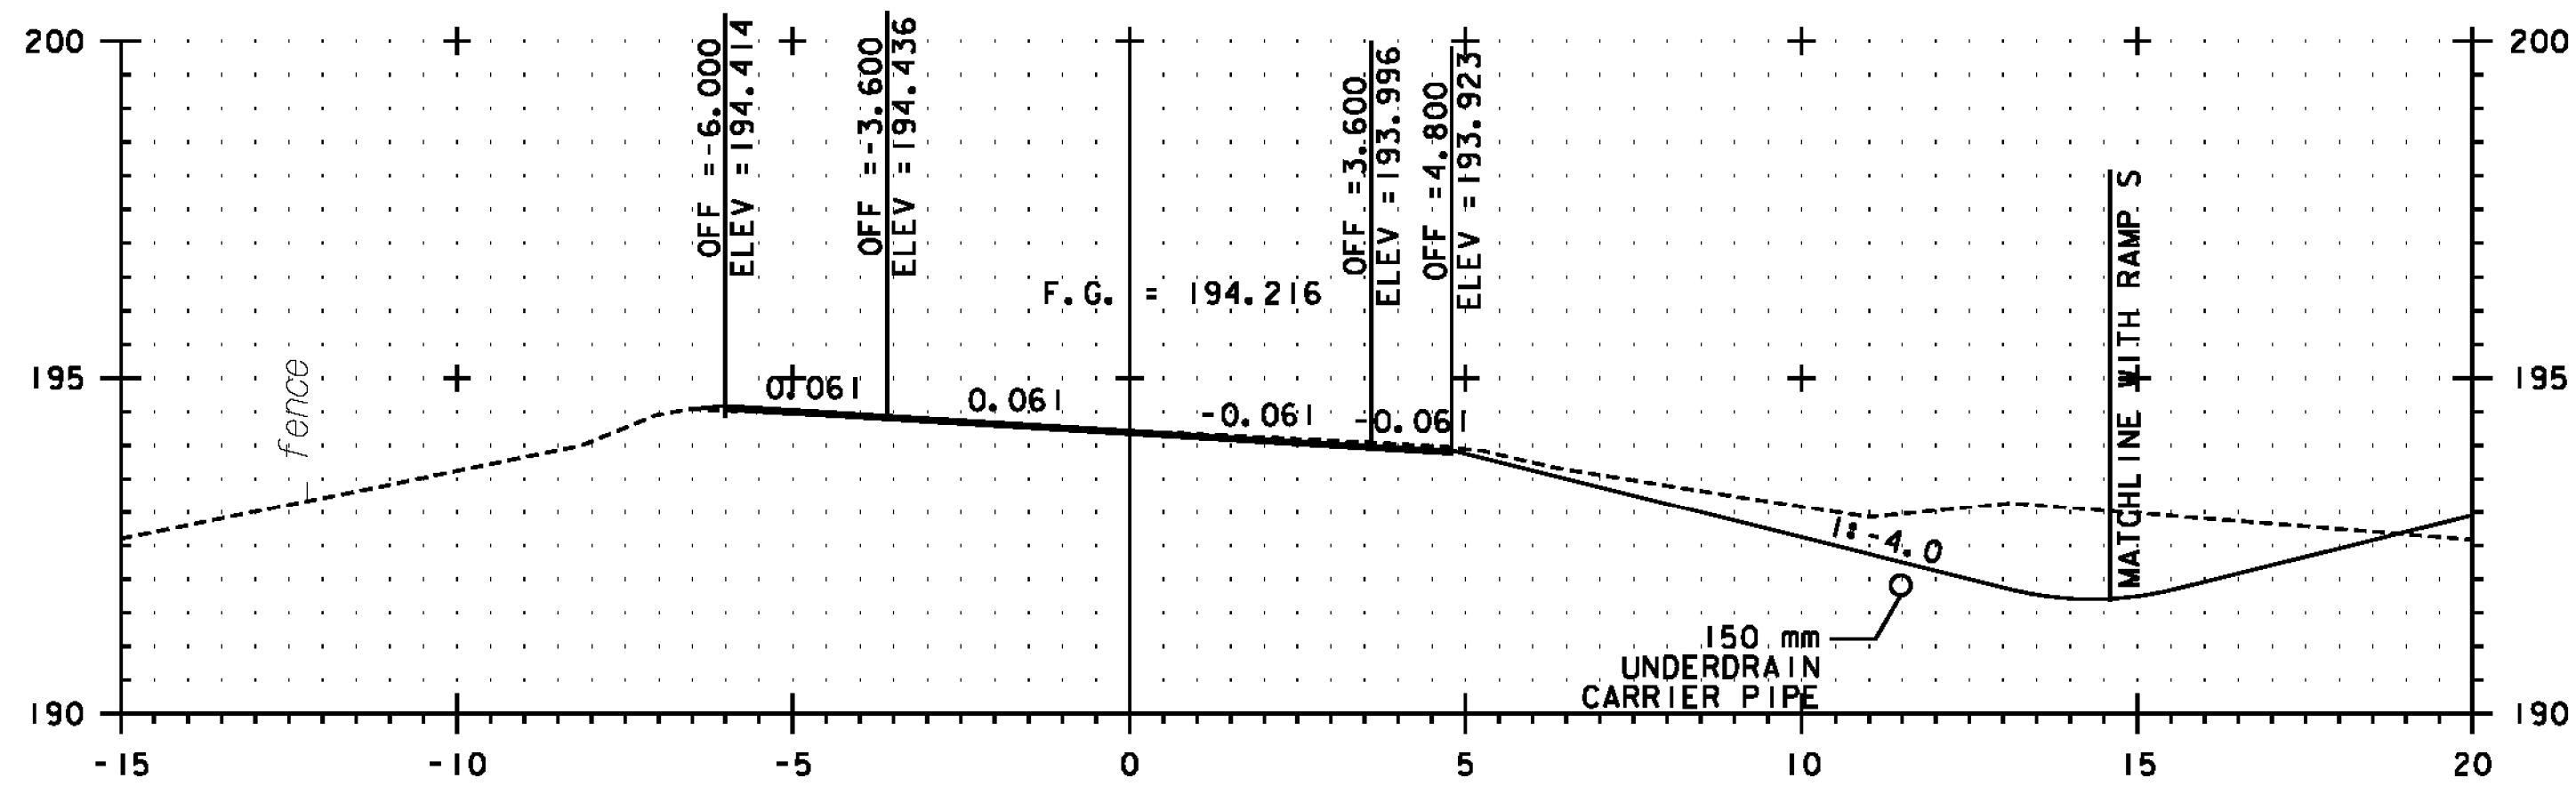


EB 10+500

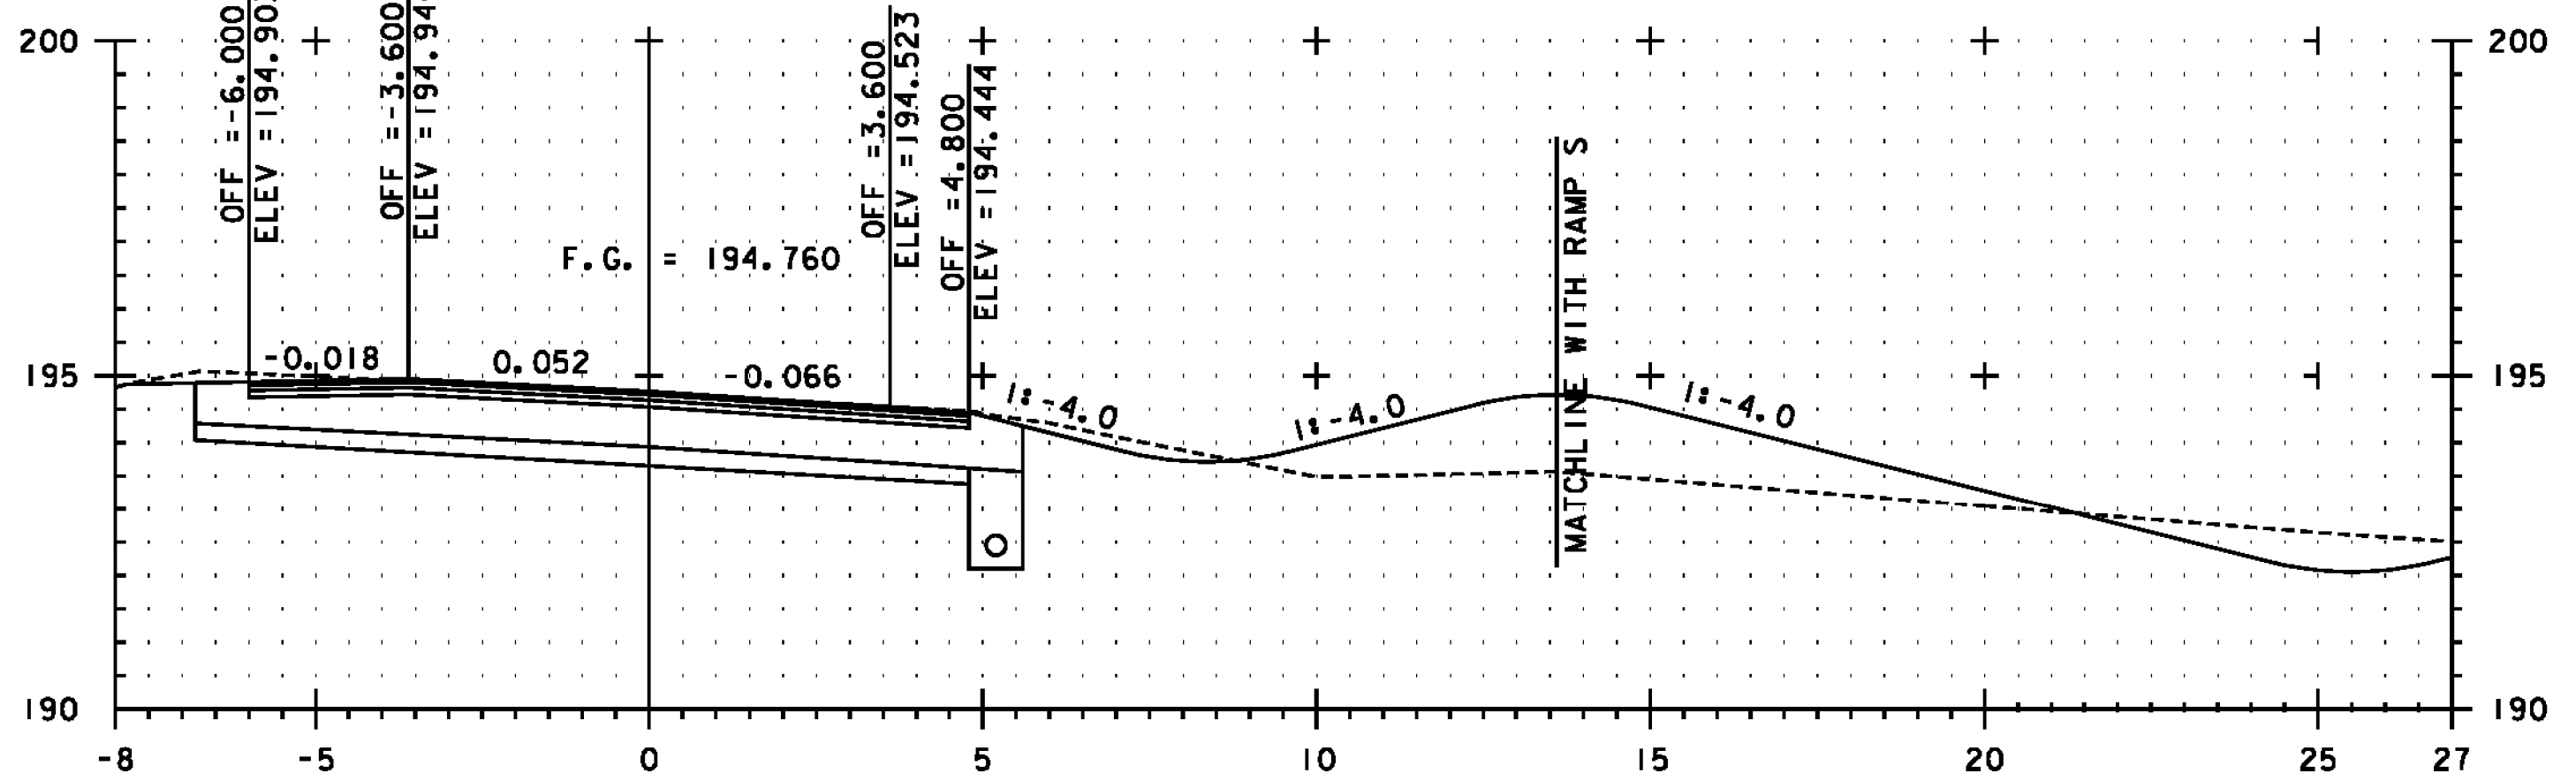

EB 10+560

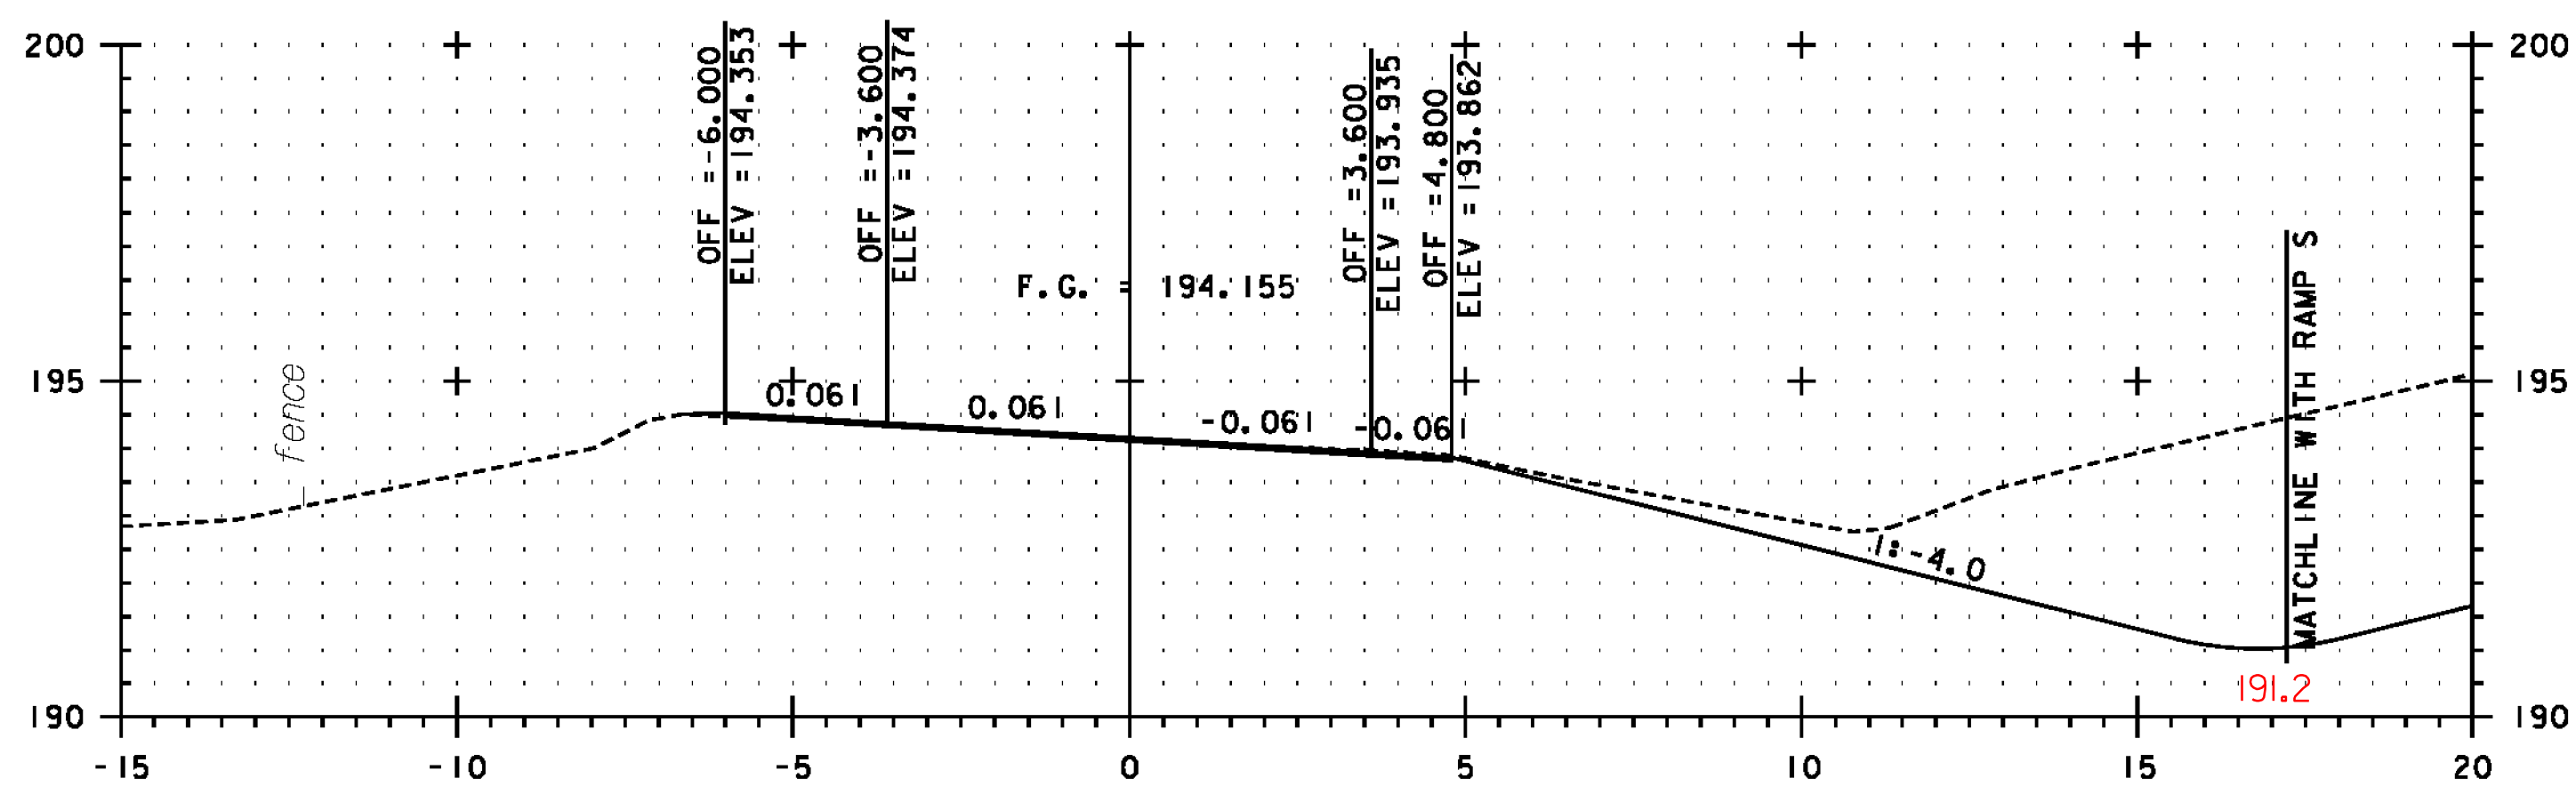


EB 10+480

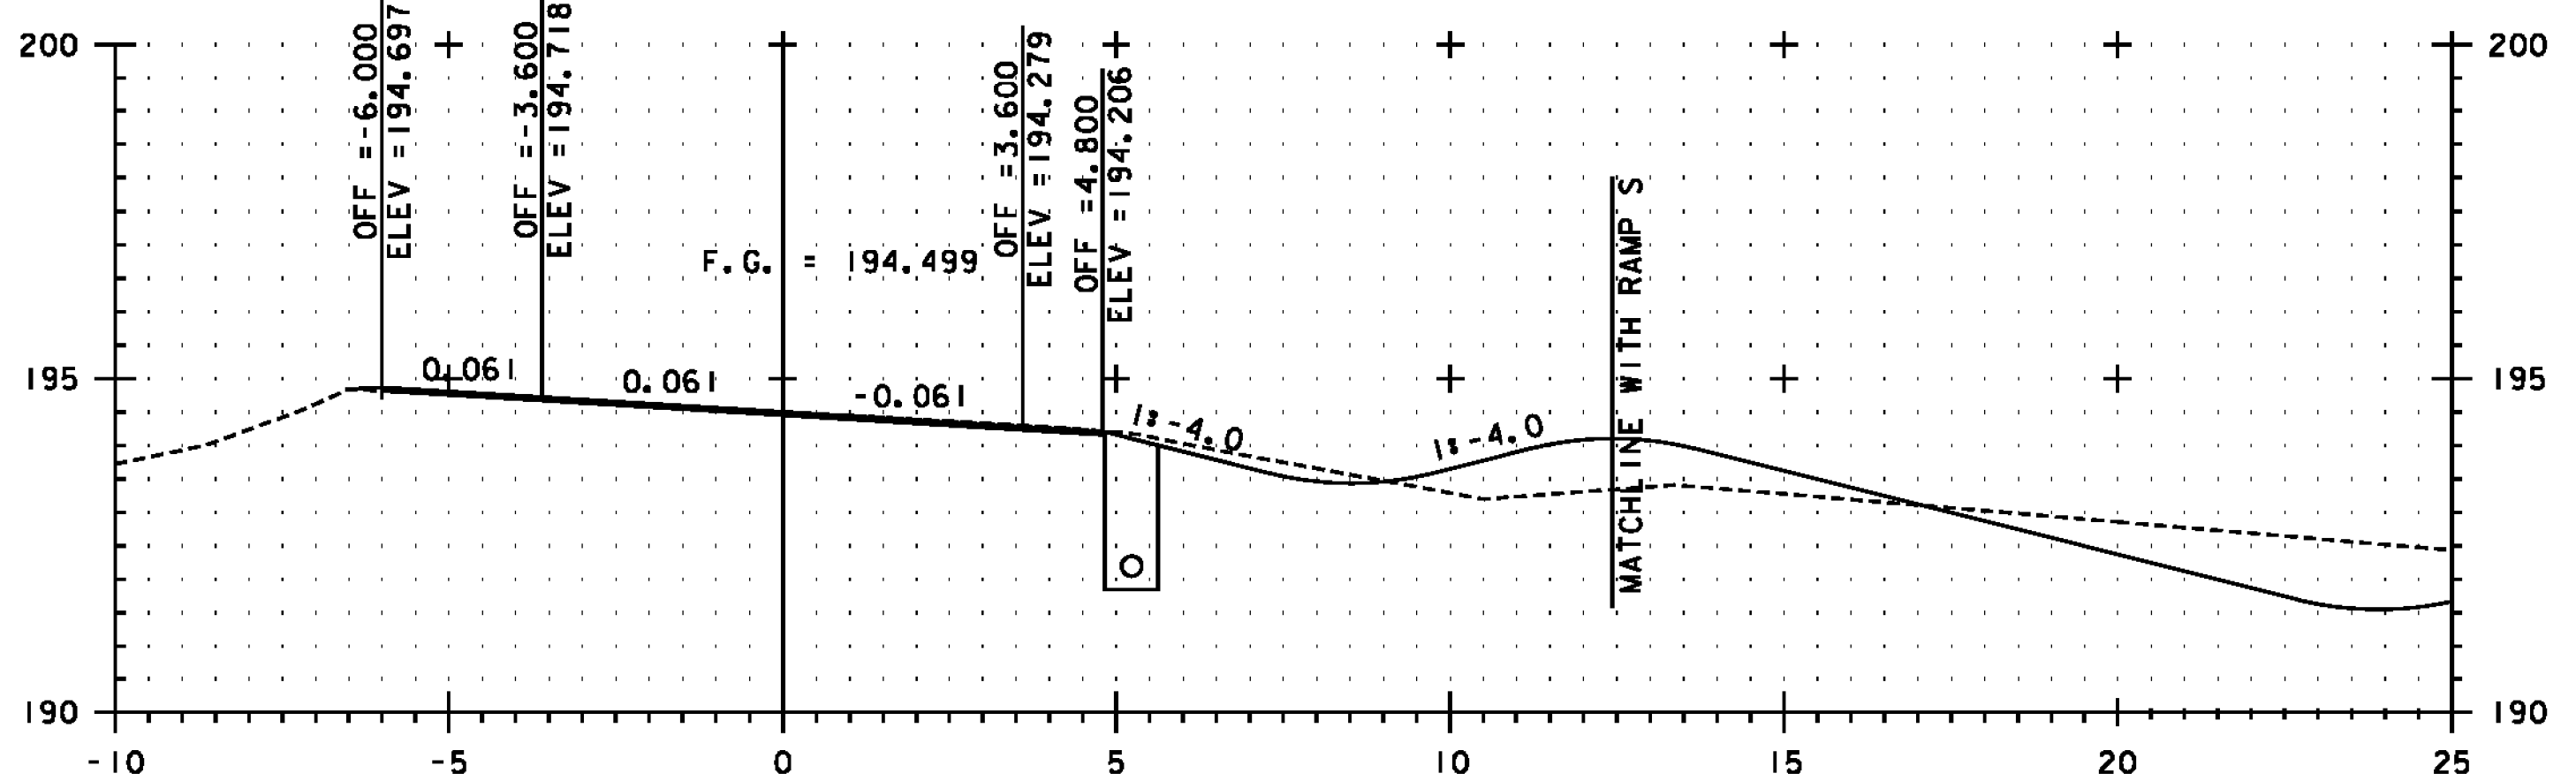

EB 10+540

SEE NOTE ON SHEET 339

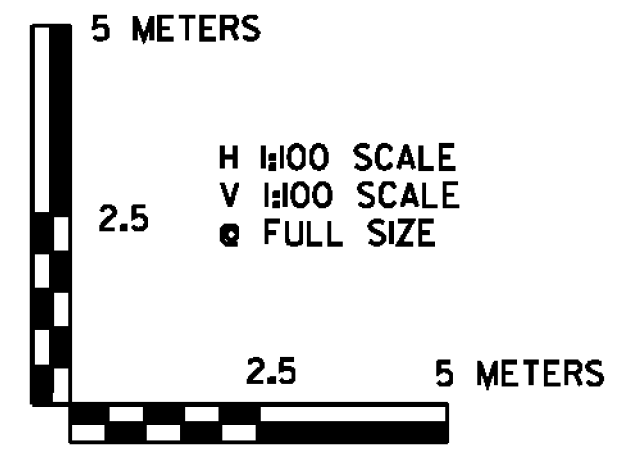

PROJECT NAME:	BENNINGTON
PROJECT NUMBER:	NH 019-(154)
FILE NAME:	...plot_files\zd307c4xs.279EB.ptf
DESIGN SUPERVISOR:	GREG EDWARDS
DESIGNED BY:	MARC FOISY
VT 279 EB CROSS SECTION	EBX-11
PLOT DATE:	1/26/2010
DRAWN BY:	STANTEC
CHECKED BY:	GARY SANTY
SHEET	349 OF 468

1/26/2010 4:56:36 PM v:\1953\getlive\19530002\tr\anspor\101101\dr\cm\ng\com\tr\cp1_4\p101_files\z307c4xs.279EB.ptf