


SEE NOTE ON SHEET 339

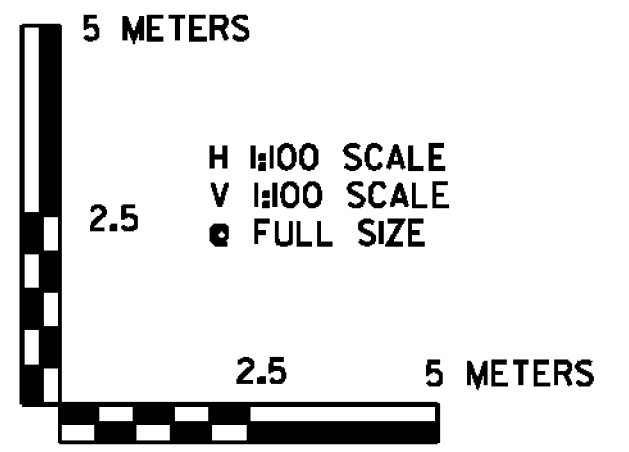

PROJECT NAME:	BENNINGTON
PROJECT NUMBER:	NH 019-(154)
FILE NAME:	...plot_files\zd307c4xs.279EB.ptf
DESIGN SUPERVISOR:	GREG EDWARDS
DESIGNED BY:	MARC FOISY
VT 279 EB CROSS SECTION	EBX-12
PLOT DATE:	1/26/2010
DRAWN BY:	STANTEC
CHECKED BY:	GARY SANTY
SHEET	350 OF 468

1/26/2010 4:56:38 PM v:\1953\getlive\19530002\transport\101\dr\dwg\confr\cp1_4\plot_files\zd307c4xs.279EB.ptf