


SEE NOTE ON SHEET 339

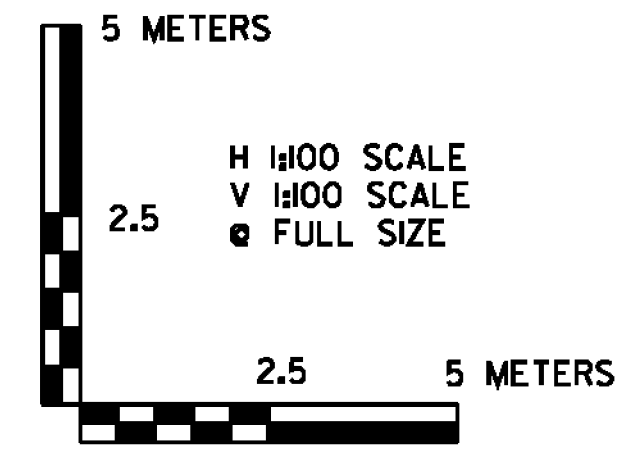

|                         |                                     |
|-------------------------|-------------------------------------|
| PROJECT NAME:           | BENNINGTON                          |
| PROJECT NUMBER:         | NH 019-(154)                        |
| FILE NAME:              | ...\\plot_files\zd307c4xs.279EB.ptf |
| DESIGN SUPERVISOR:      | GREG EDWARDS                        |
| DESIGNED BY:            | MARC FOISY                          |
| VT 279 EB CROSS SECTION | EBX-13                              |
| PLOT DATE:              | 1/26/2010                           |
| DRAWN BY:               | STANTEC                             |
| CHECKED BY:             | GARY SANTY                          |
| SHEET                   | 351 OF 468                          |

1/26/2010 4:56:39 PM v:\1953\getlive\19530002\transport\101\dr\cm\ng\com\tr\cst\4\plot\_files\zd307c4xs.279EB.ptf