




EB 10+840

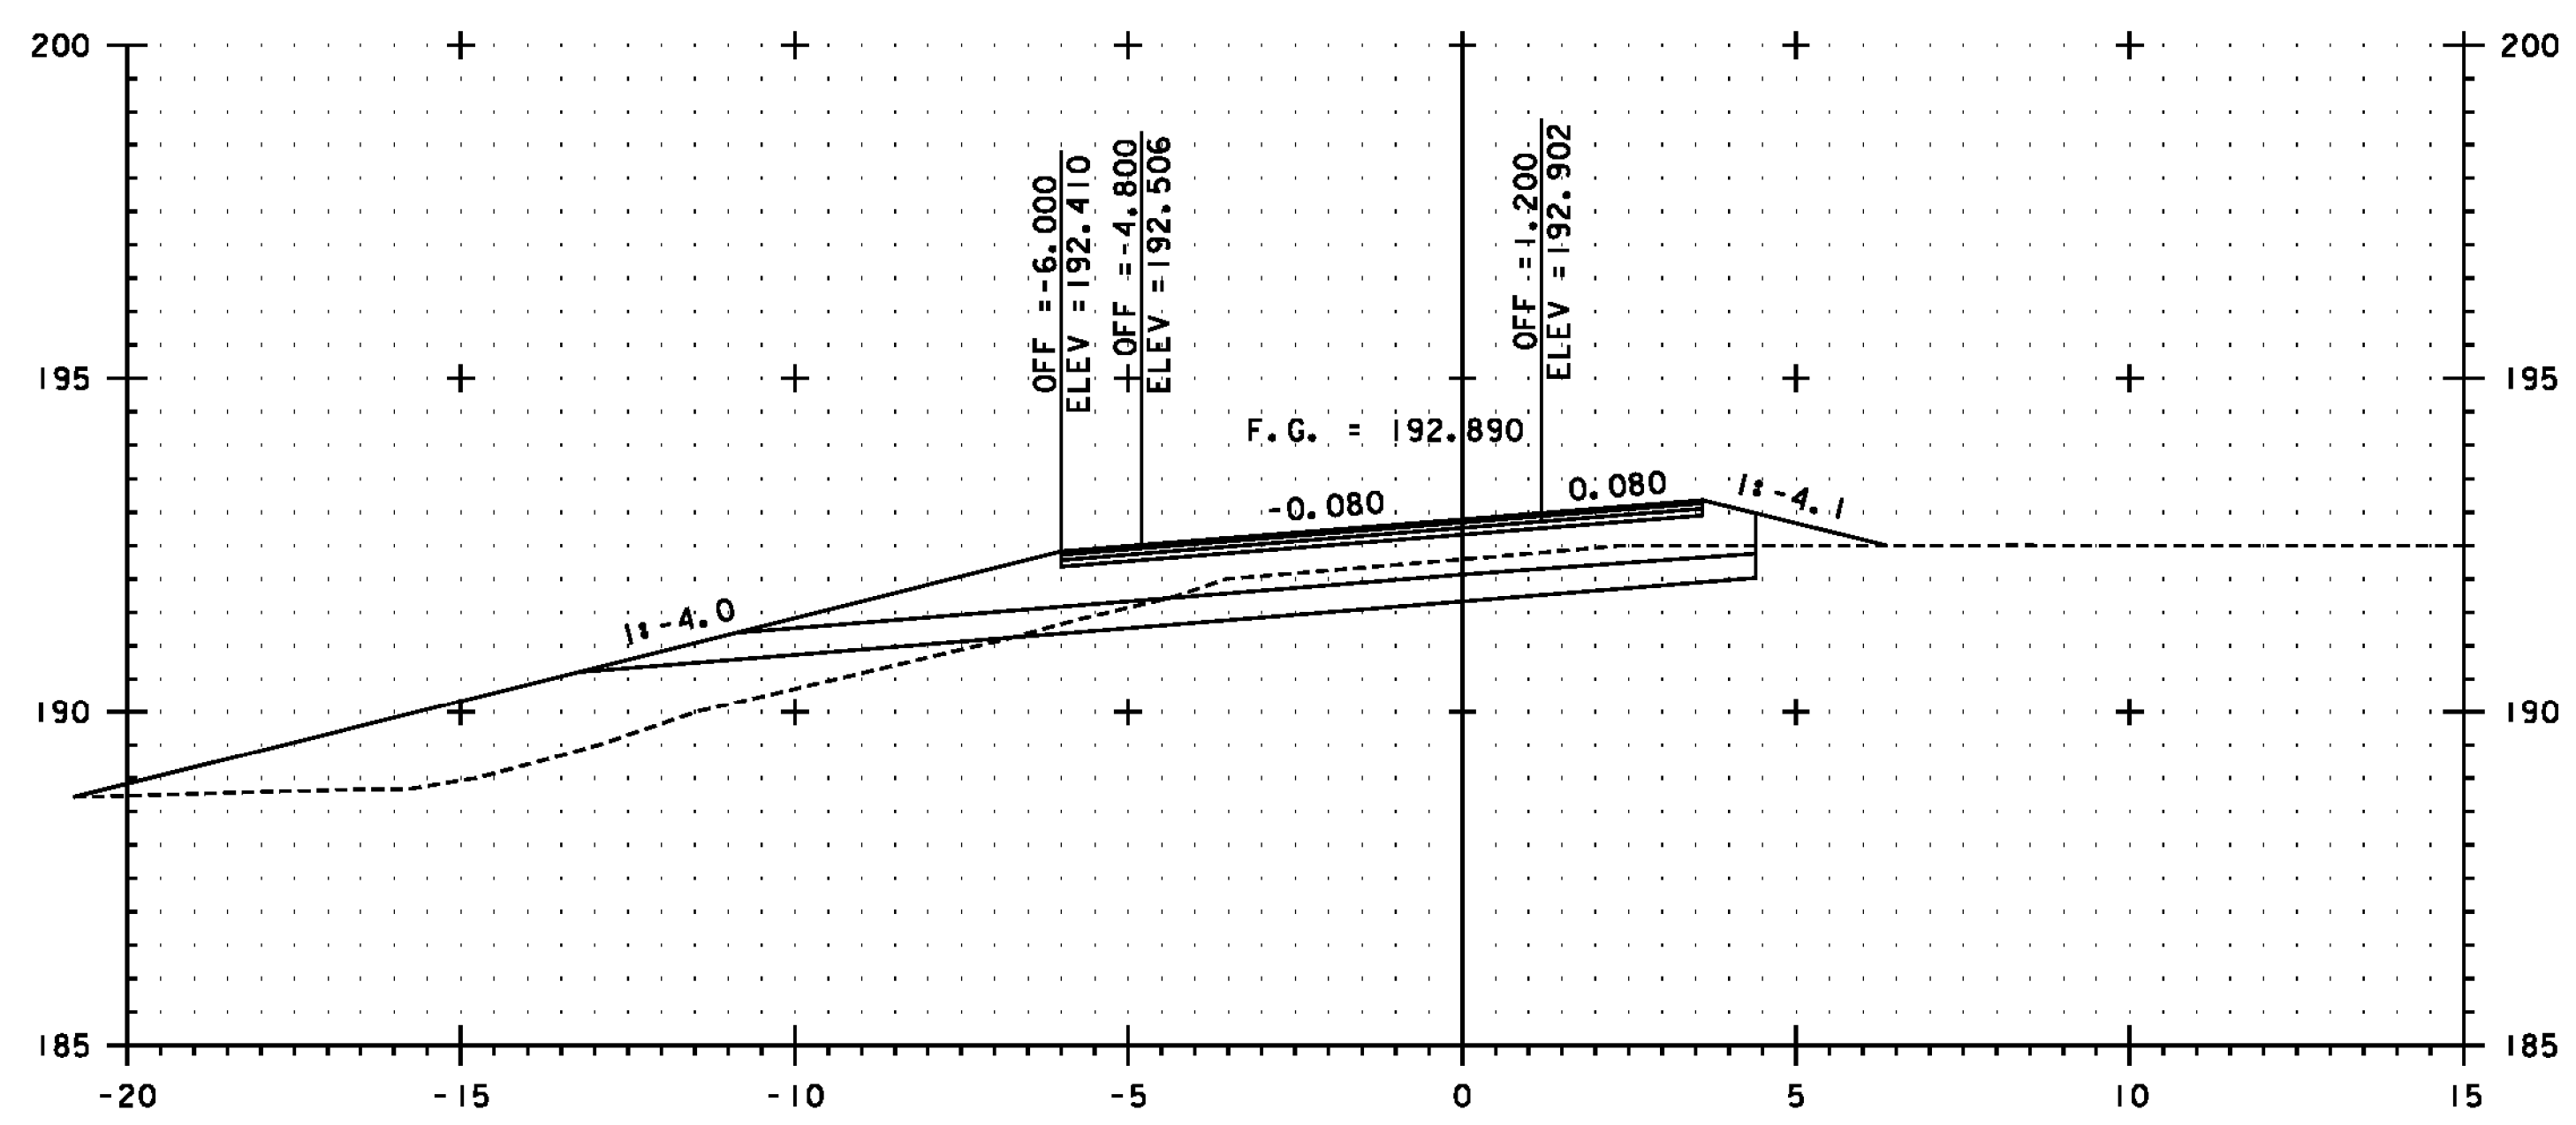

EB 10+880

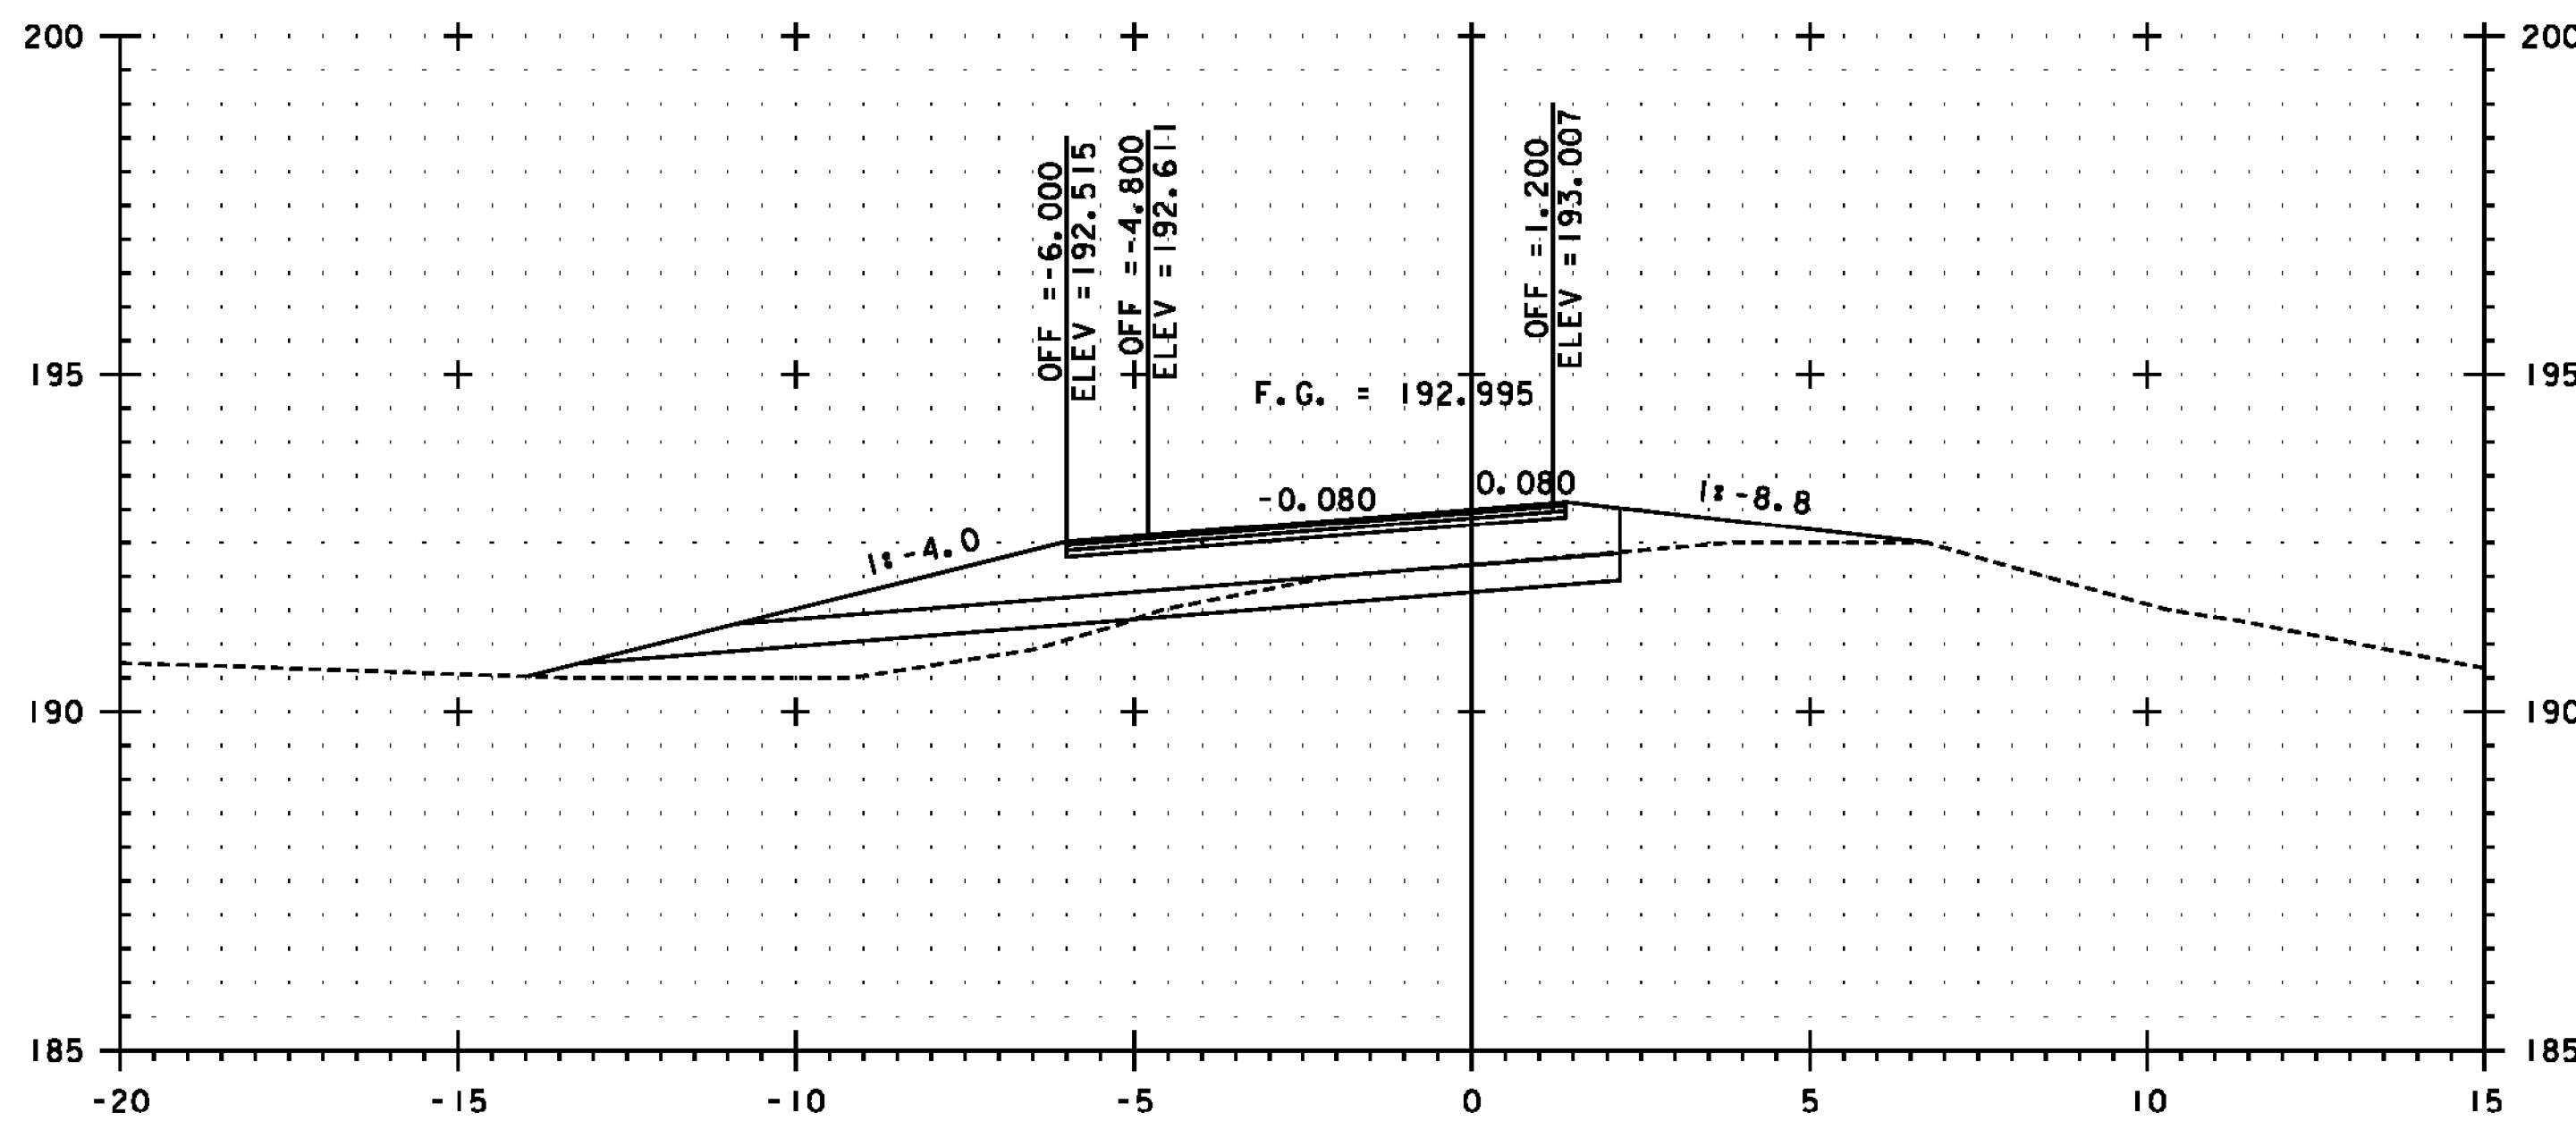


EB 10+820

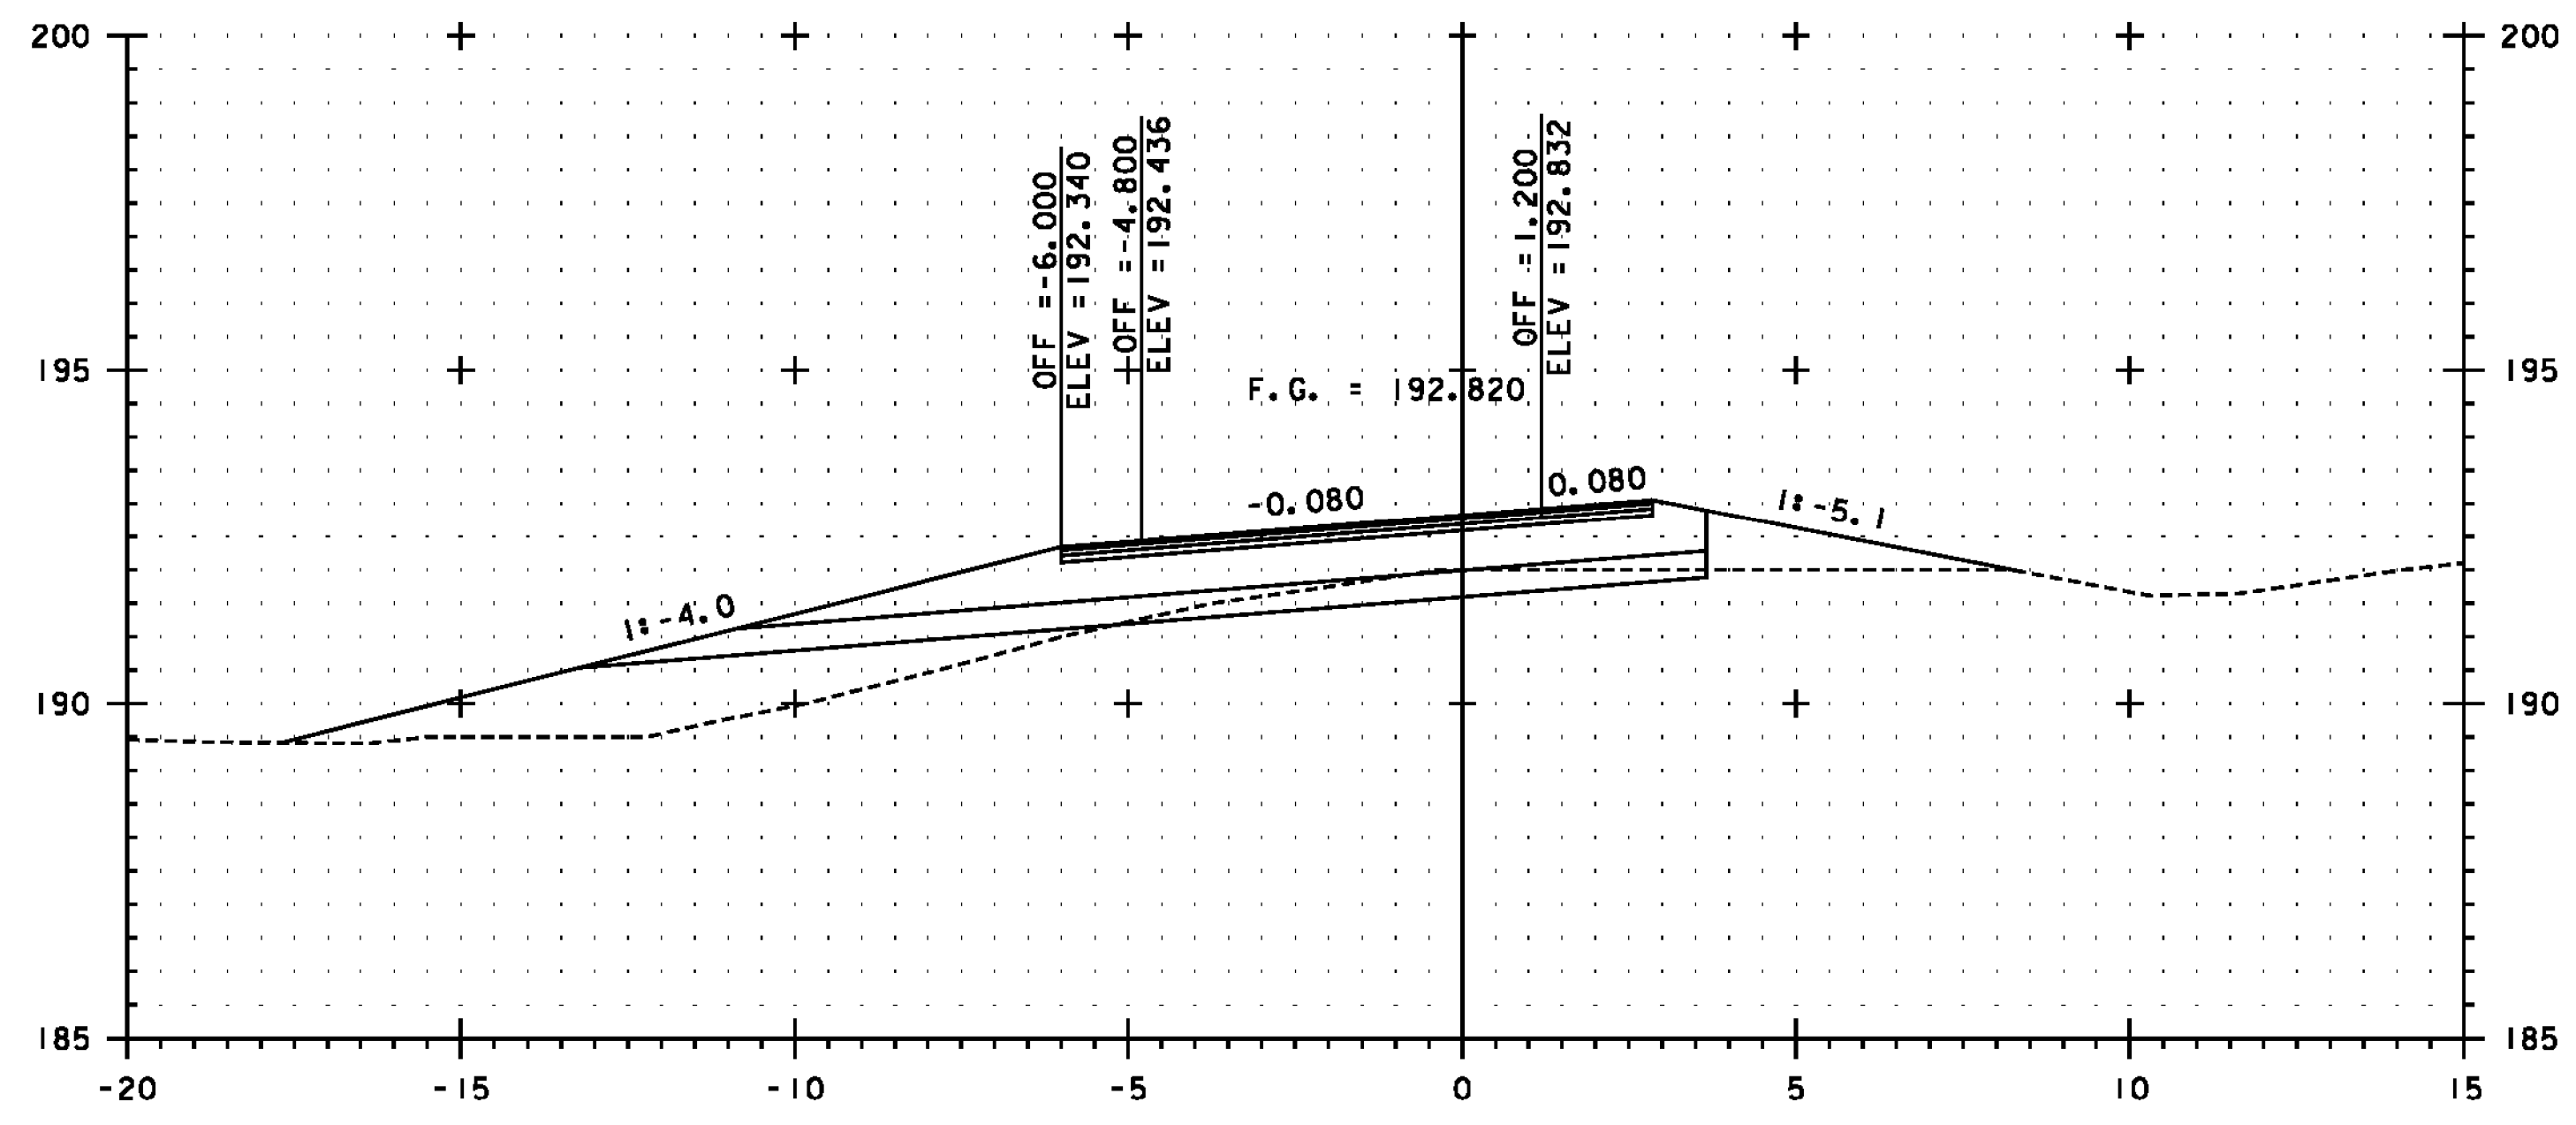

EB 10+860

SEE NOTE ON SHEET 339

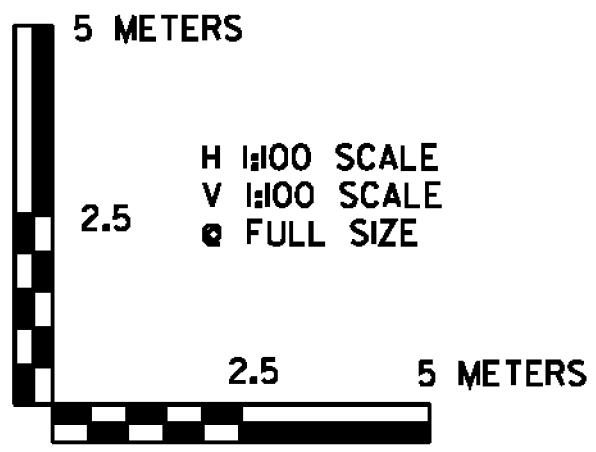

PROJECT NAME:	BENNINGTON
PROJECT NUMBER:	NH 019-(154)
FILE NAME:	...plot_files\zd307c4xs.279EB.ptf
DESIGN SUPERVISOR:	GREG EDWARDS
DESIGNED BY:	MARC FOISY
VT 279 EB CROSS SECTION	EBX-14
PLOT DATE:	1/26/2010
DRAWN BY:	STANTEC
CHECKED BY:	GARY SANTY
SHEET	352 OF 468

1/26/2010 4:56:40 PM v:\1953\getlive\1953\0002\tr\anspor\101\dr\cm\ng\con\tr\cst_4\p101_files\z307c4xs.279EB.ptf