



EB 10+995.920
END APPROACH

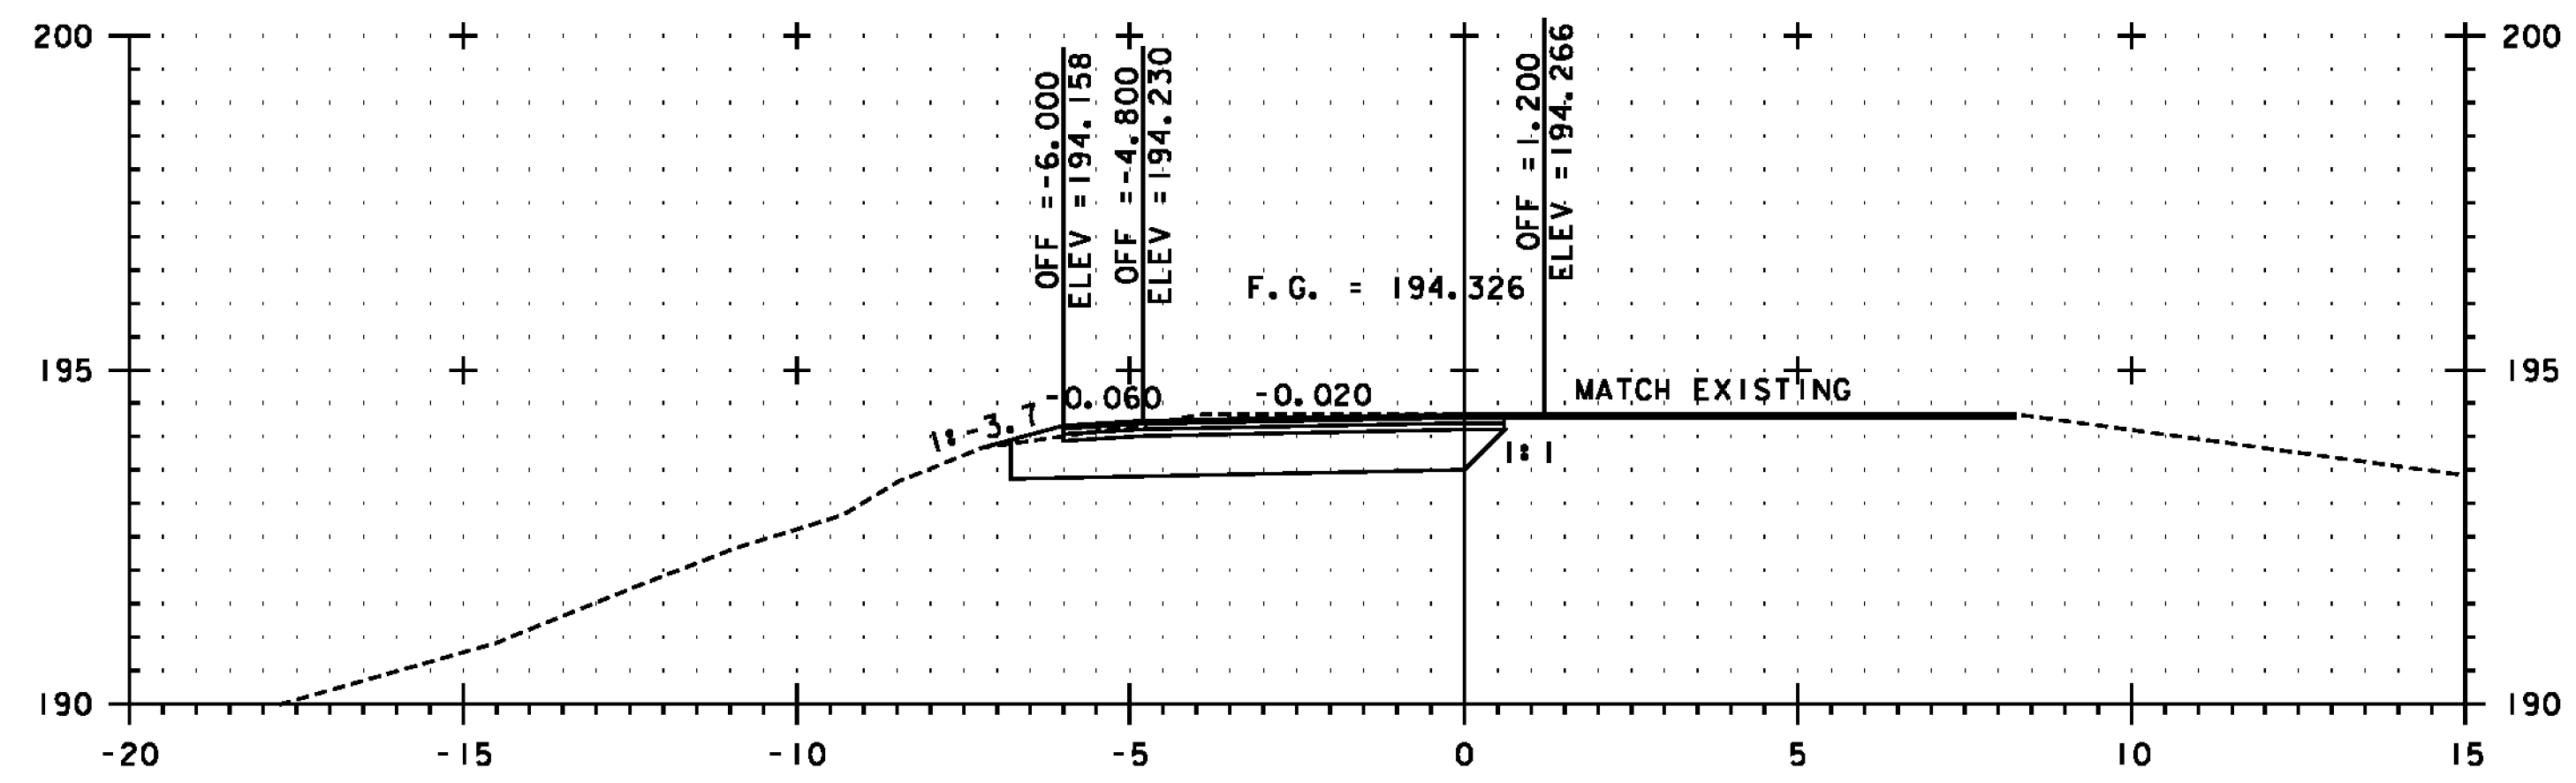

EB 10+980

SEE NOTE ON SHEET 339

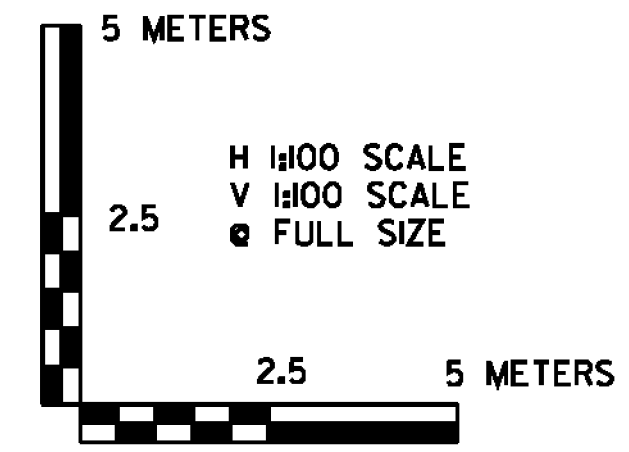

PROJECT NAME:	BENNINGTON
PROJECT NUMBER:	NH 019-(154)
FILE NAME:	...plot_files\zd307c4xs.279EB.ptf
DESIGN SUPERVISOR:	GREG EDWARDS
DESIGNED BY:	MARC FOISY
VT 279 EB CROSS SECTION	EBX-16
PLOT DATE:	1/26/2010
DRAWN BY:	STANTEC
CHECKED BY:	GARY SANTY
SHEET	354 OF 468

1/26/2010 4:56:42 PM v:\1953\getlive\1953\0002\tr\anspor\101\10\dr\cwg\ng\con\tr\cst_4\plot_files\zd307c4xs.279EB.ptf