




NOTE: FINAL CROSS SECTIONS FOR RAMP F ARE CONTAINED IN THE FINAL COMP BOOKS FOR ITEM 203.15 - COMMON EXCAVATION

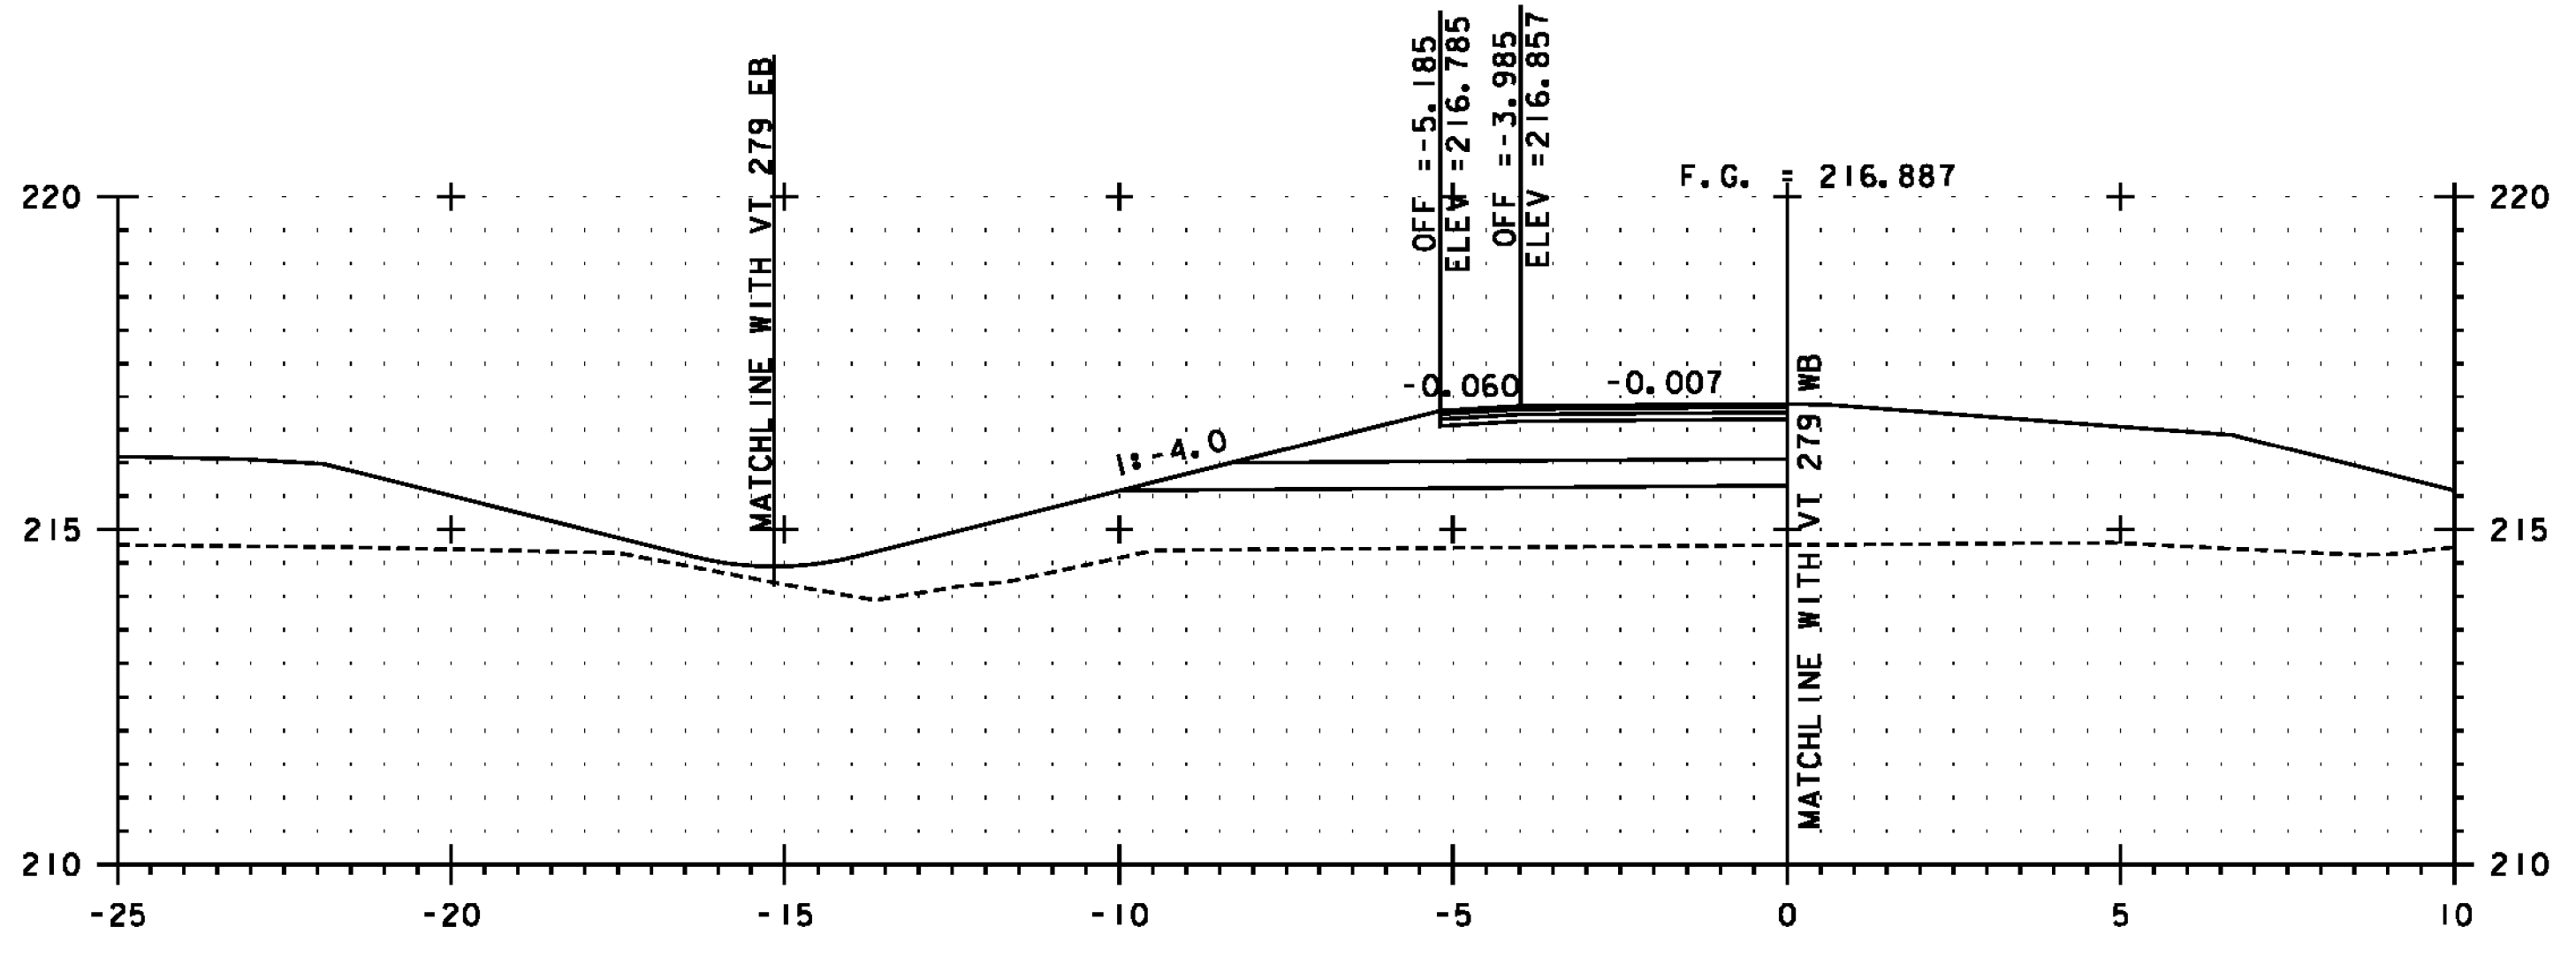


F 1+020

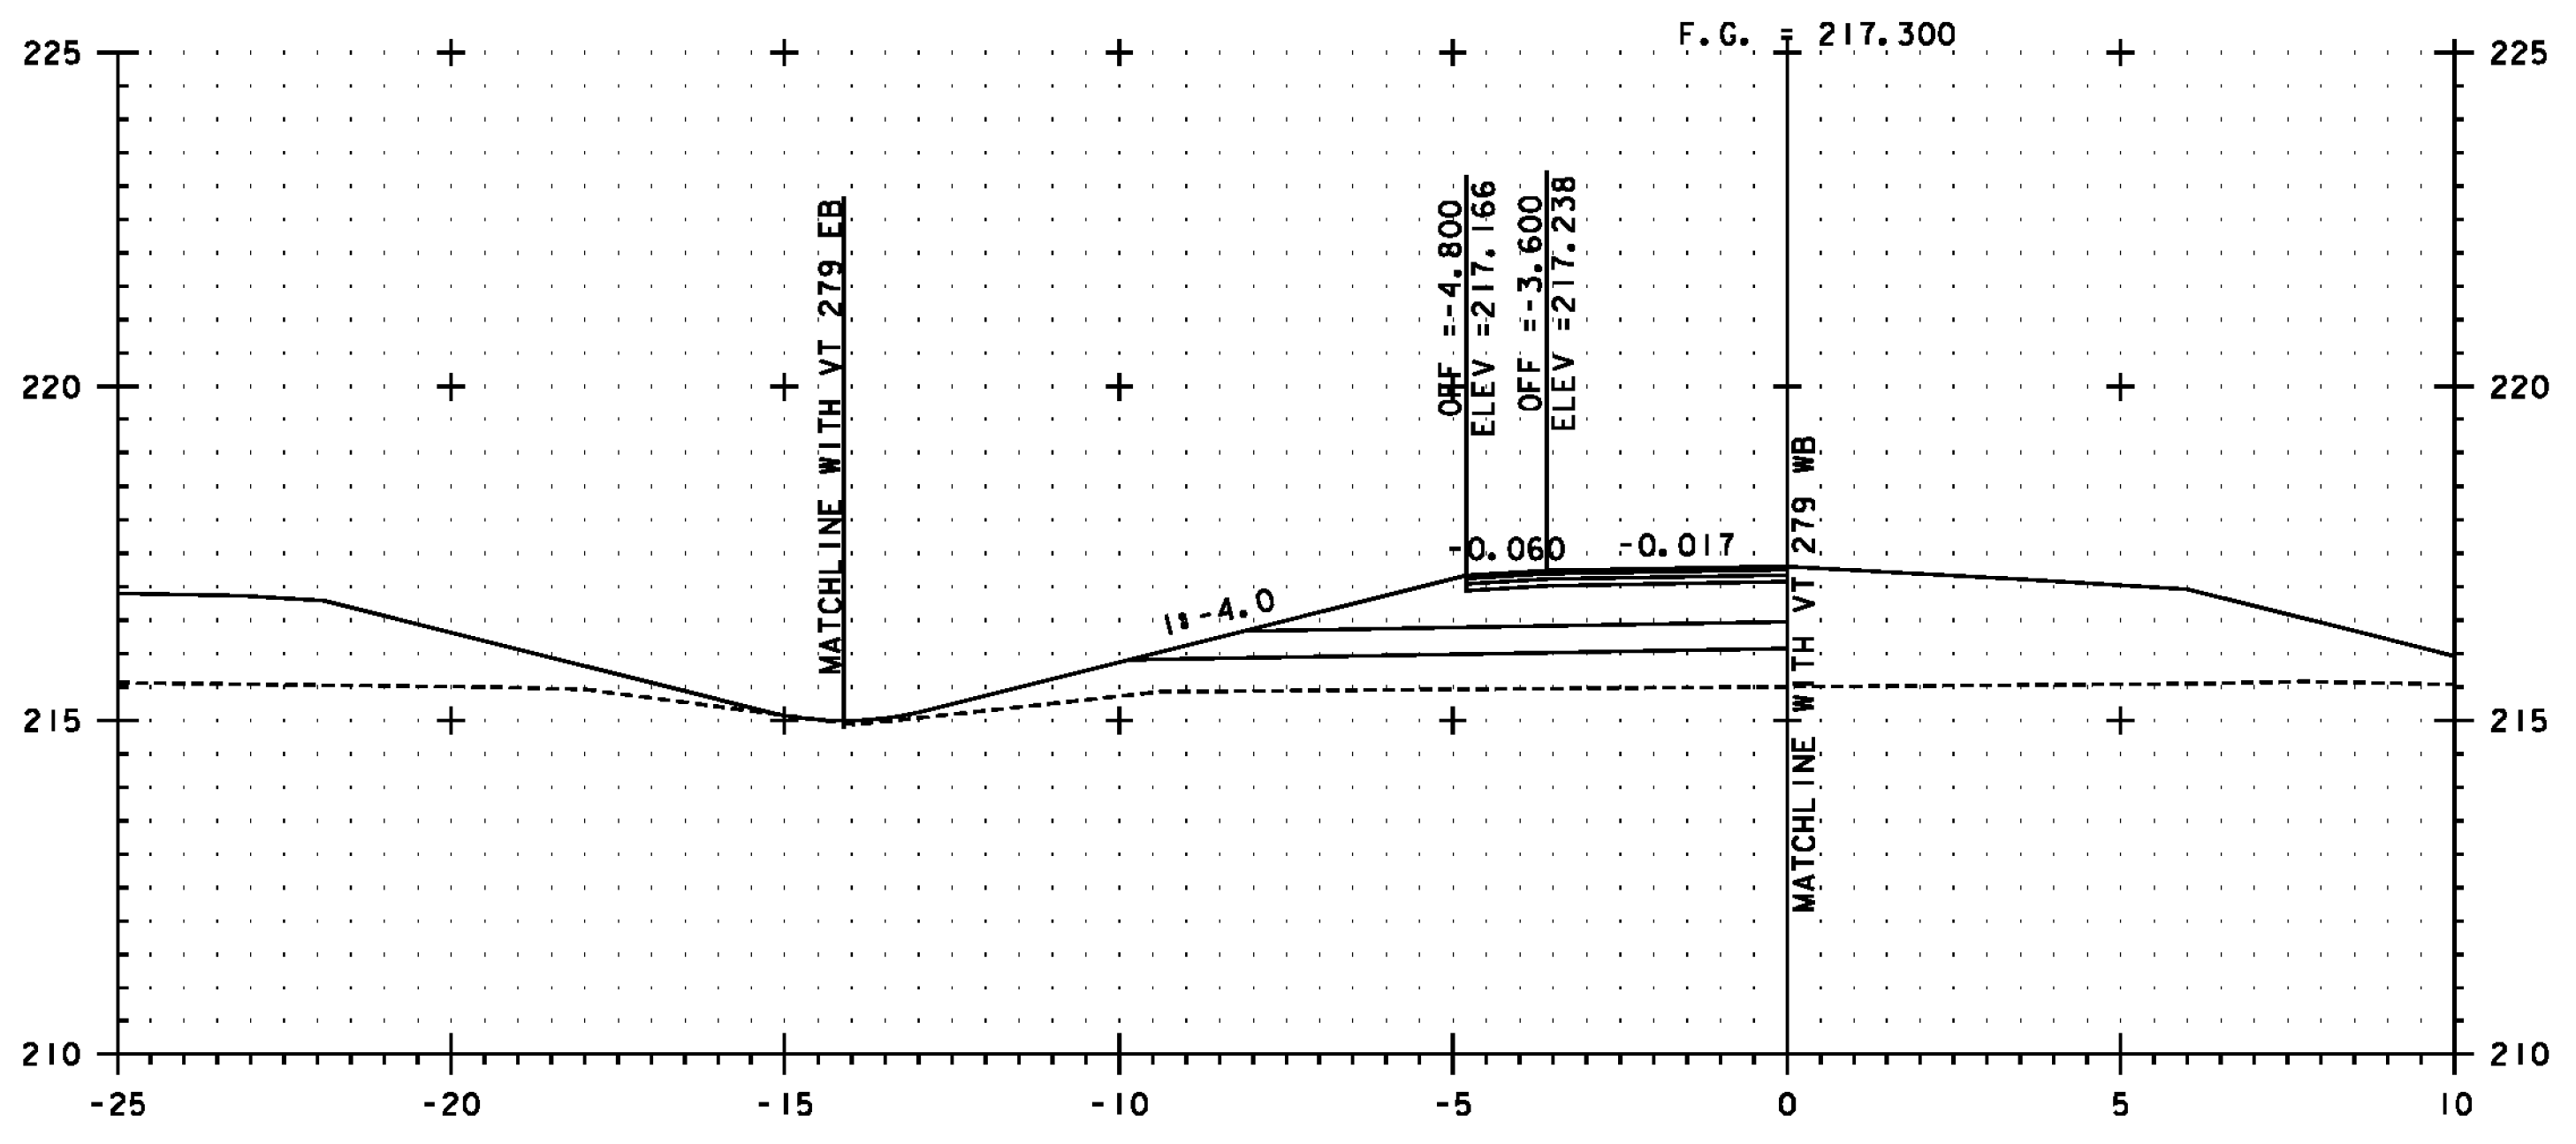


F 1+000 = WB 9+769.500

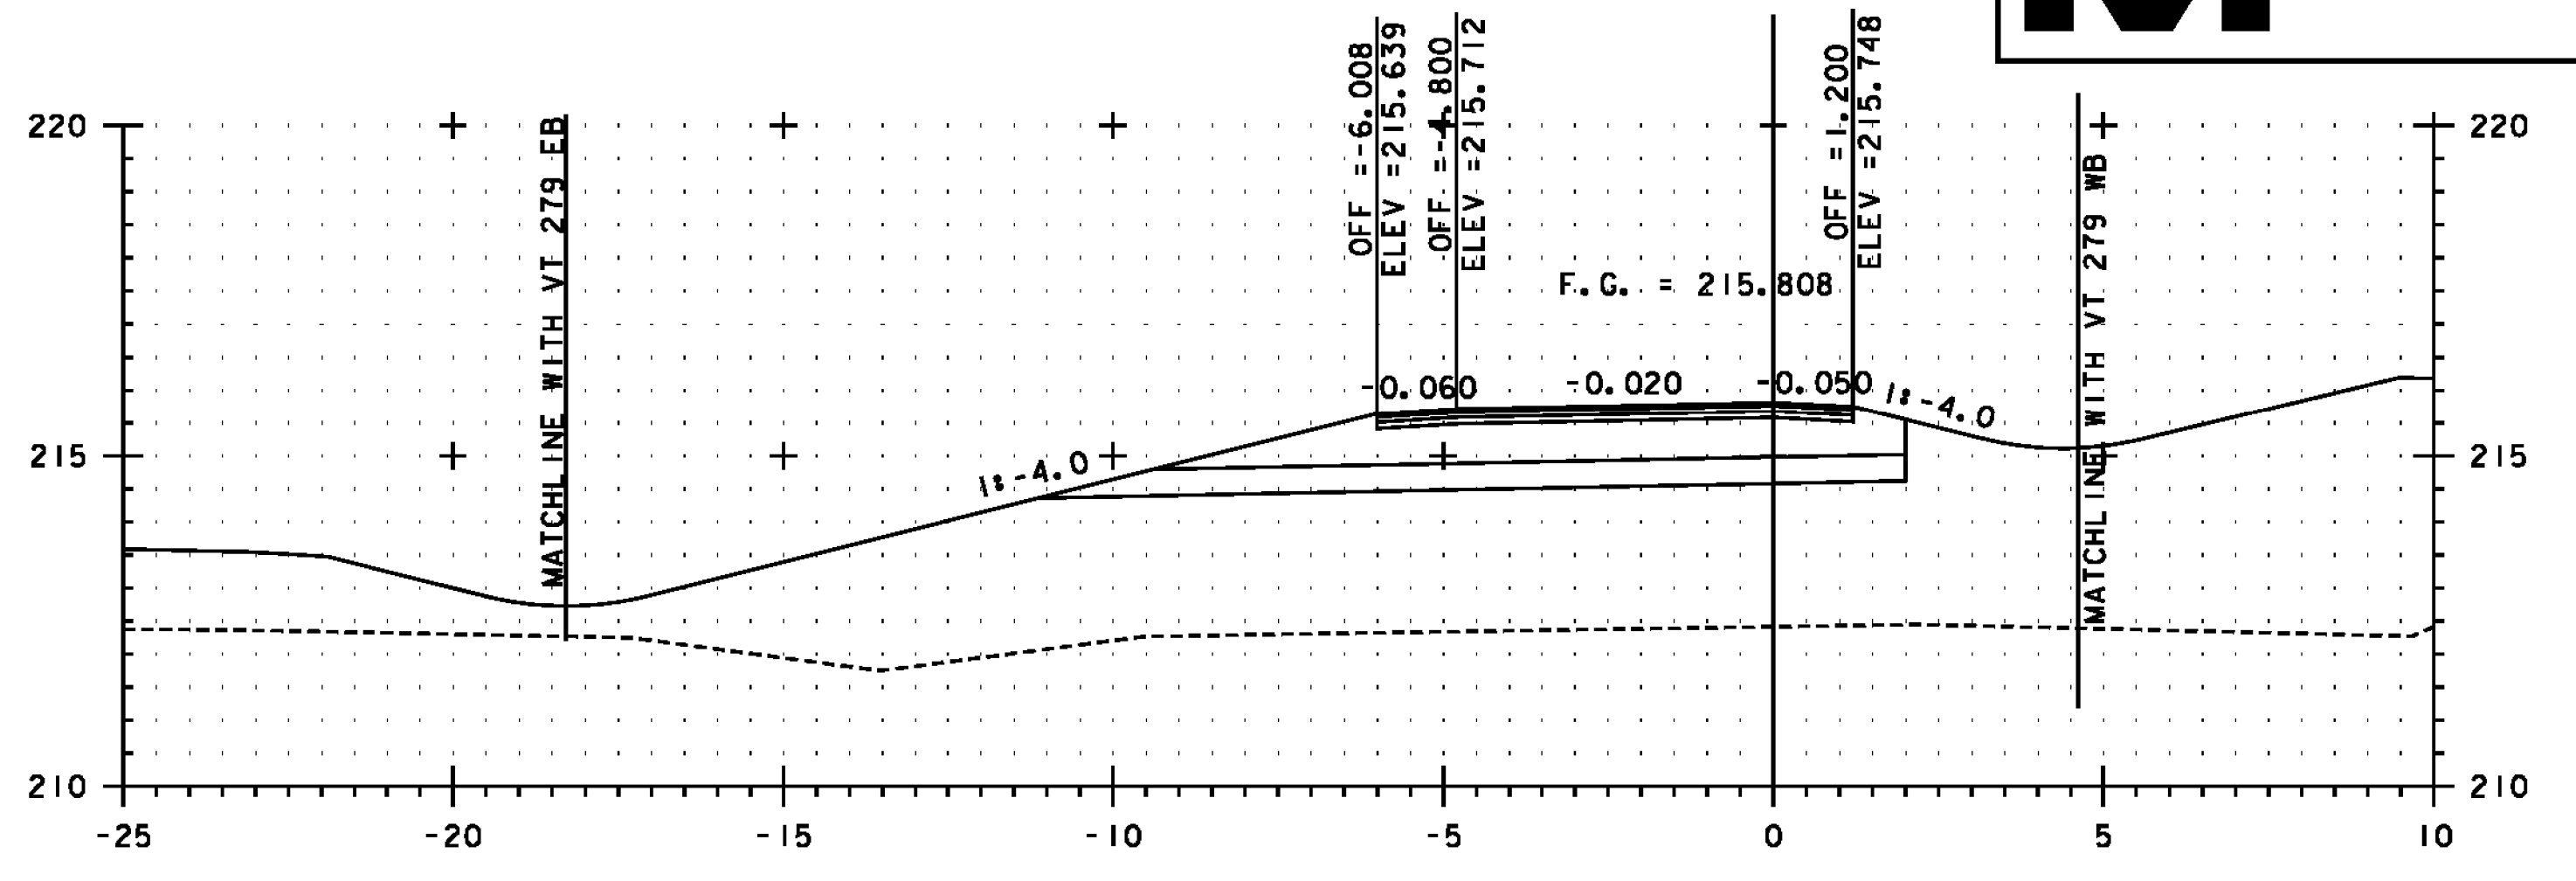

F 1+080

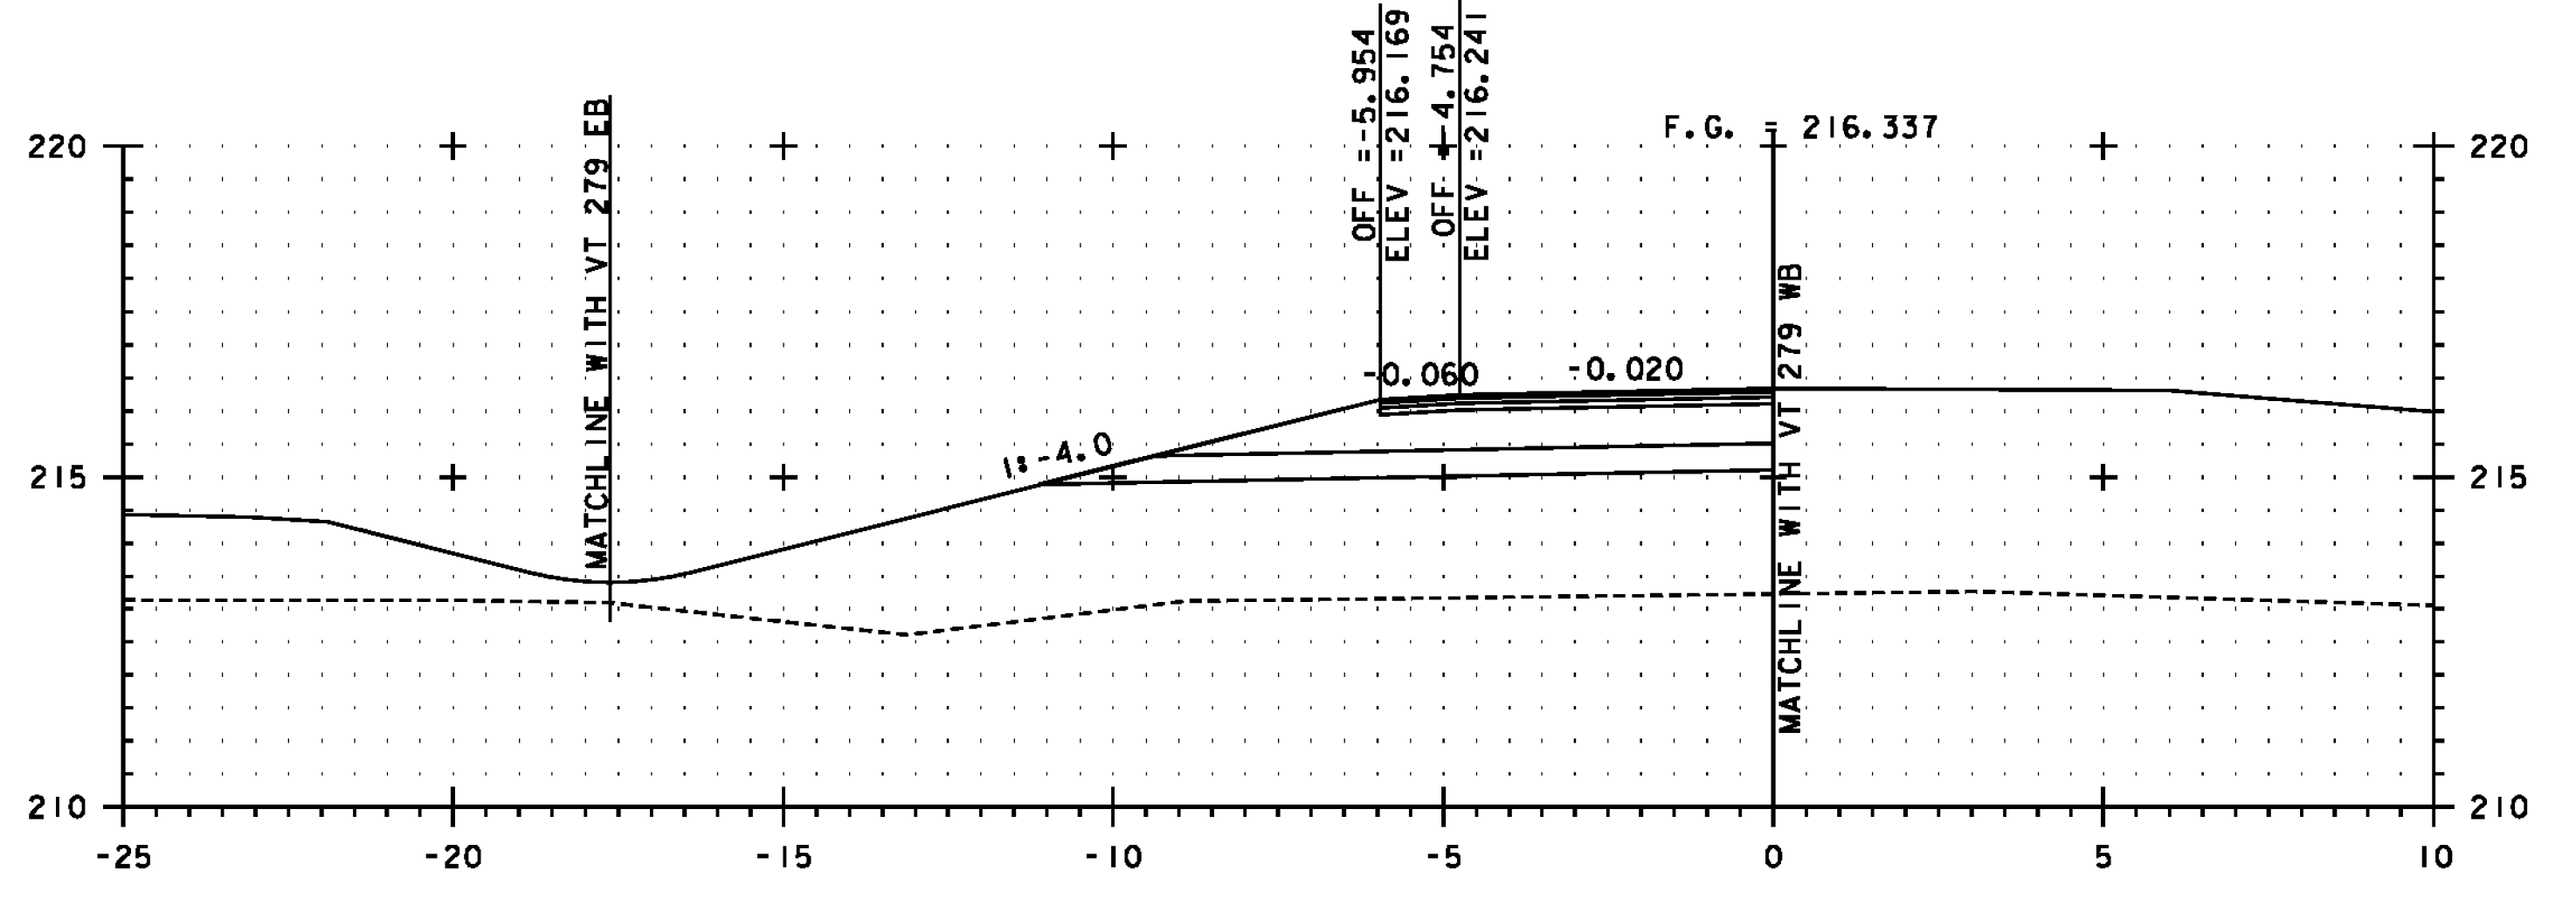


F 1+060

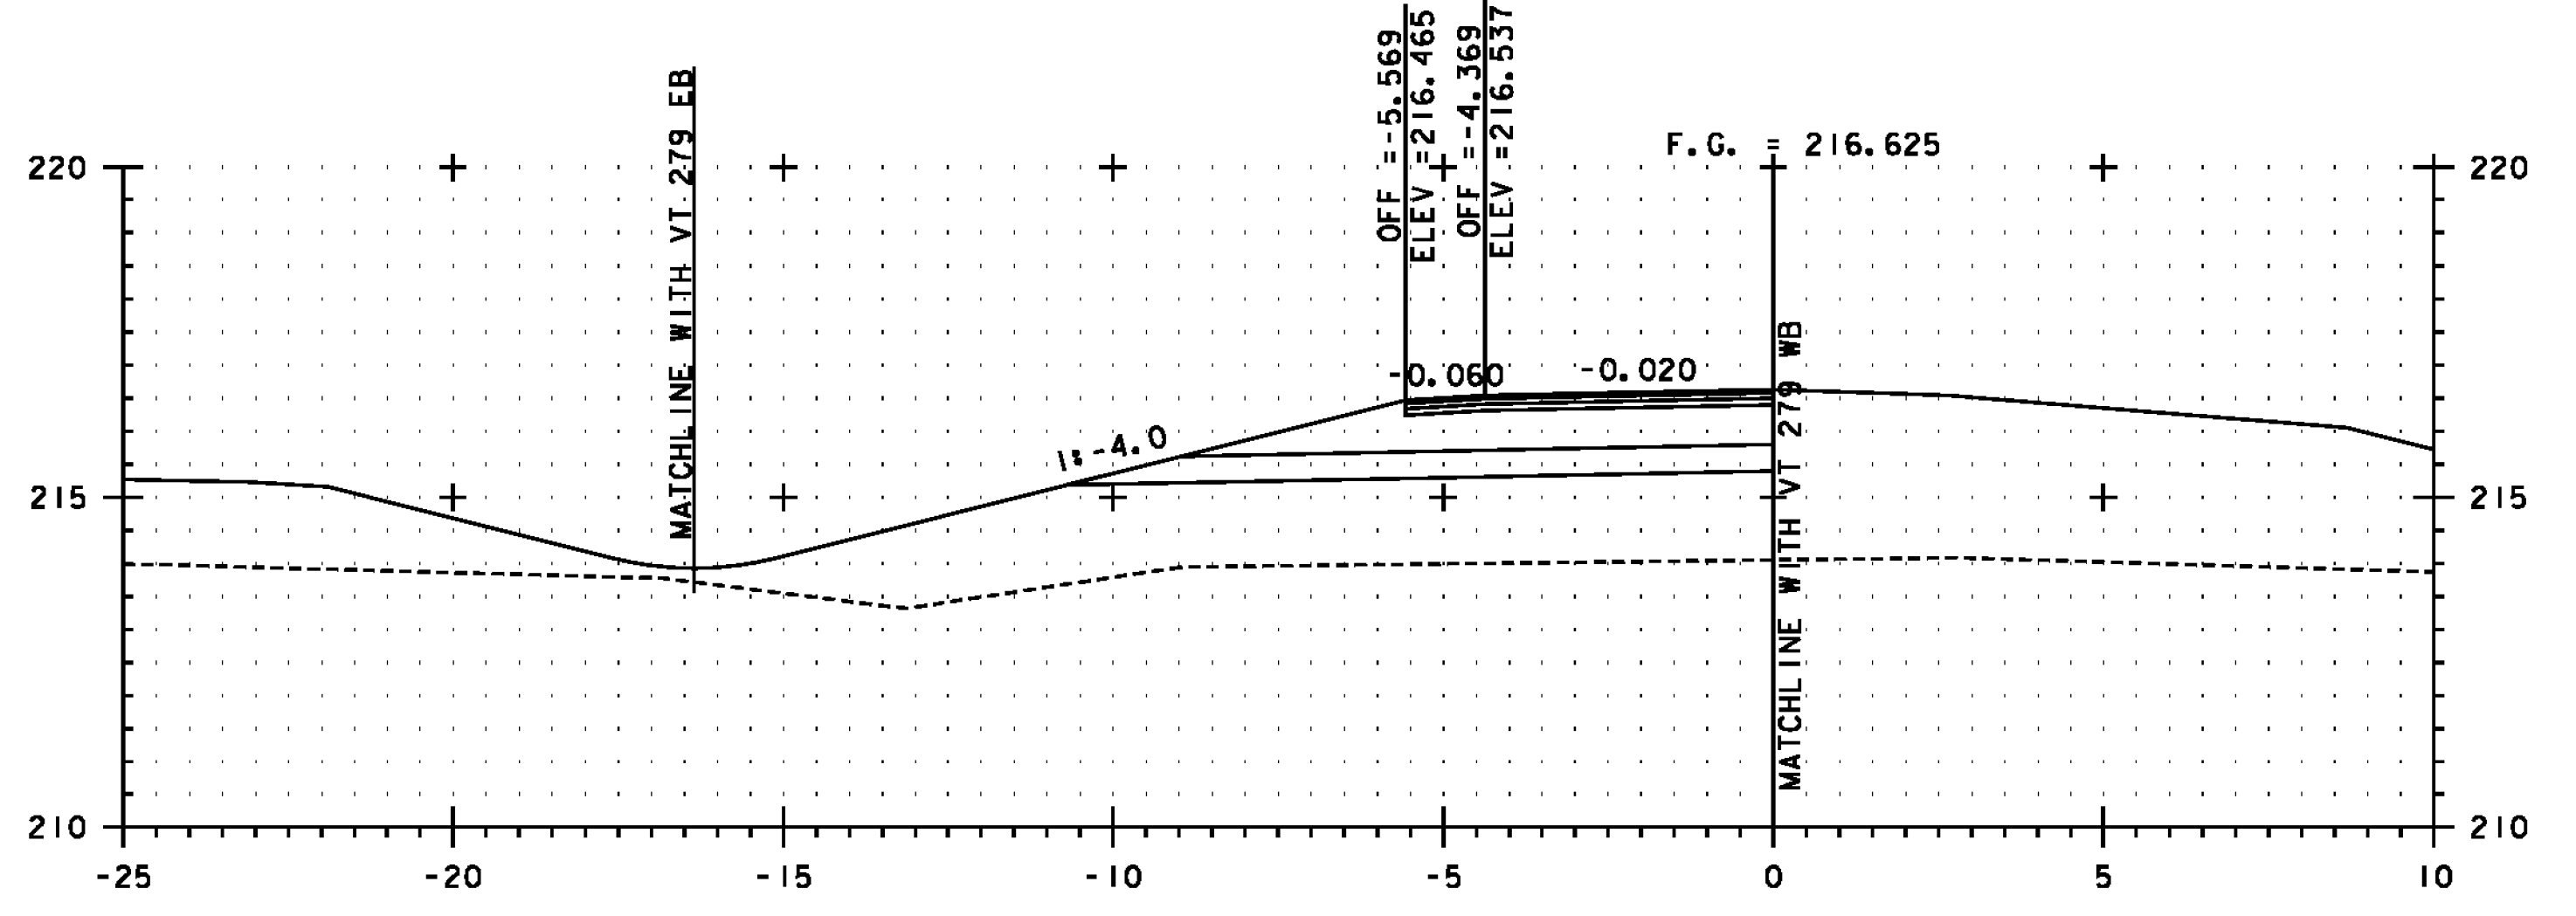

F 1+040

SEE REVISED SHEET

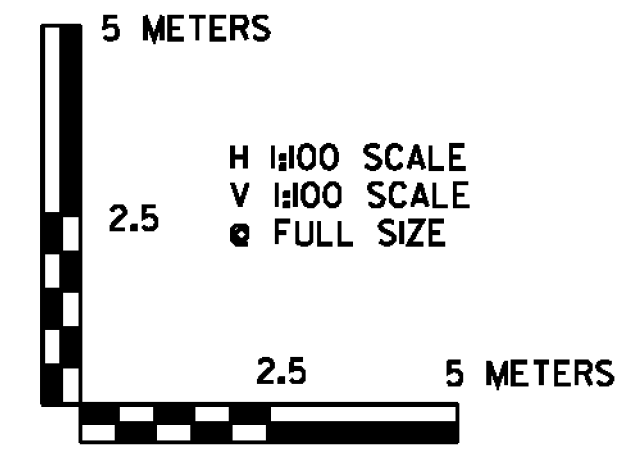

PROJECT NAME:	BENNINGTON
PROJECT NUMBER:	NH 019-(154)
FILE NAME:	...plot_files\zd307c4xs.rampF.ptf
DESIGN SUPERVISOR:	GREG EDWARDS
DESIGNED BY:	MARC FOISY
DRAWN BY:	STANTEC
CHECKED BY:	GARY SANTY
RAMP F CROSS SECTION	FXS-01
	SHEET 355 OF 468

I:\2672010_45645 PM V\1953\getlive\19530002\tr\anspor\101\10\dr\w\ng\com\tr\cp1_4\p101_files\z307c4xs_rampF.ptf