




F 1+120

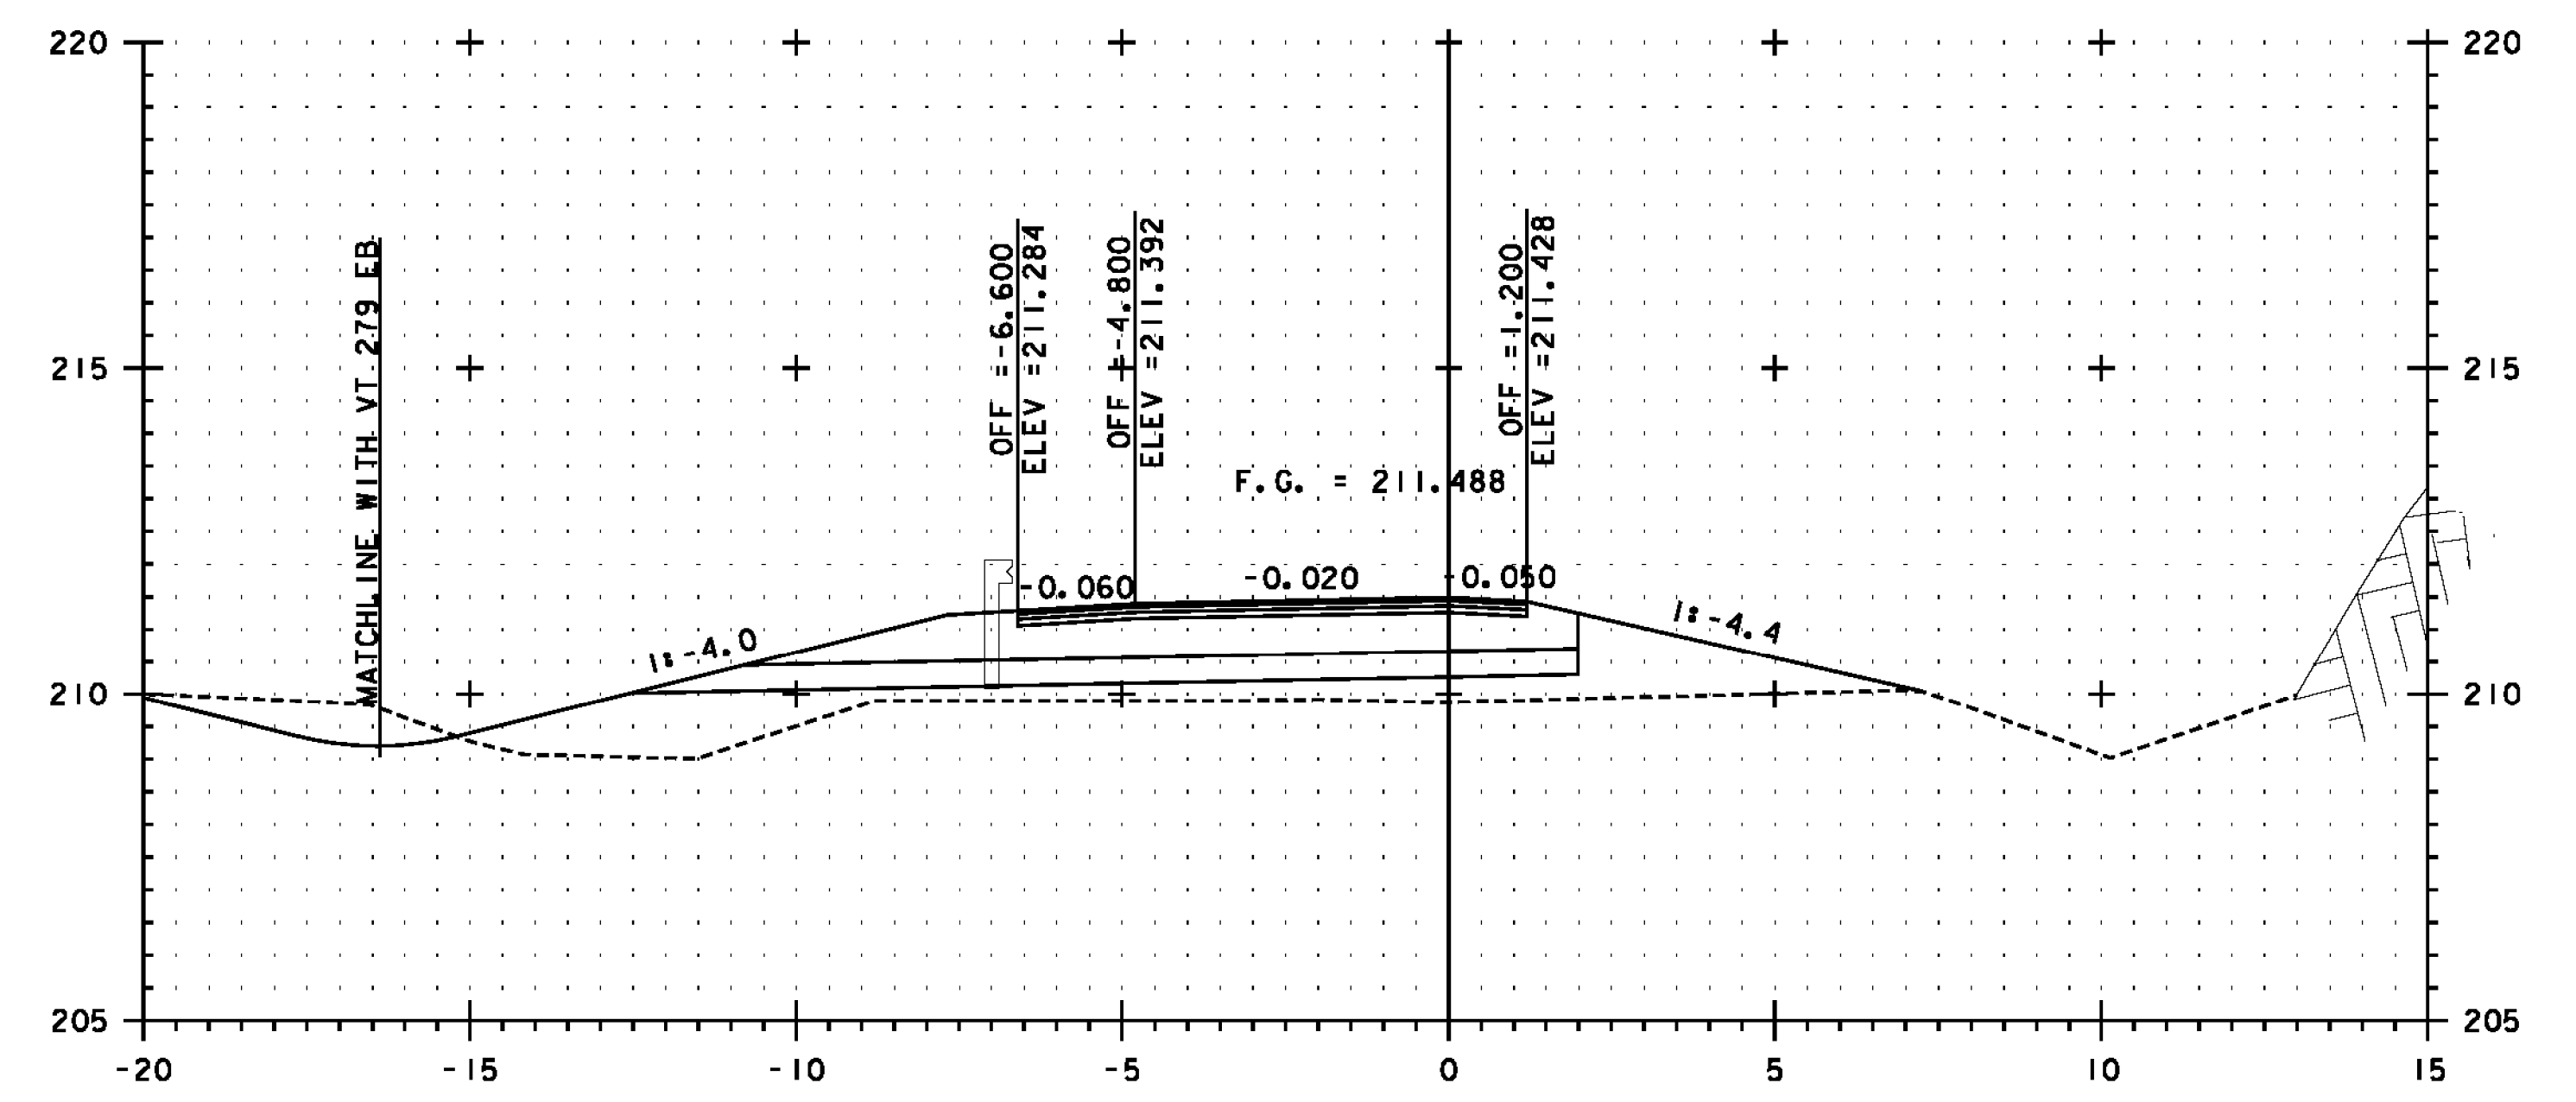

F 1+160

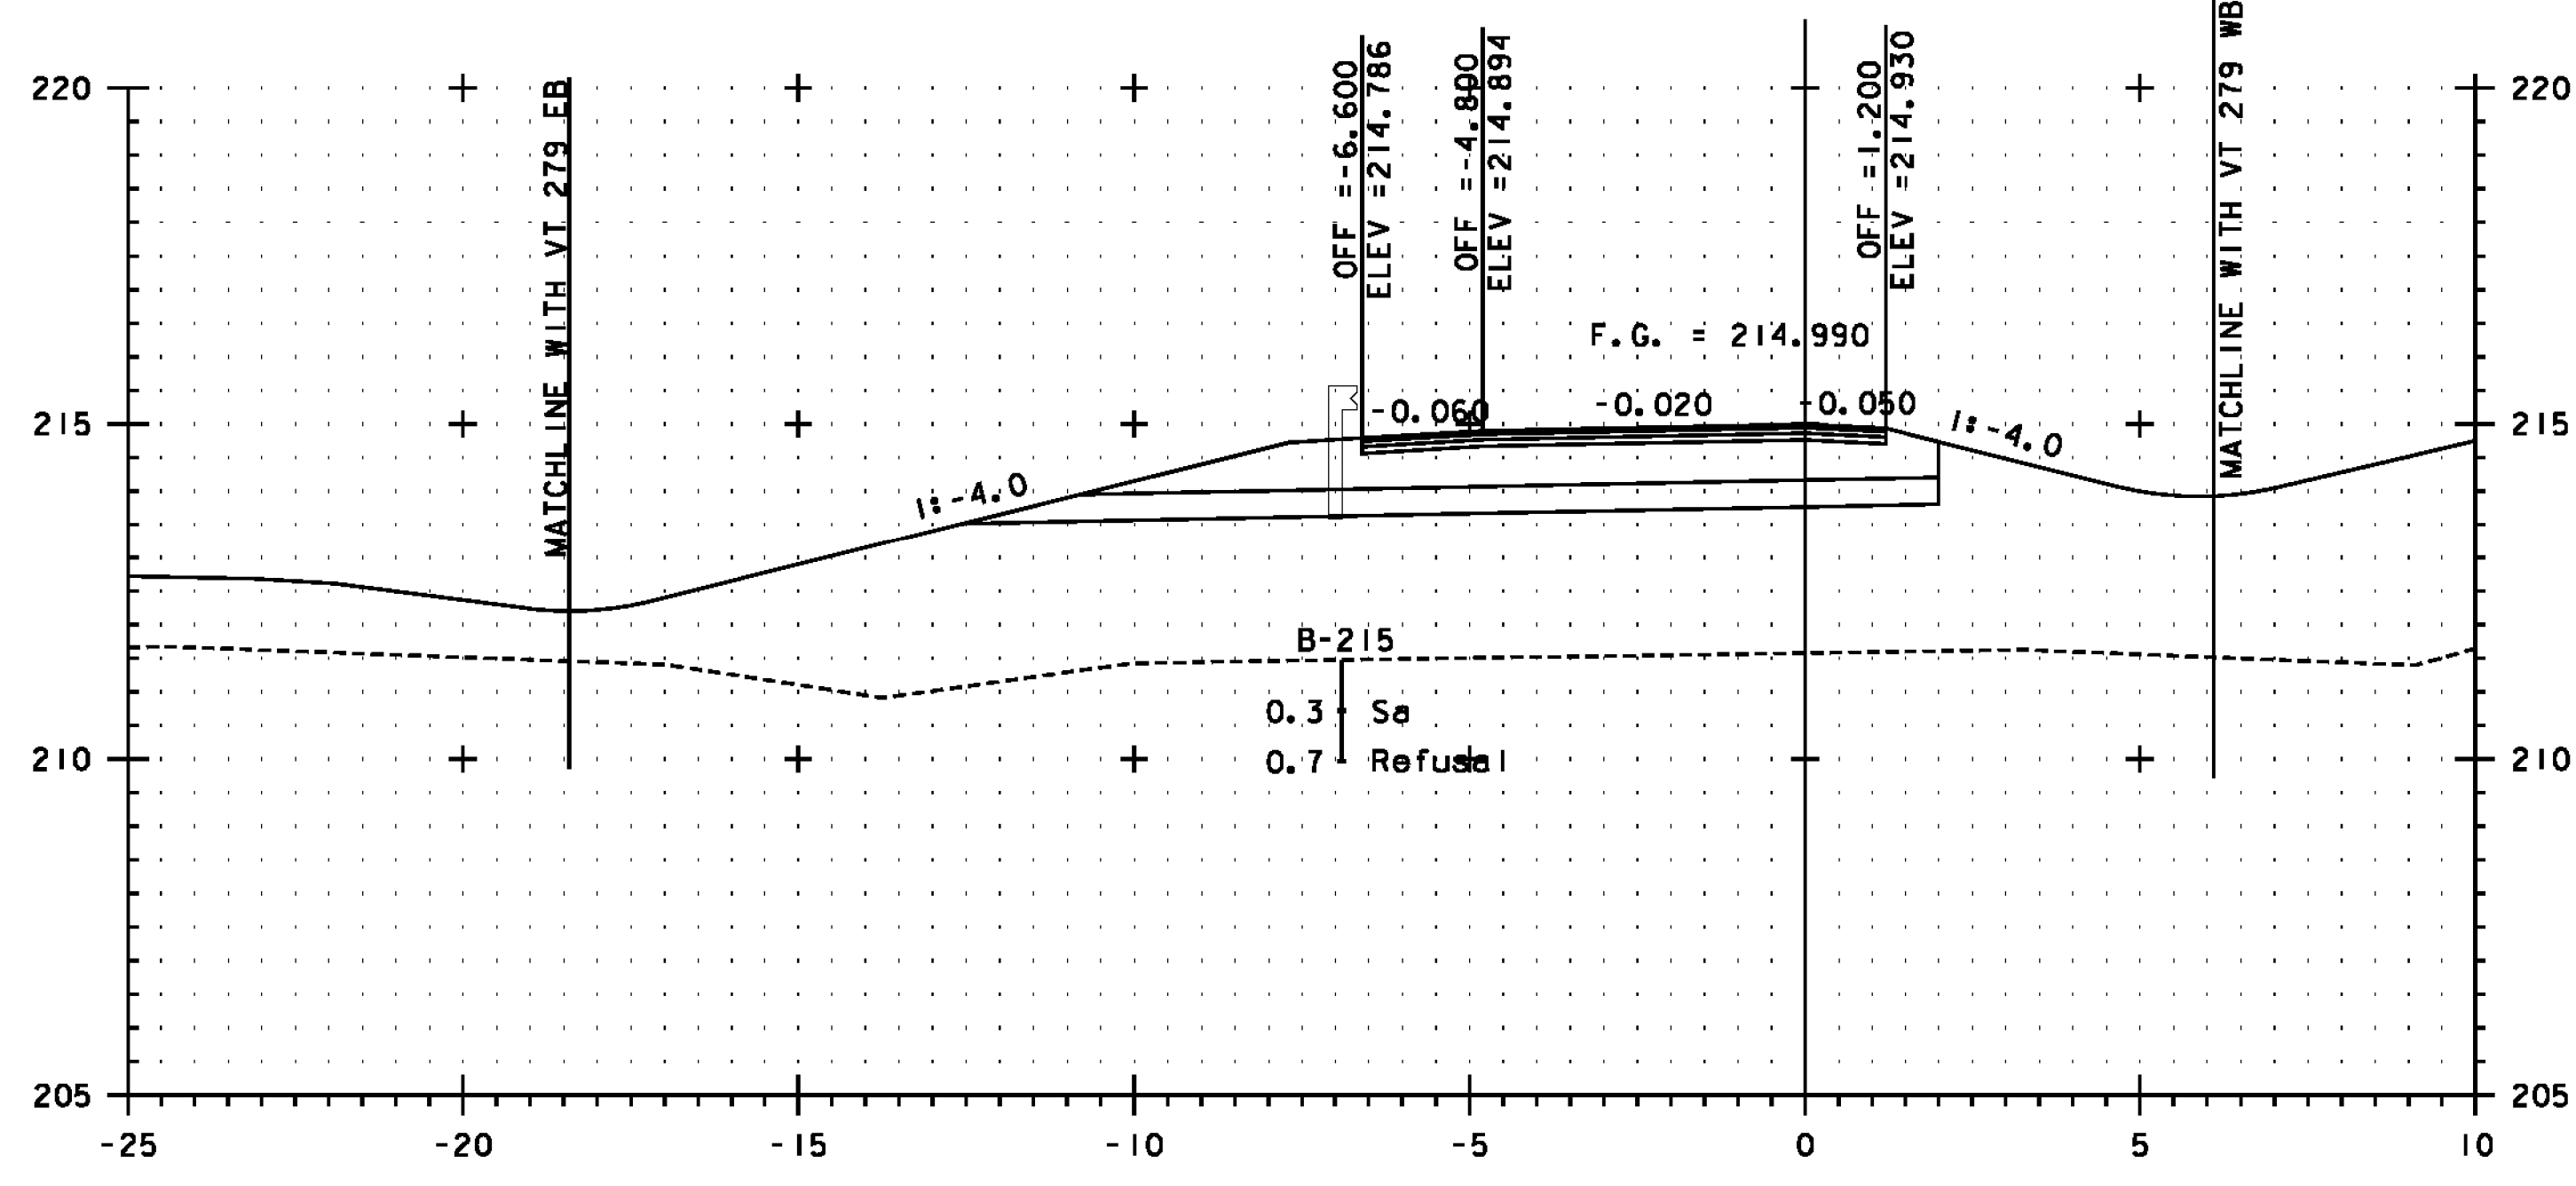


F 1+100

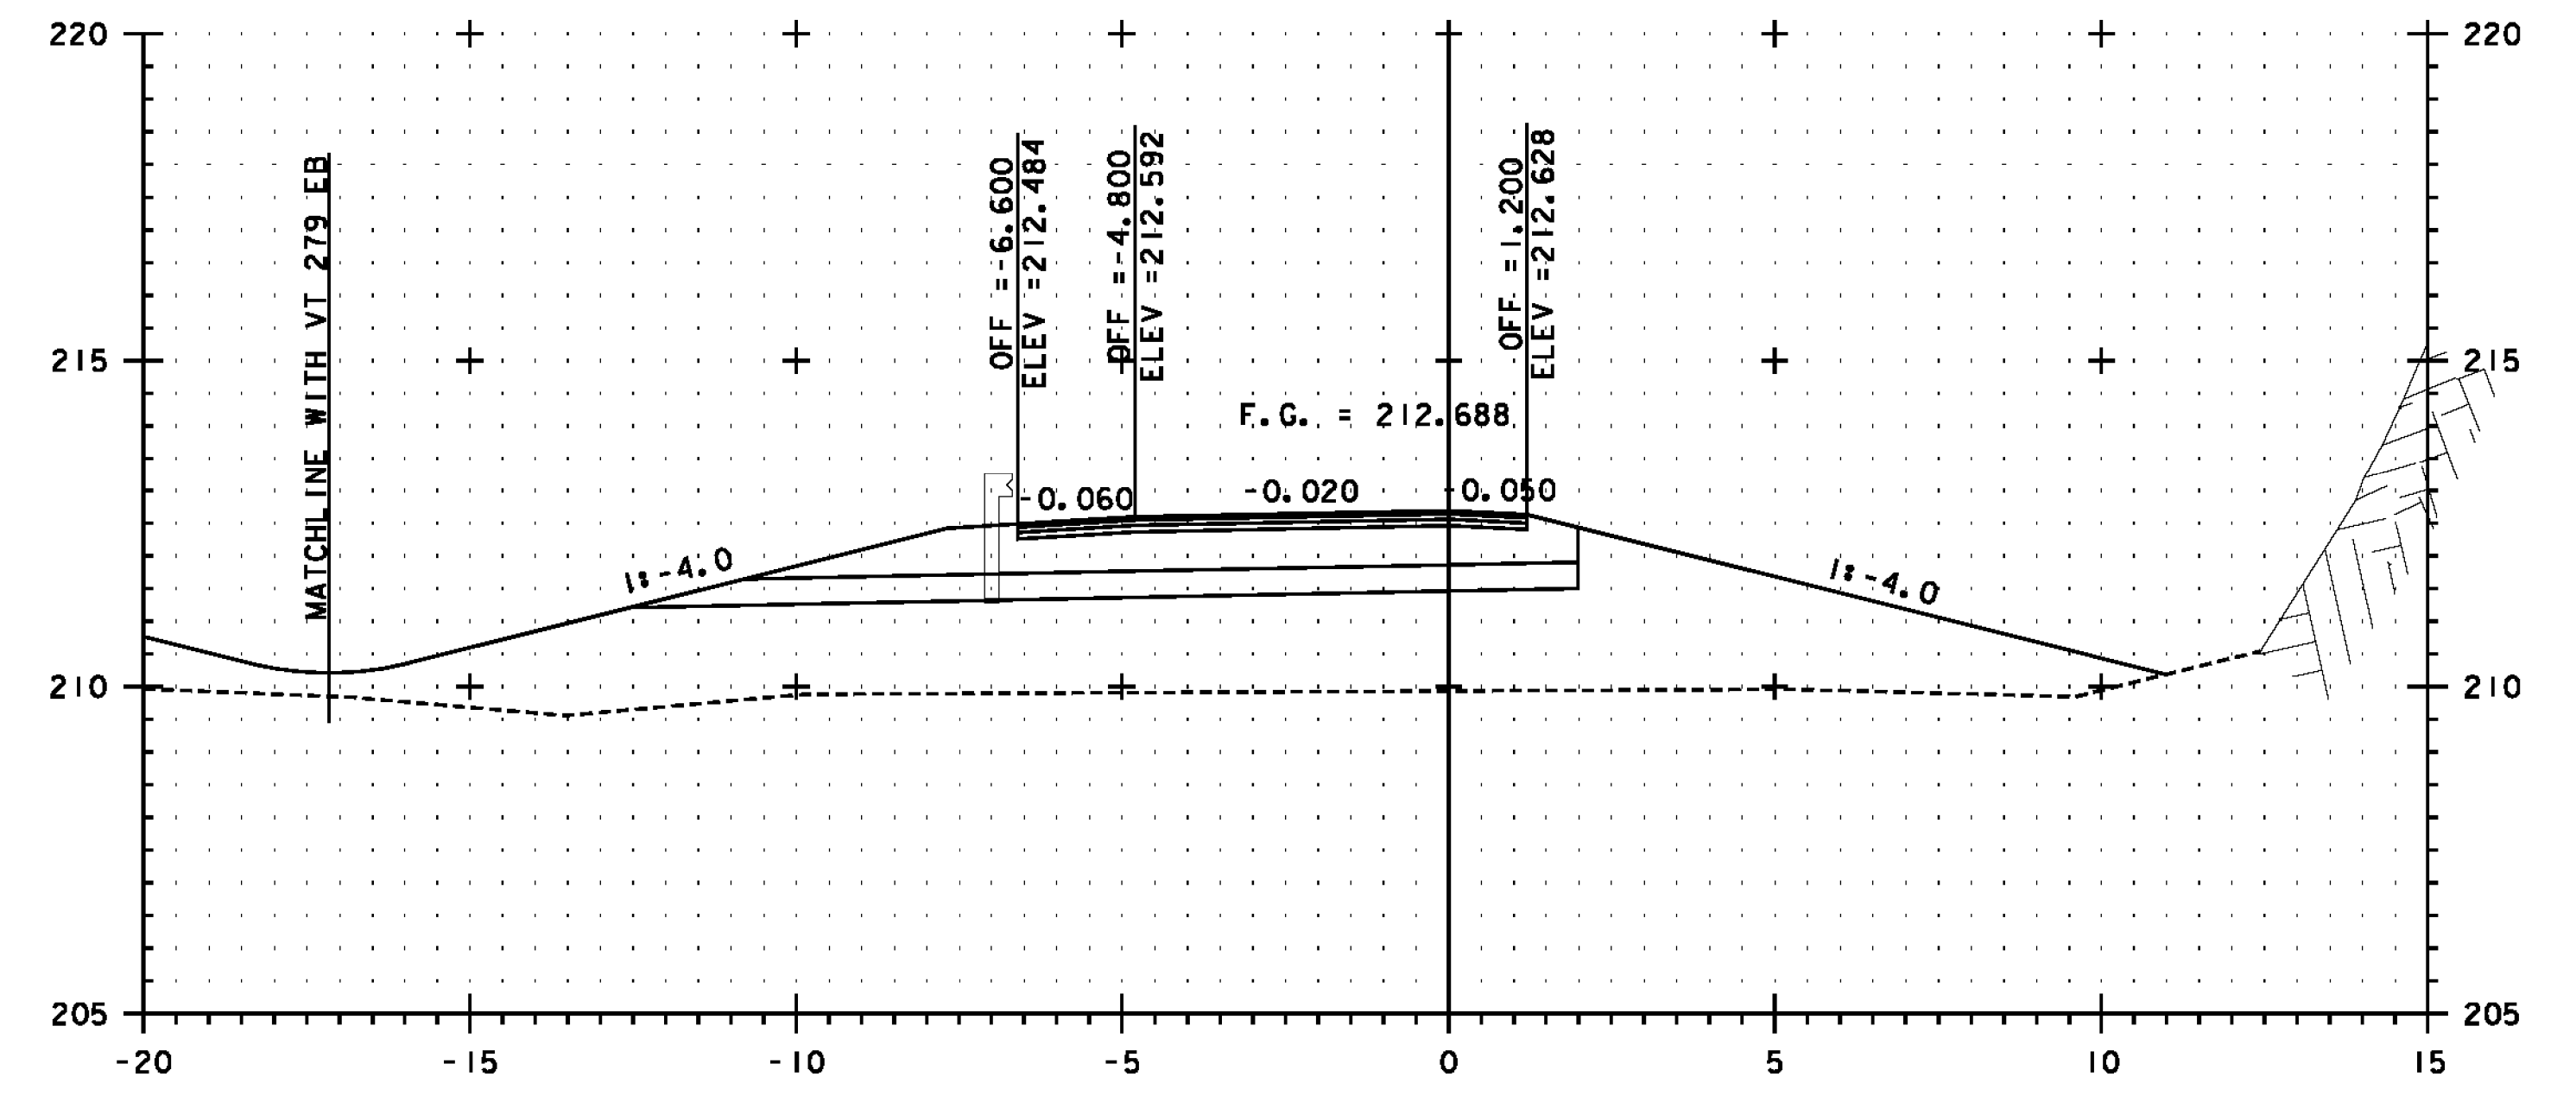

F 1+140

SEE NOTE ON SHEET 355

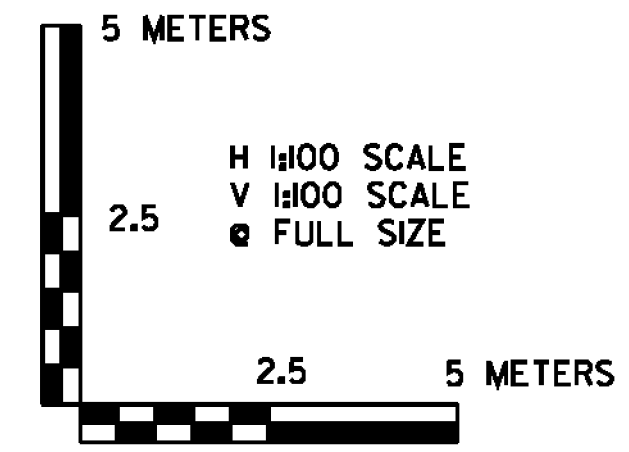

SEE REVISED SHEETS

	PROJECT NAME: BENNINGTON
	PROJECT NUMBER: NH 019-(154)
FILE NAME: ...\plot_files\zd307c4xs.rampF.pft	PLOT DATE: 1/26/2010
DESIGN SUPERVISOR: GREG EDWARDS	DRAWN BY: STANTEC
DESIGNED BY: MARC FOISY	CHECKED BY: GARY SANTY
RAMP F CROSS SECTION FXS-02	SHEET 356 OF 468

1/26/2010 4:56:46 PM V:\1953\getlive\1953\0002\tr\anspor\101\dr\dwg\confr\001_4\p01_files\z307c4xs_rampF.pft