




F 1+160

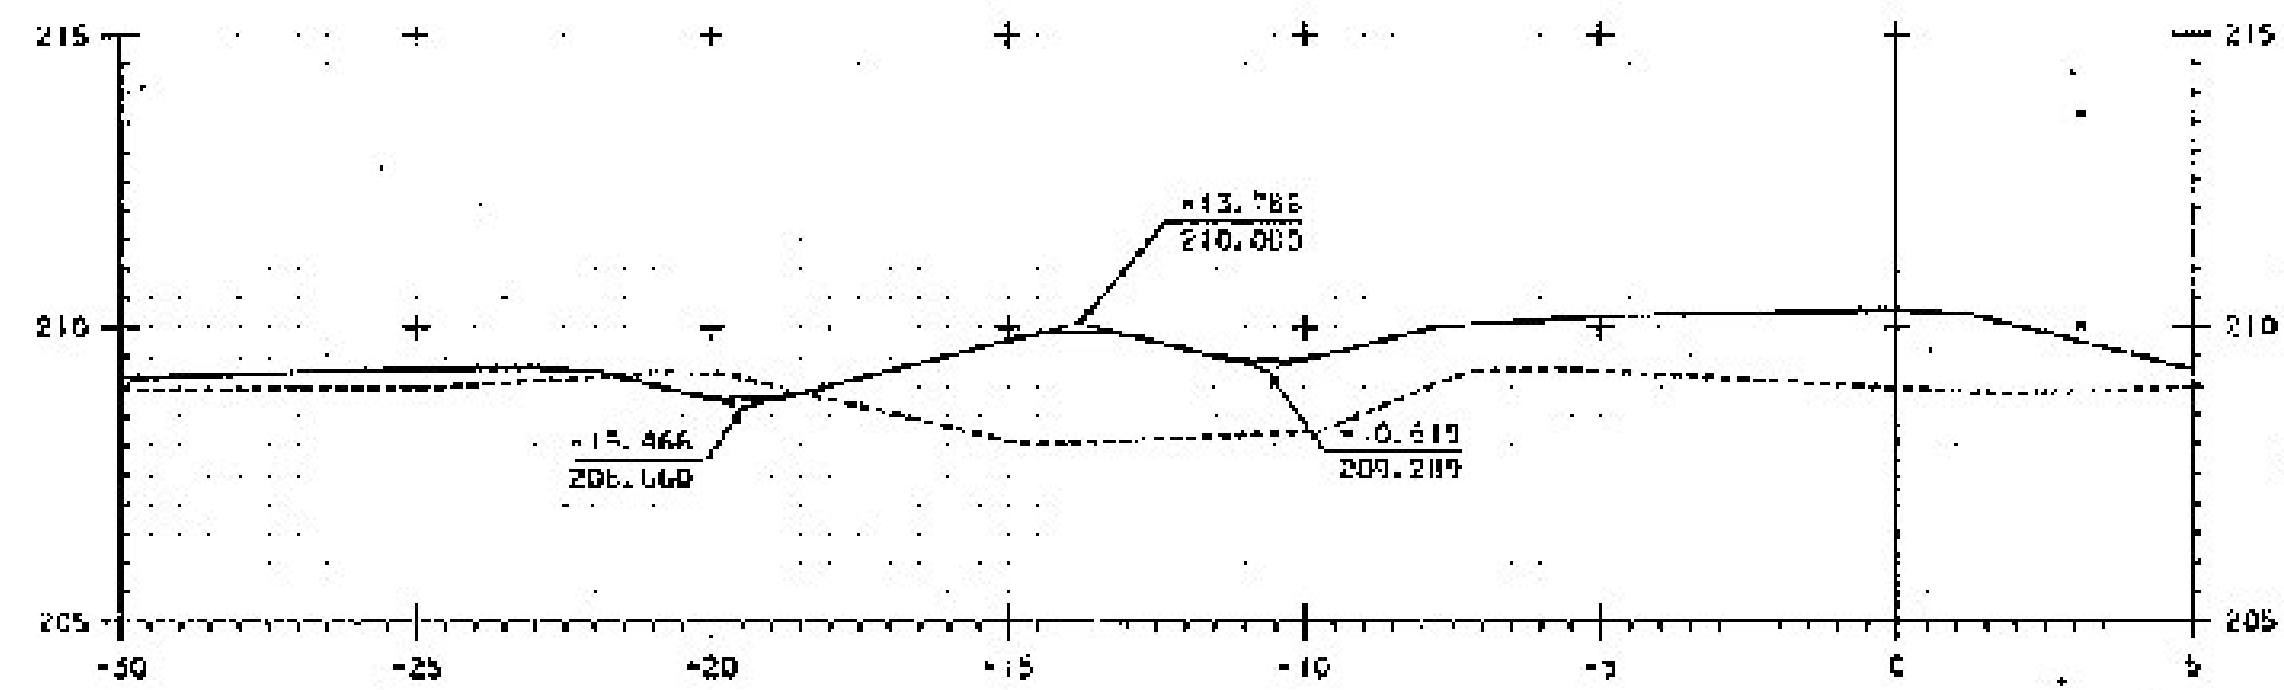

F 1+180

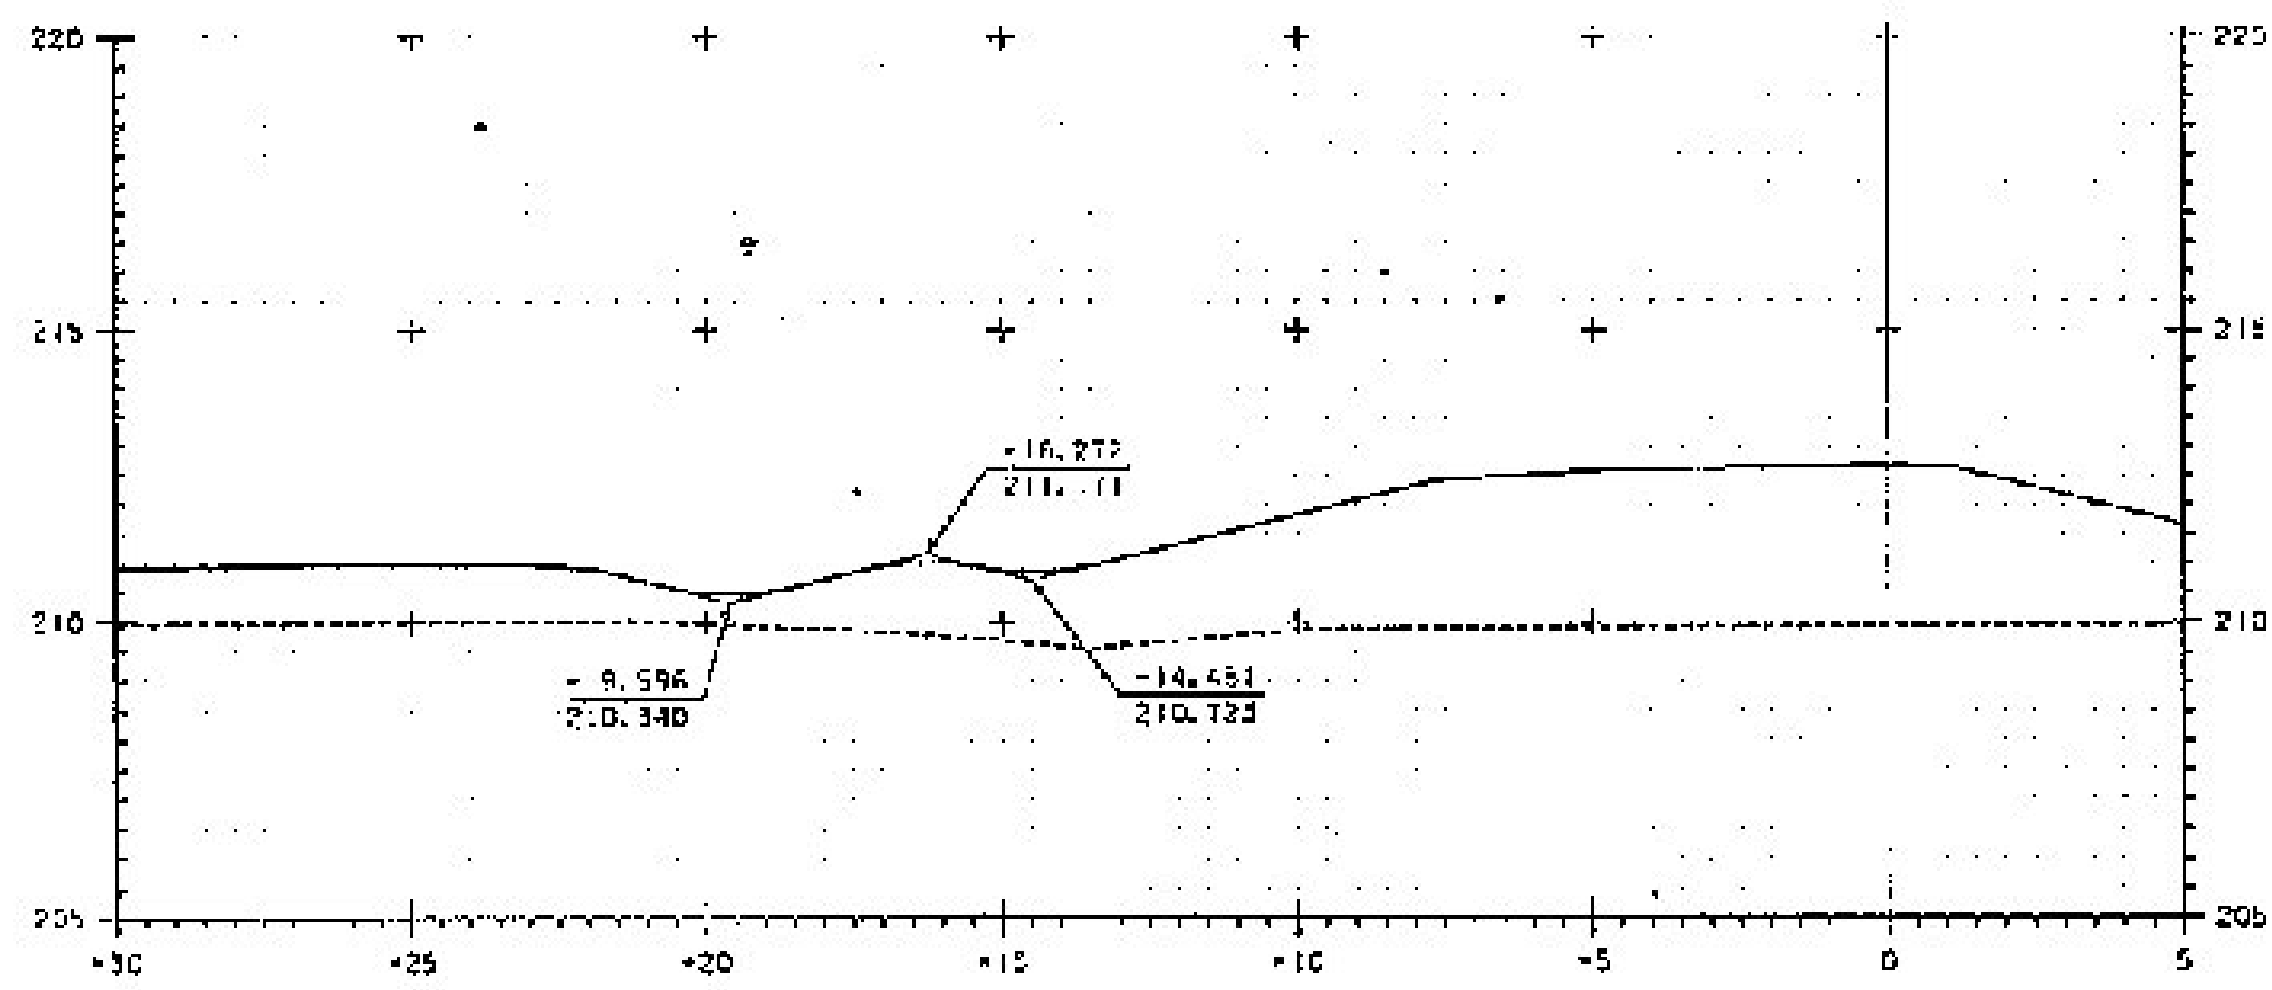

F 1+140

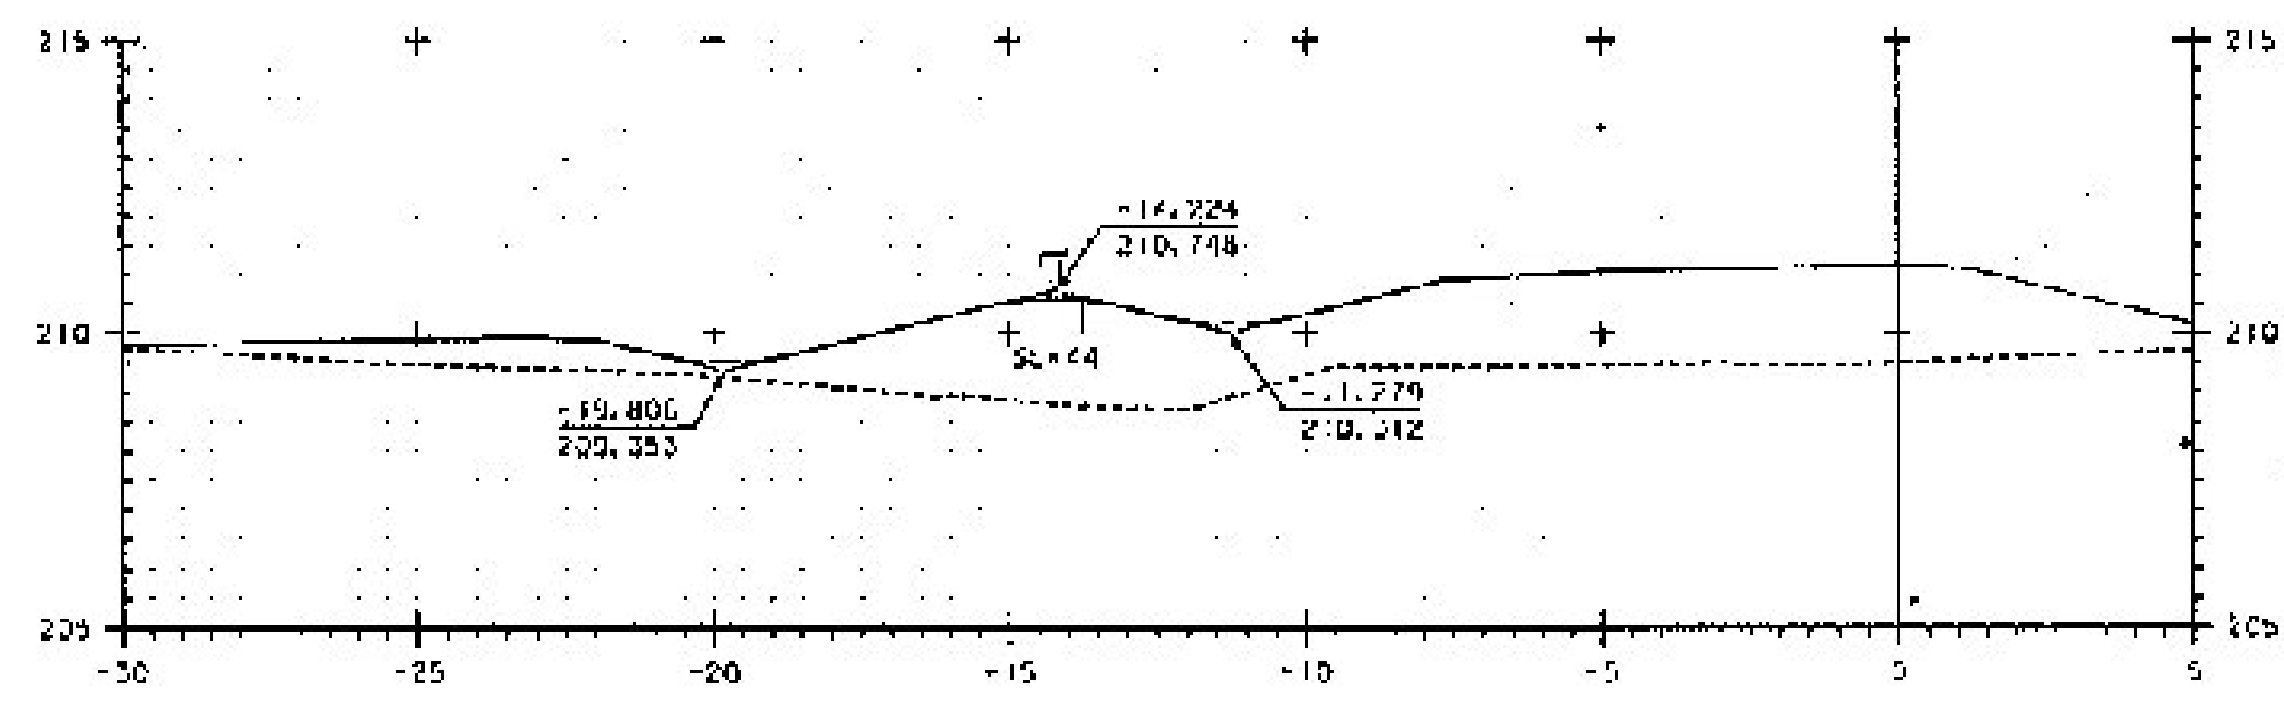

F 1+.65.194

LIGHT POLE  
RECORD PLANS