




F 1+204.614 = NB 9+927.769

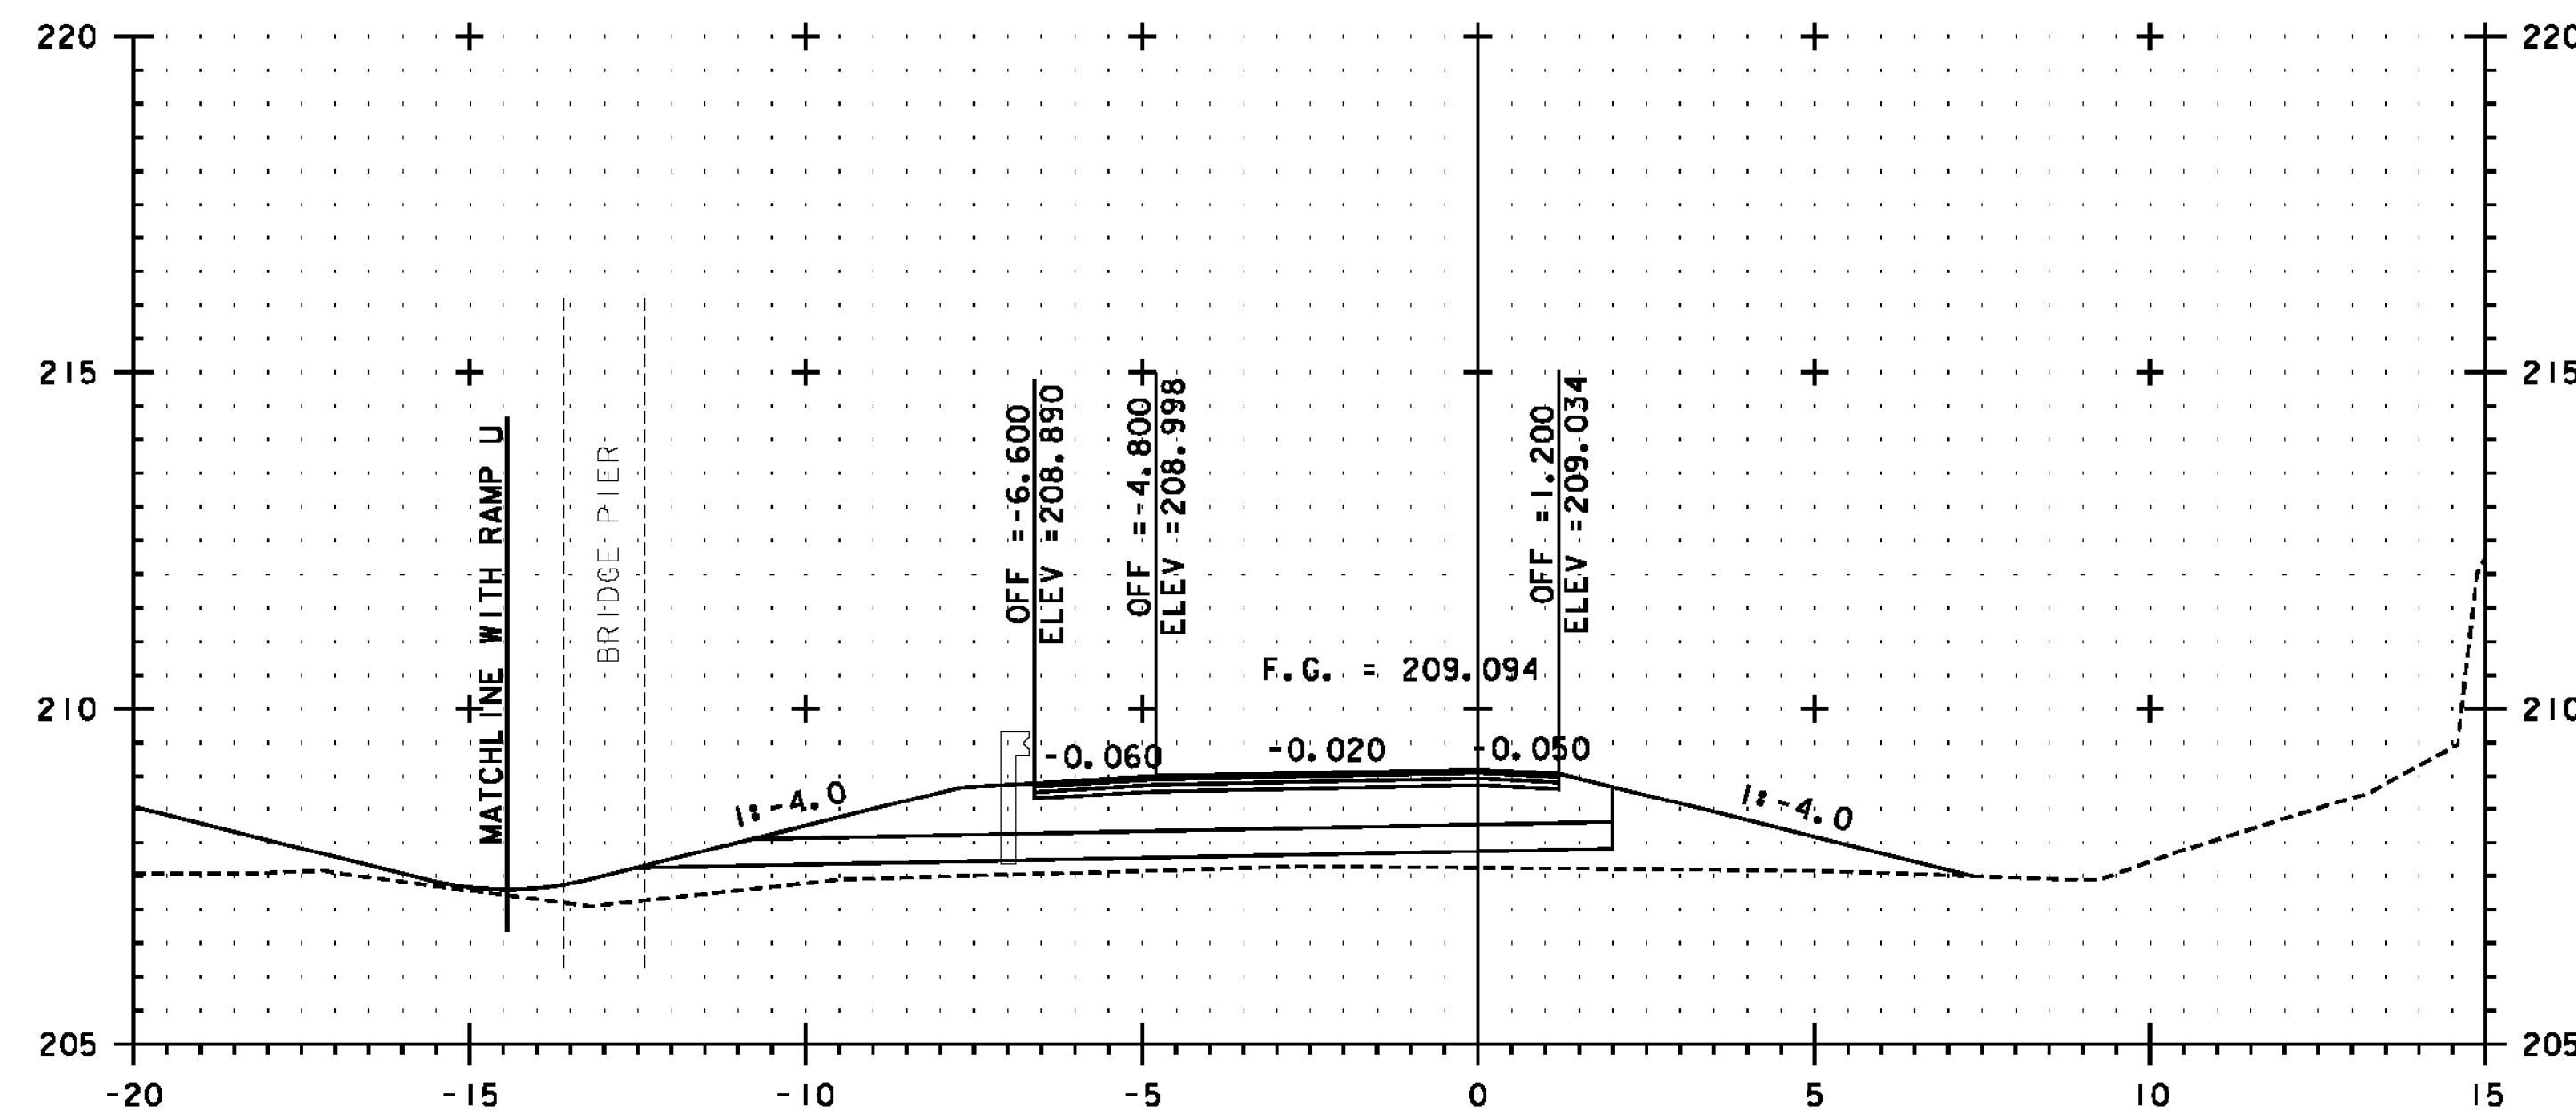


F 1+200

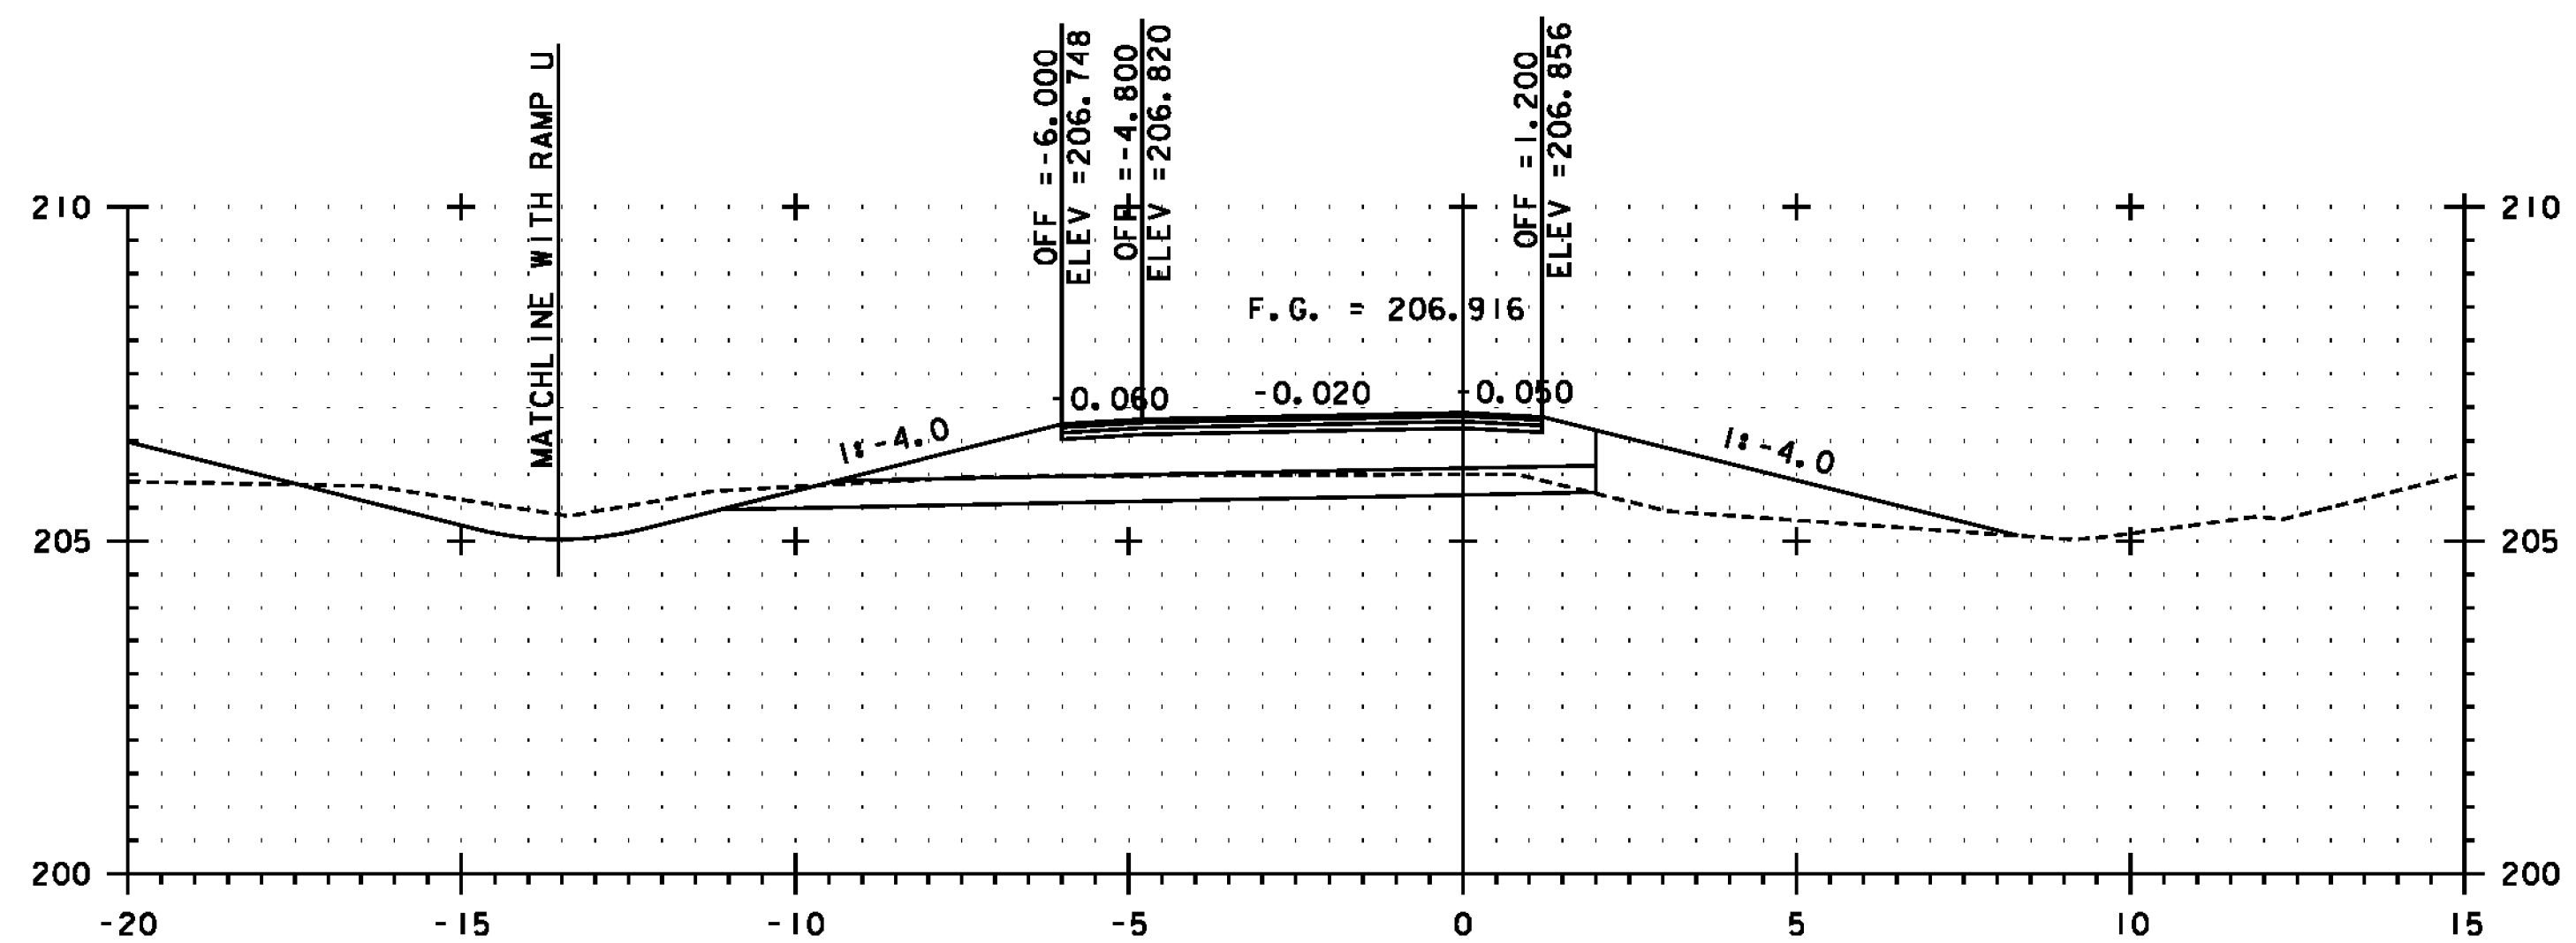

F 1+240

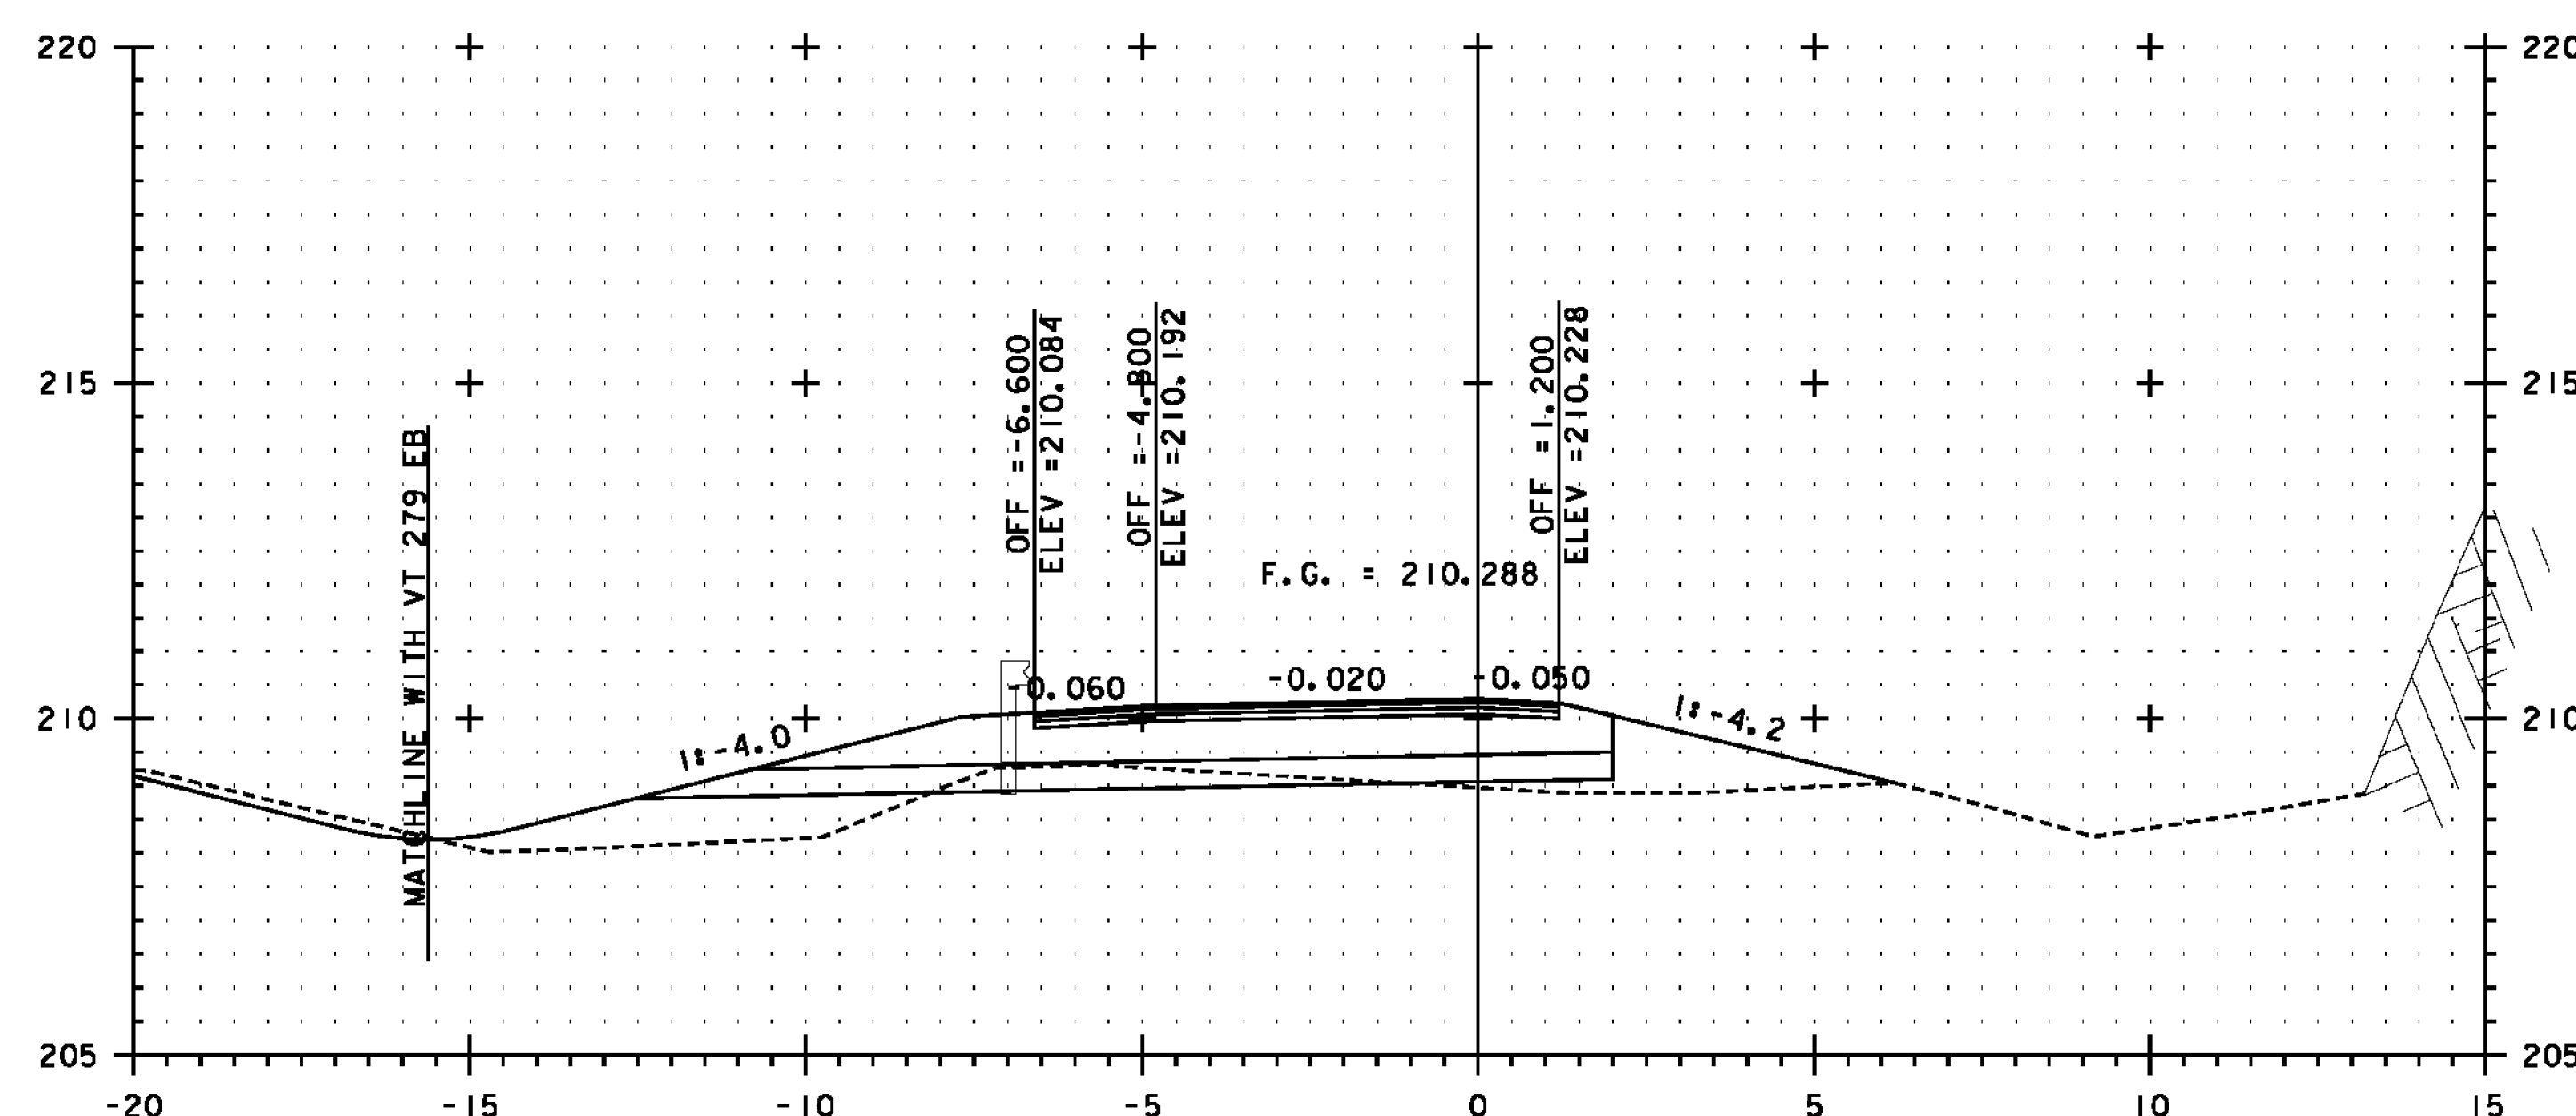


F 1+180

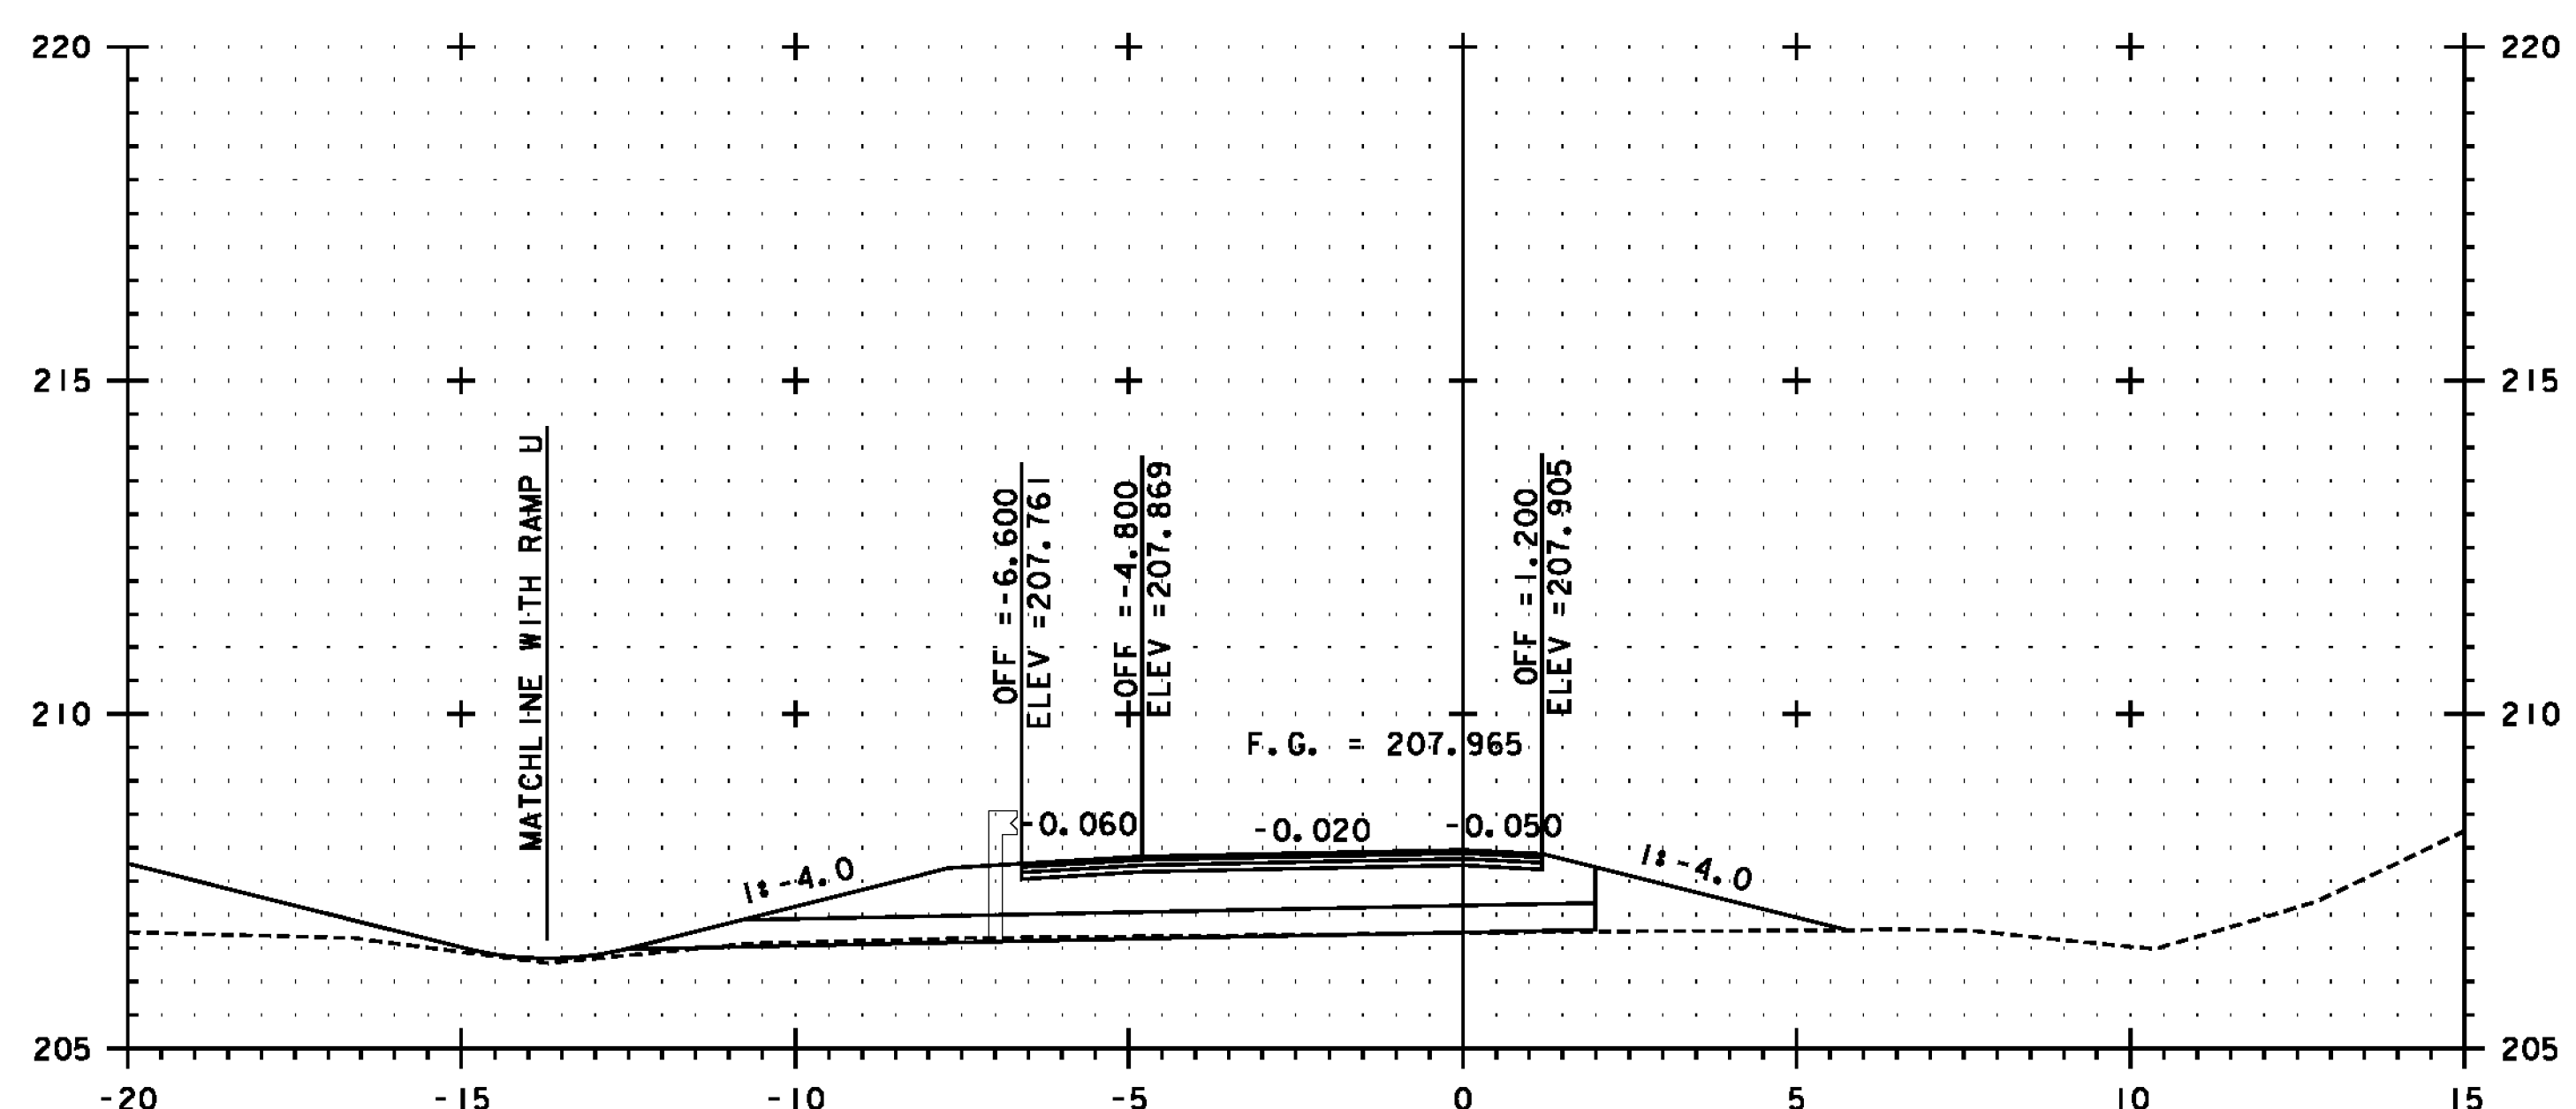

F 1+220

SEE NOTE ON SHEET 355

SEE REVISED SHEET

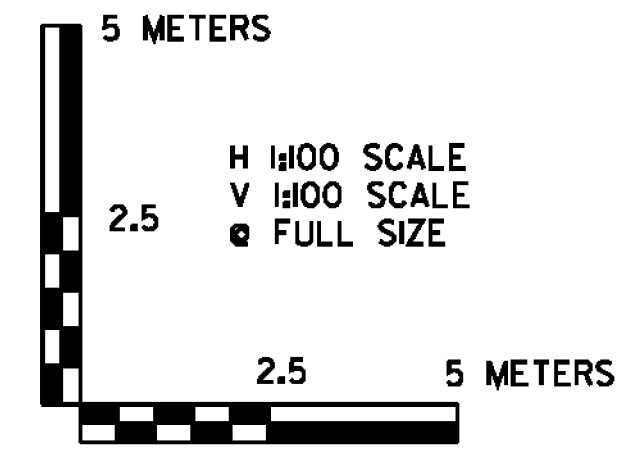

PROJECT NAME:	BENNINGTON
PROJECT NUMBER:	NH 019-(154)
FILE NAME:	...plot_files\zd307c4xs.rampF.pft
DESIGN SUPERVISOR:	GREG EDWARDS
DESIGNED BY:	MARC FOISY
DRAWN BY:	STANTEC
CHECKED BY:	GARY SANTY
RAMP F CROSS SECTION	FXS-03
	SHEET 357 OF 468

I:\2672010_45647_P1\1953\getlive\19530002\transportation\drw\ng\confr\01_4\plot_files\zd307c4xs.rampF.pft