




F I+407.465 = T I+000.000

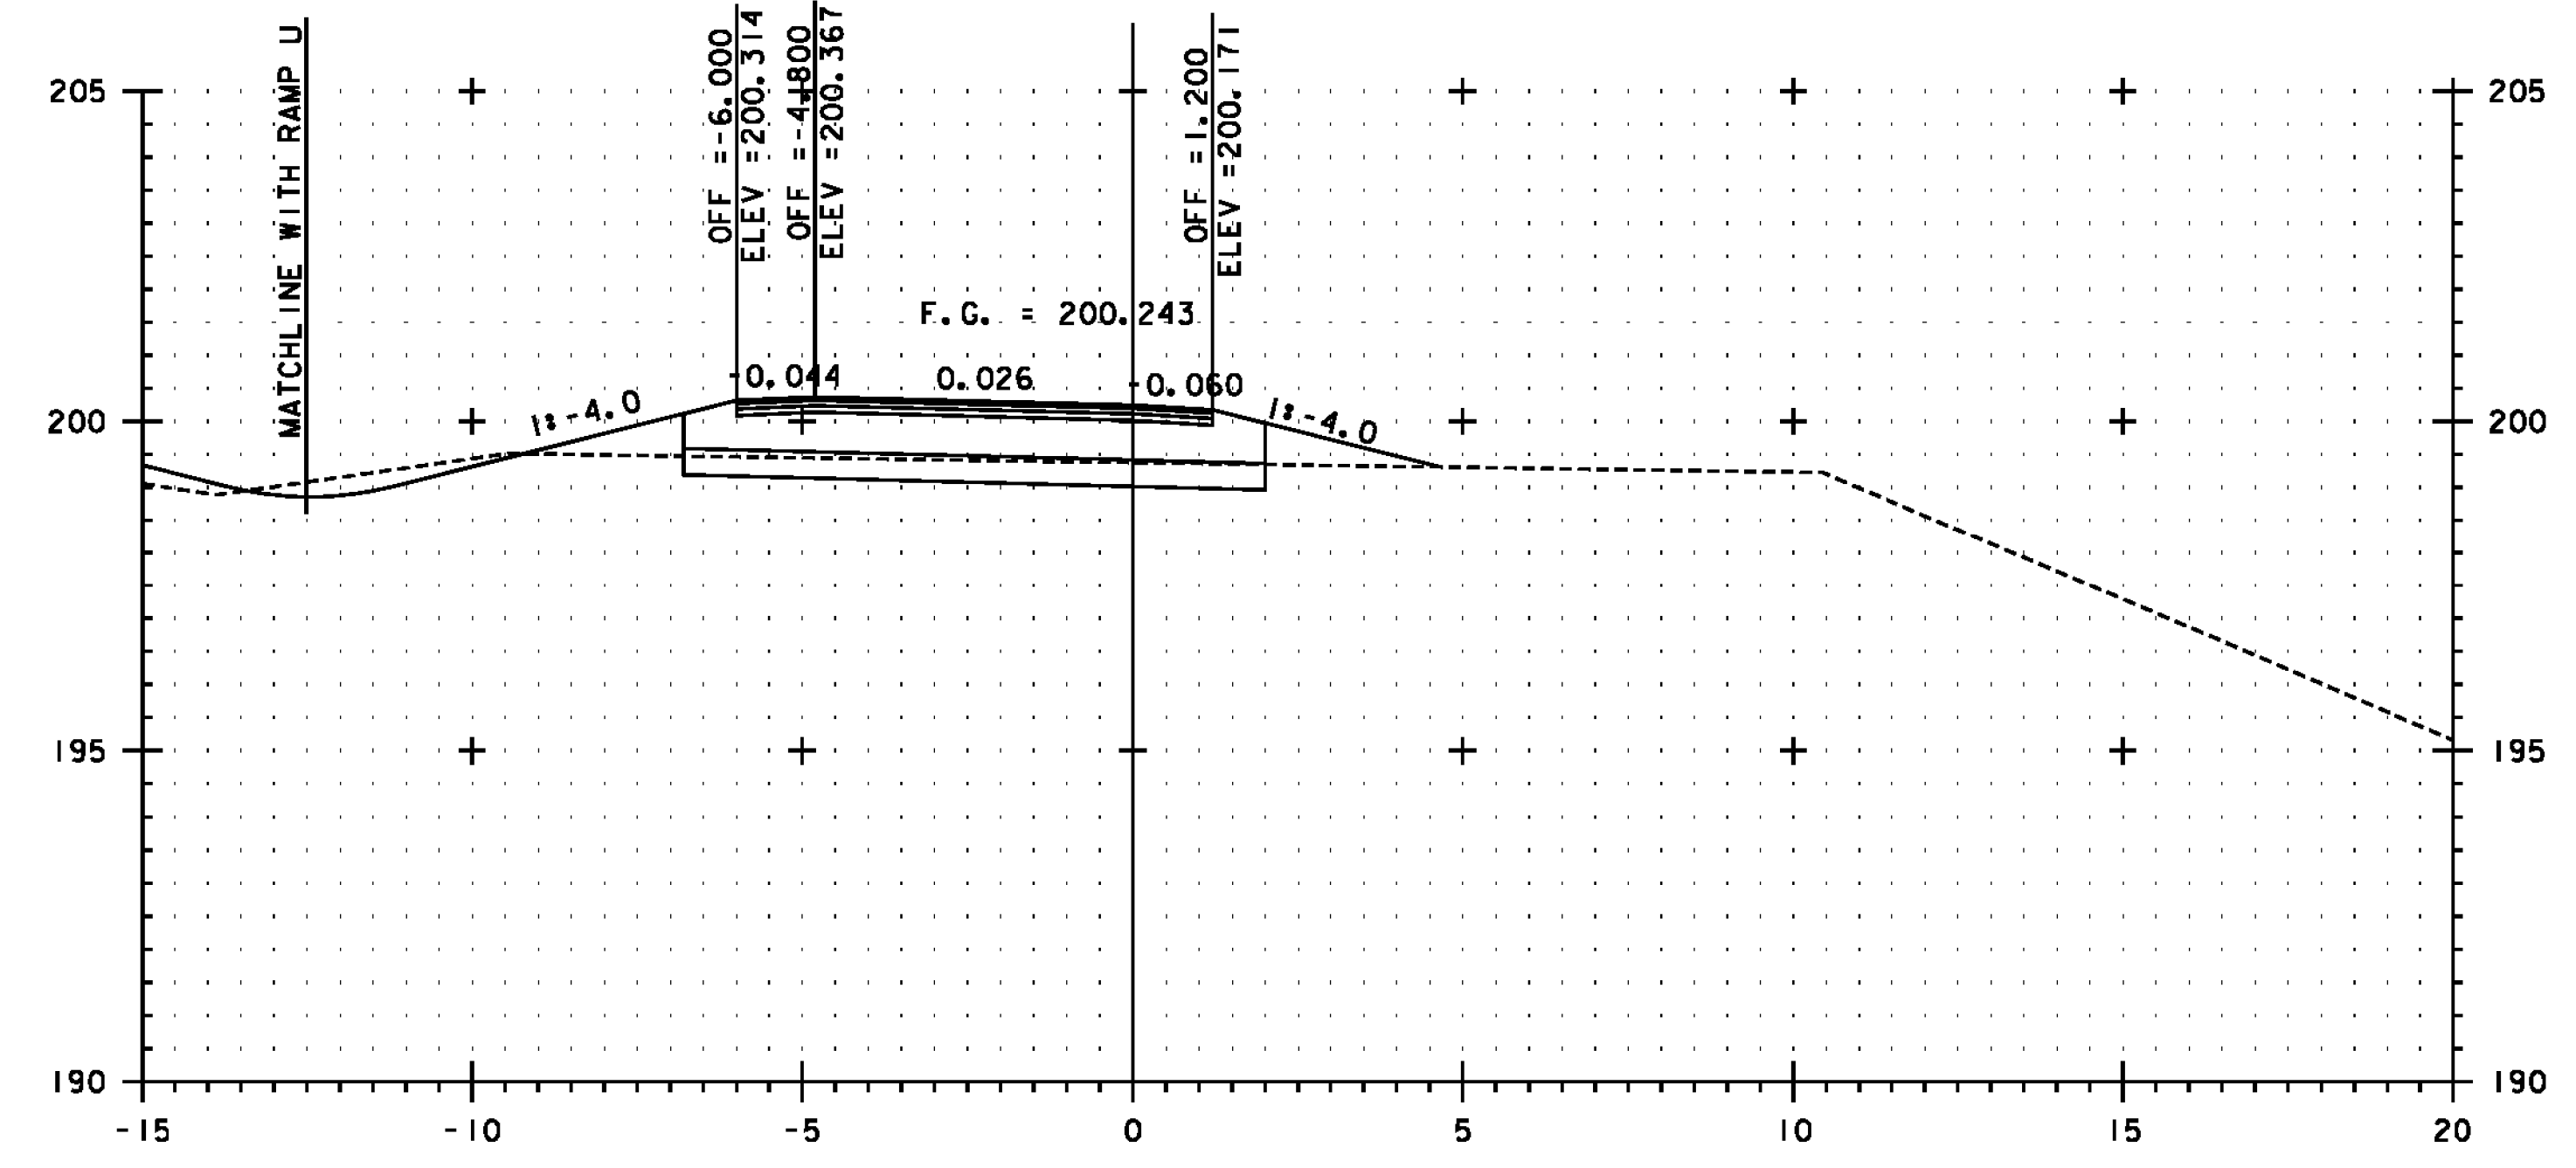


F I+400

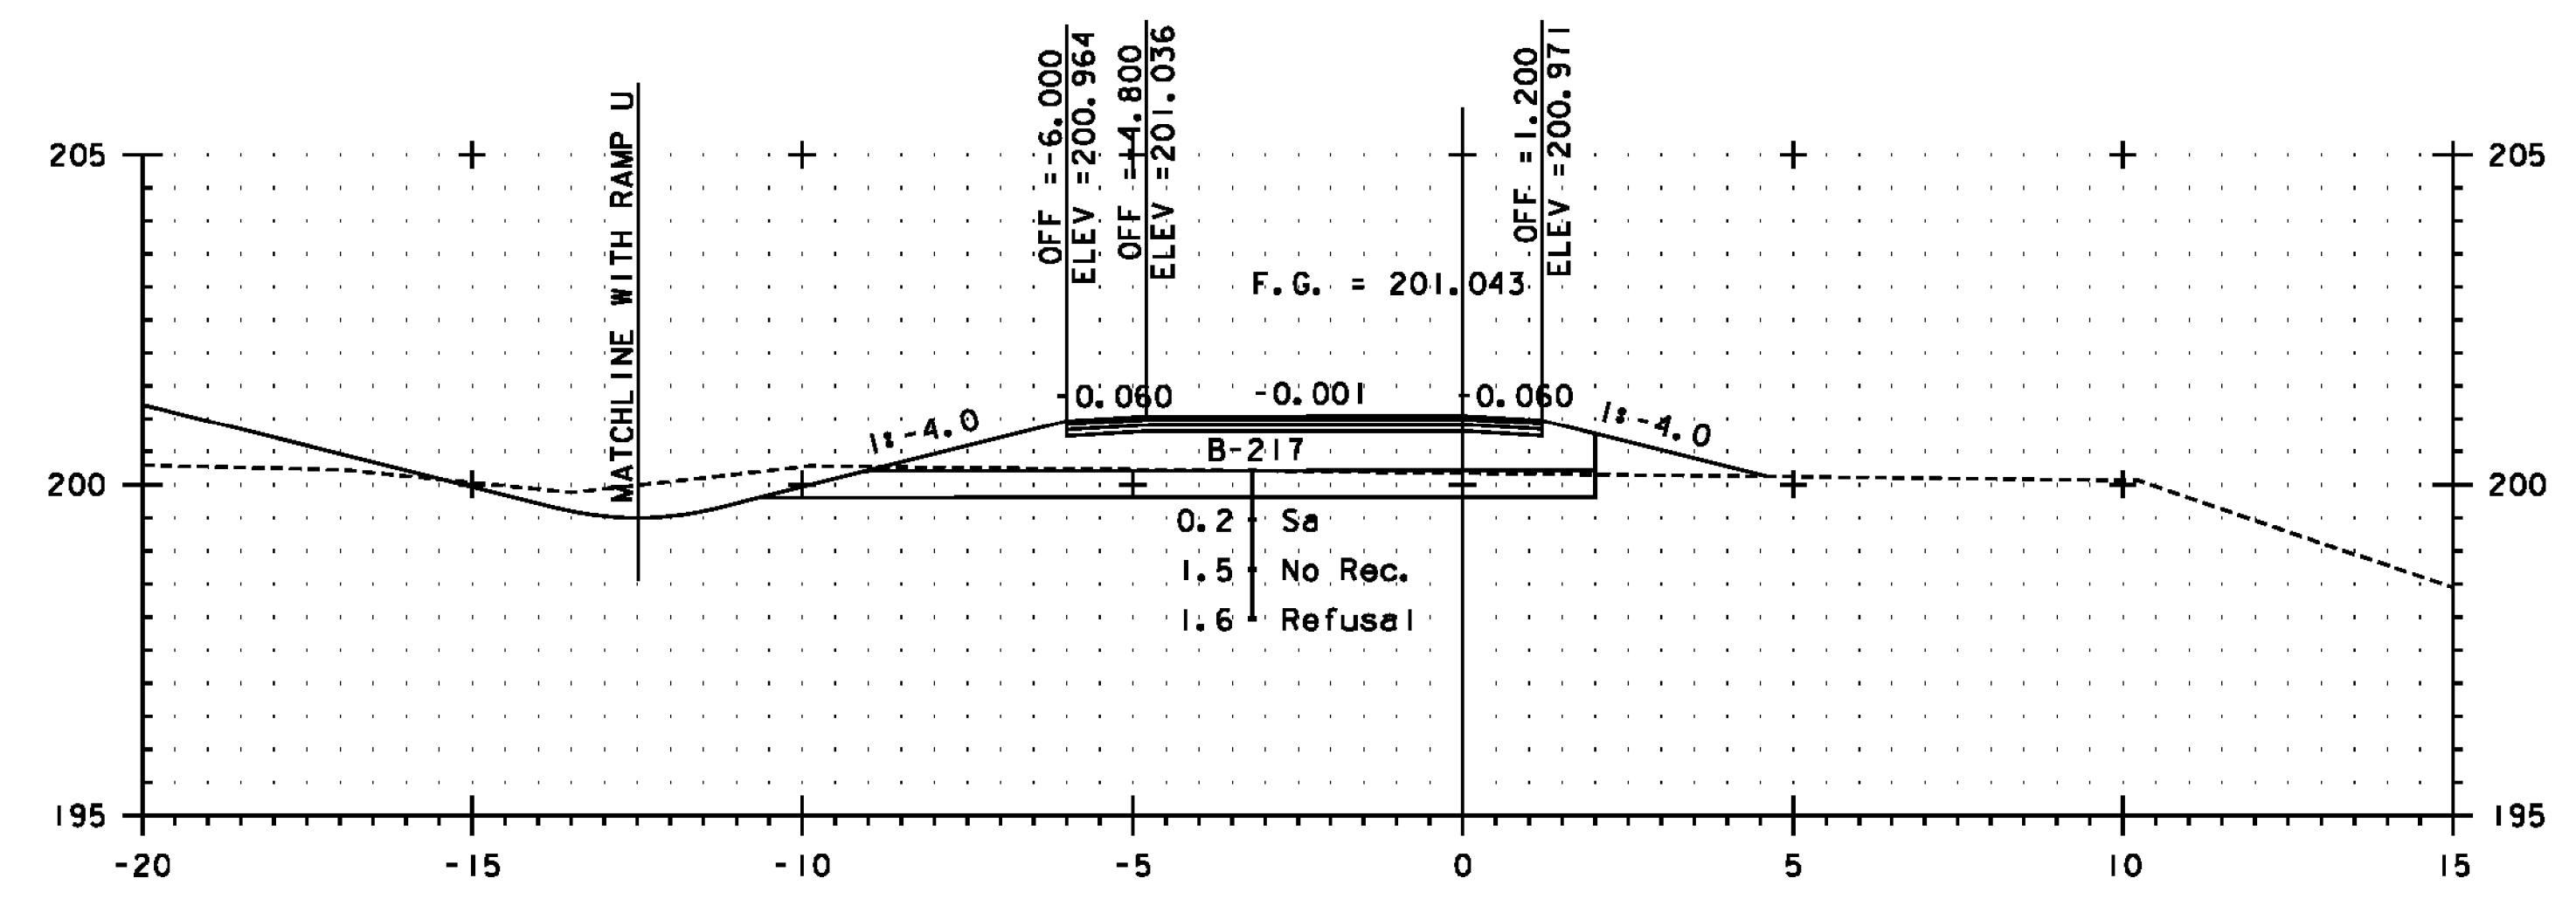

F I+380

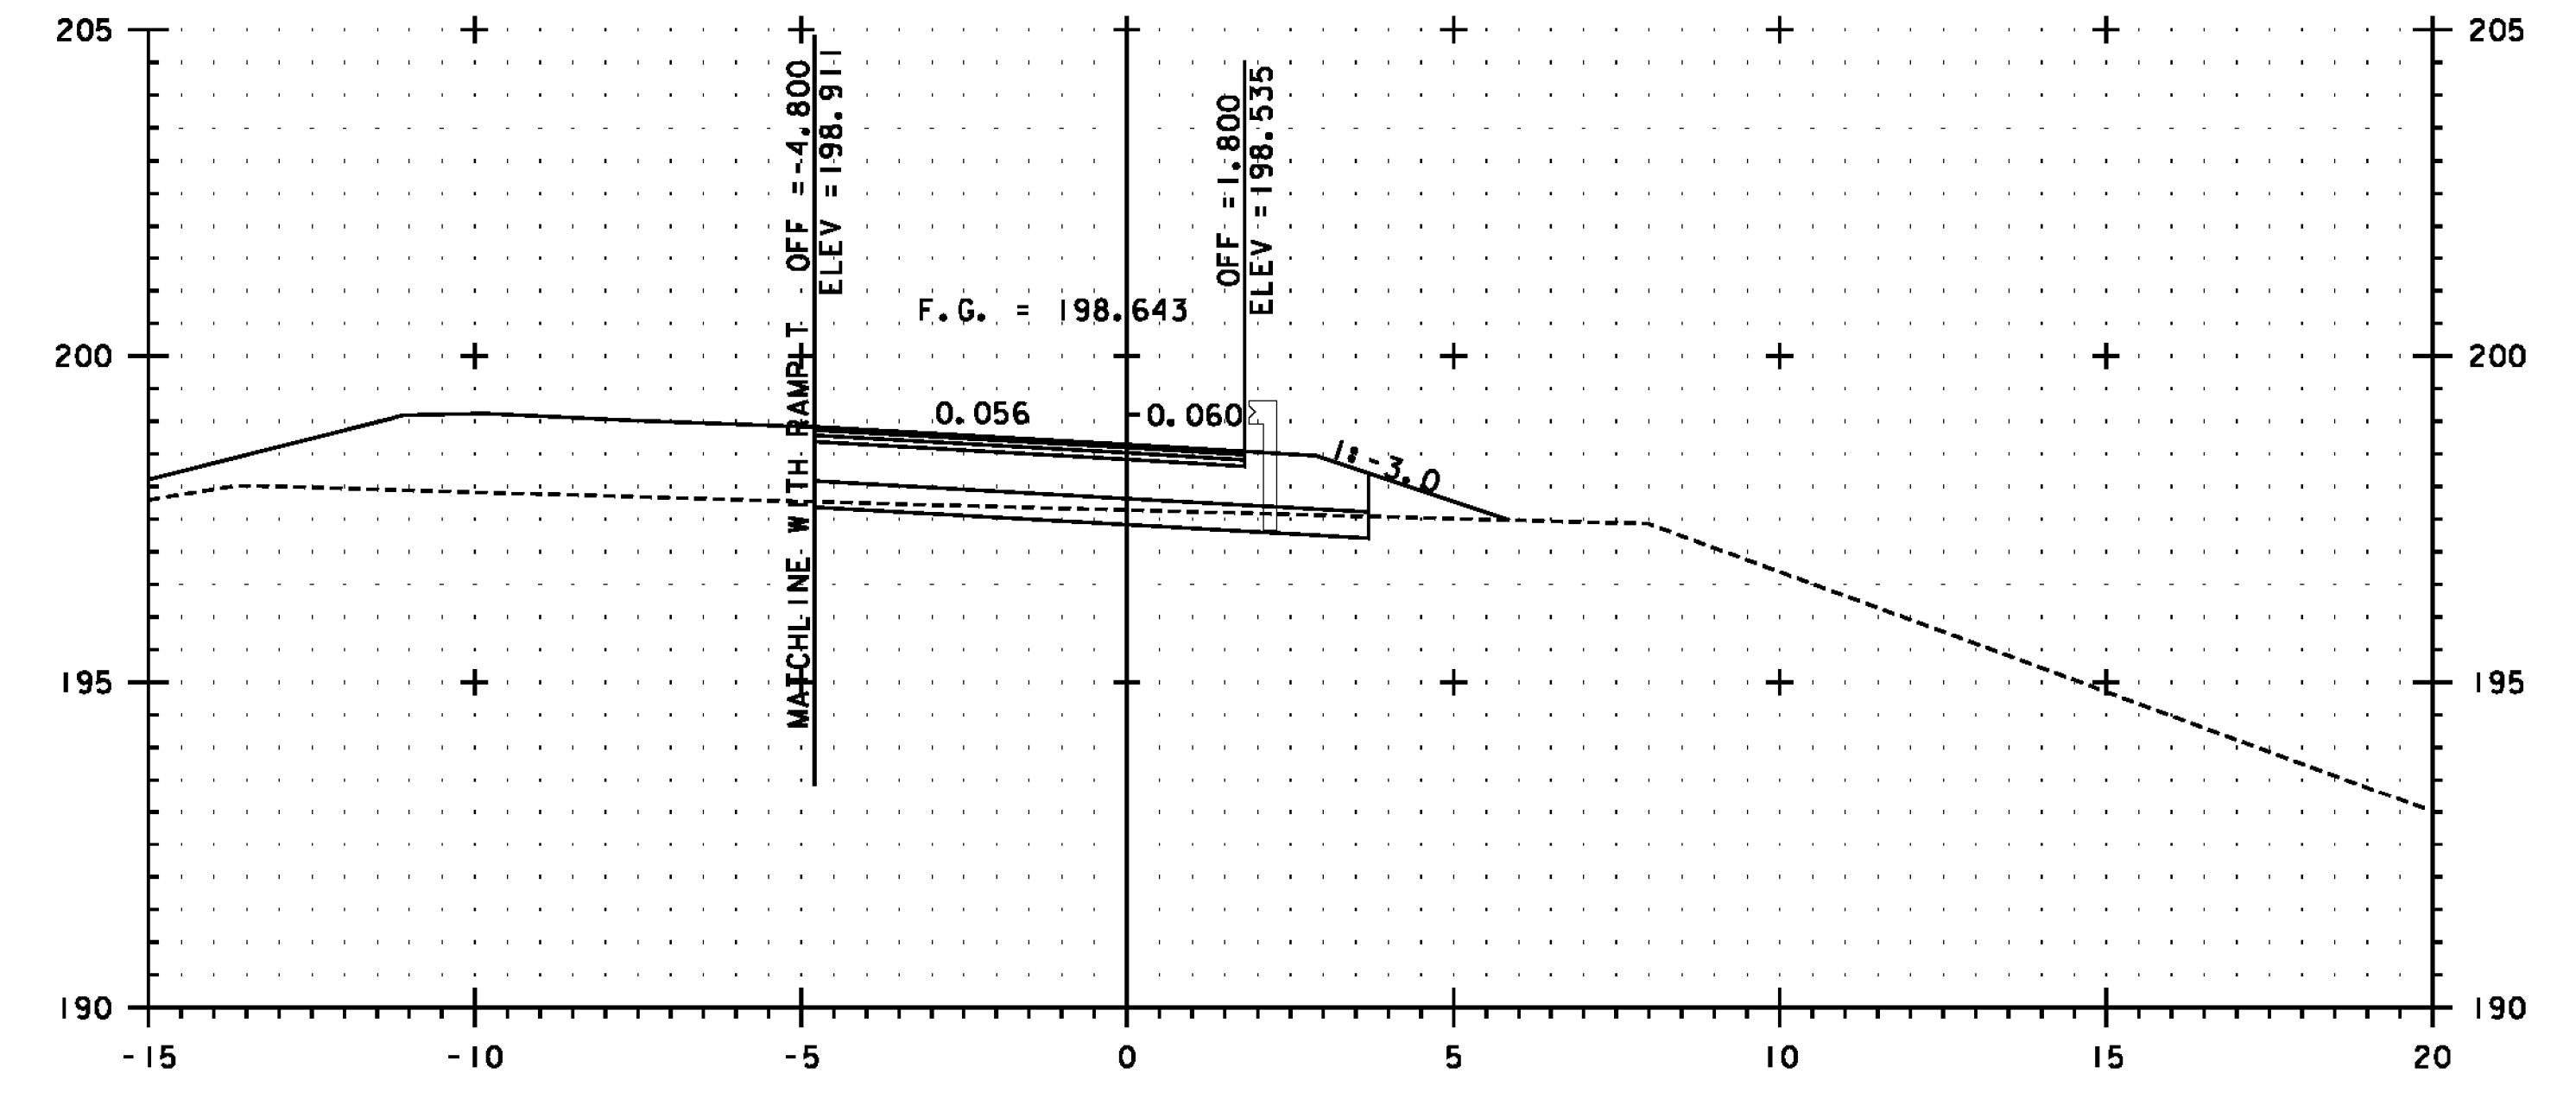


F I+440

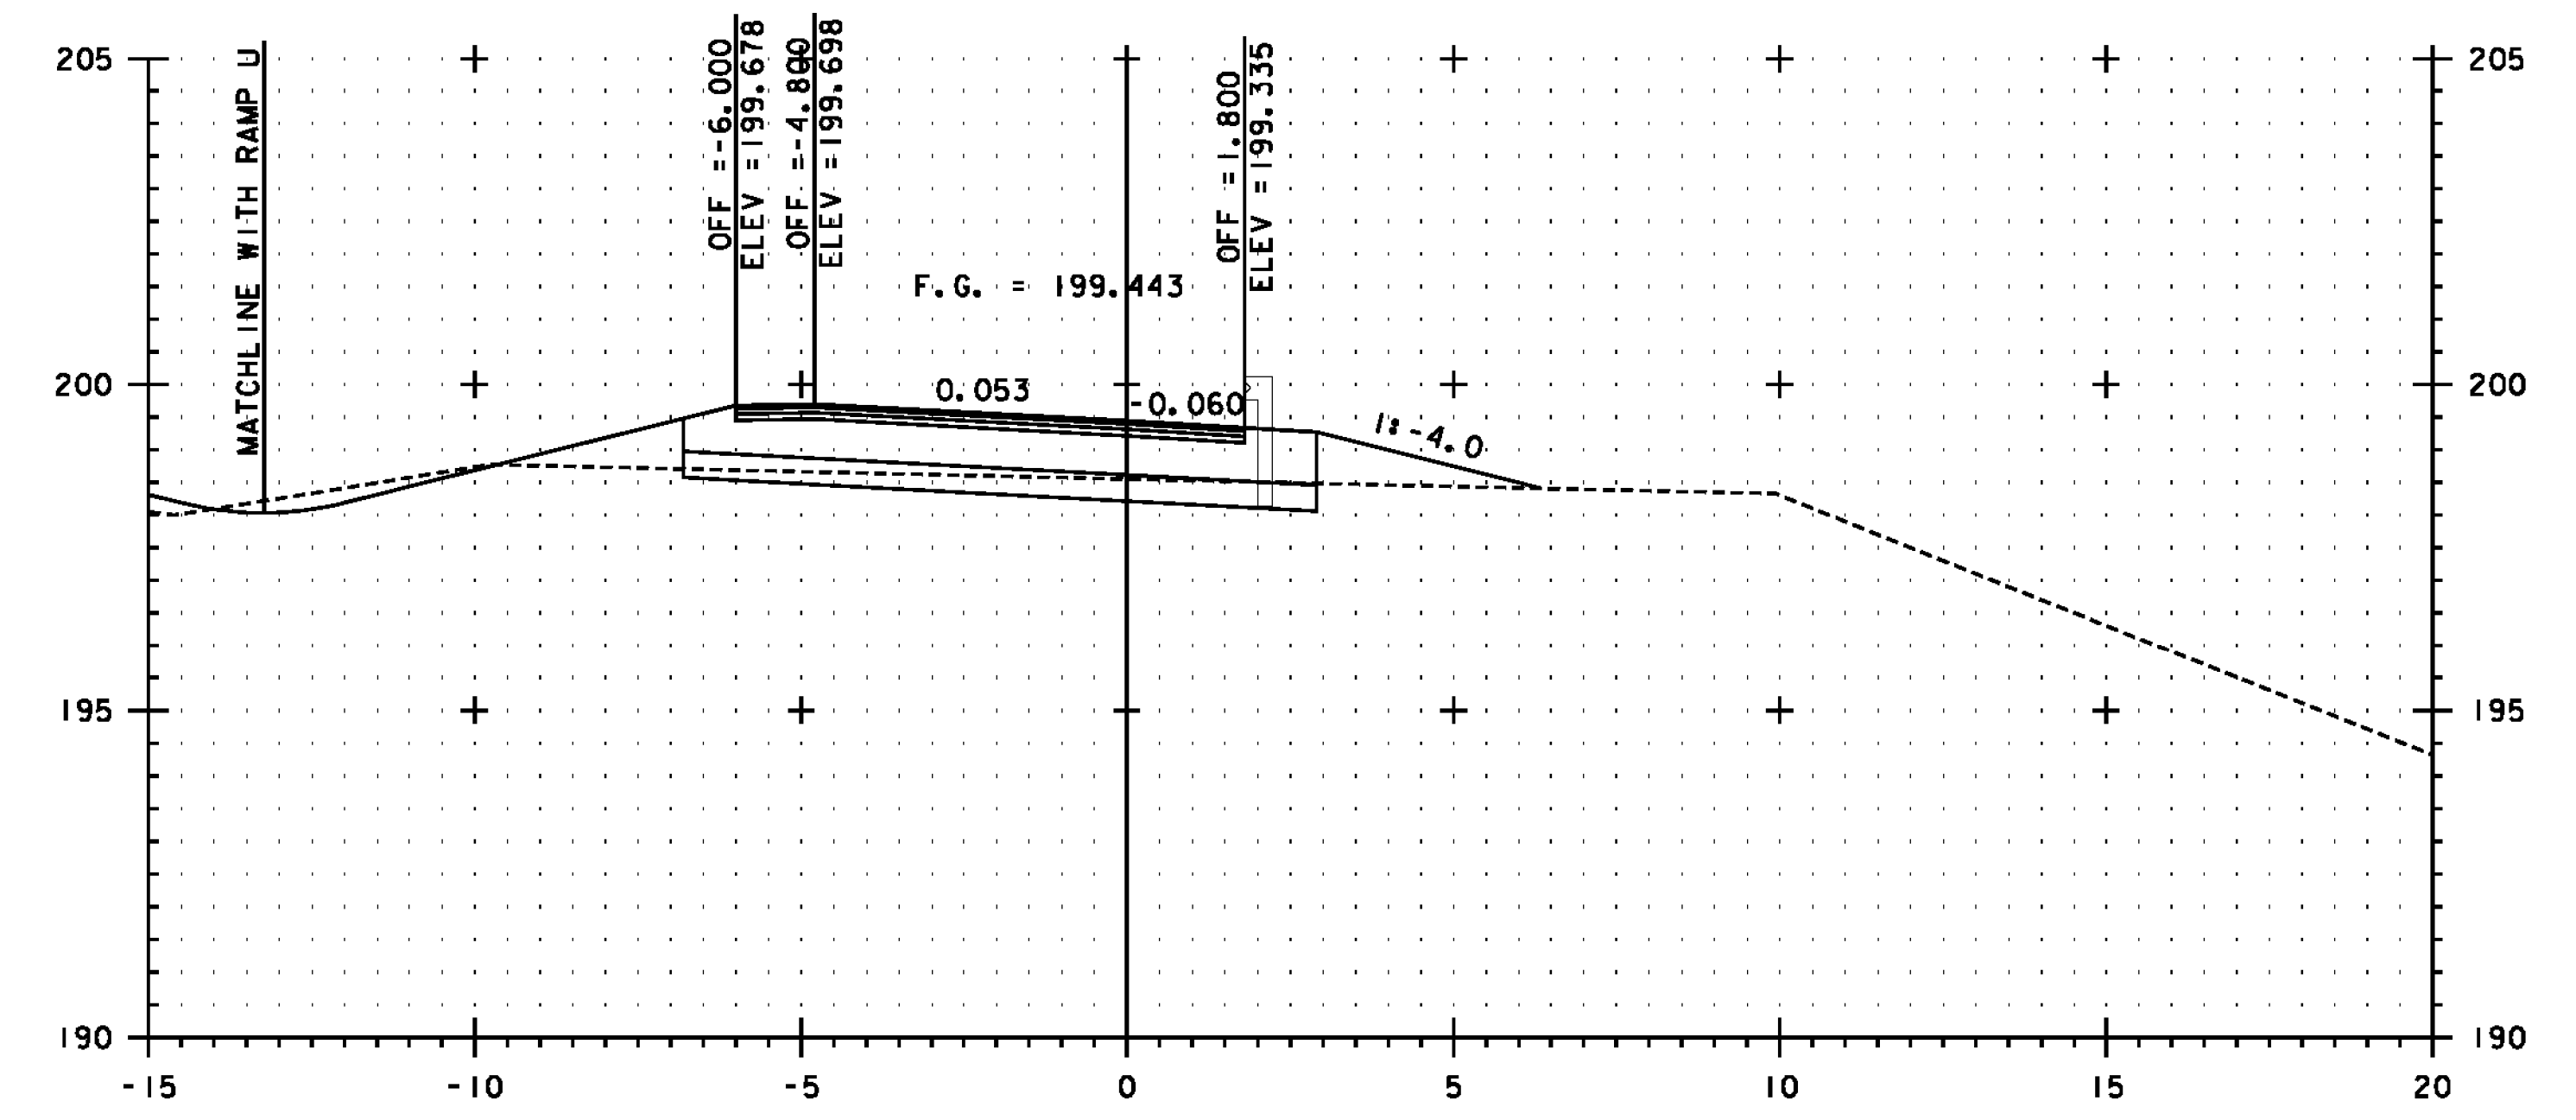

F I+420

SEE NOTE ON SHEET 355

SEE REVISED SHEETS

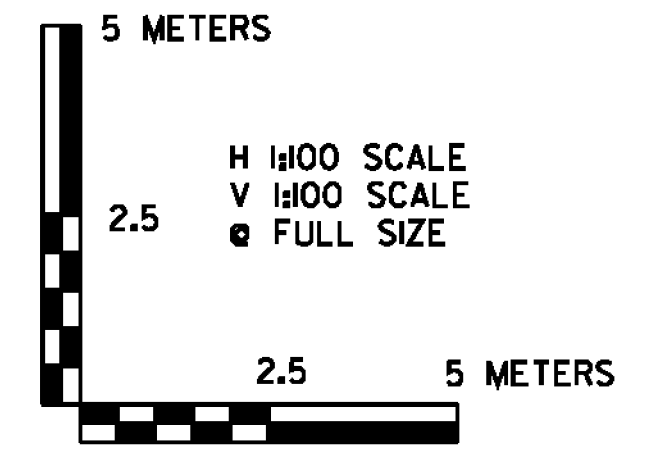

H 1:100 SCALE  
V 1:100 SCALE  
□ FULL SIZE



PROJECT NAME: BENNINGTON	
PROJECT NUMBER: NH 019-(154)	
FILE NAME: ...plot_files\zd307c4xs.rampF.ptf	PLOT DATE: 1/26/2010
DESIGN SUPERVISOR: GREG EDWARDS	DRAWN BY: STANTEC
DESIGNED BY: MARC FOISY	CHECKED BY: GARY SANTY
<b>RAMP F CROSS SECTION FXS-05</b>	SHEET 359 OF 468

1/26/2010 4:56:49 PM v:\1953\getlive\19530002\tr\anspor\station\dr\cwg\mg\confr\def\_4\plot\_files\zd307c4xs.rampF.ptf