




F I+360

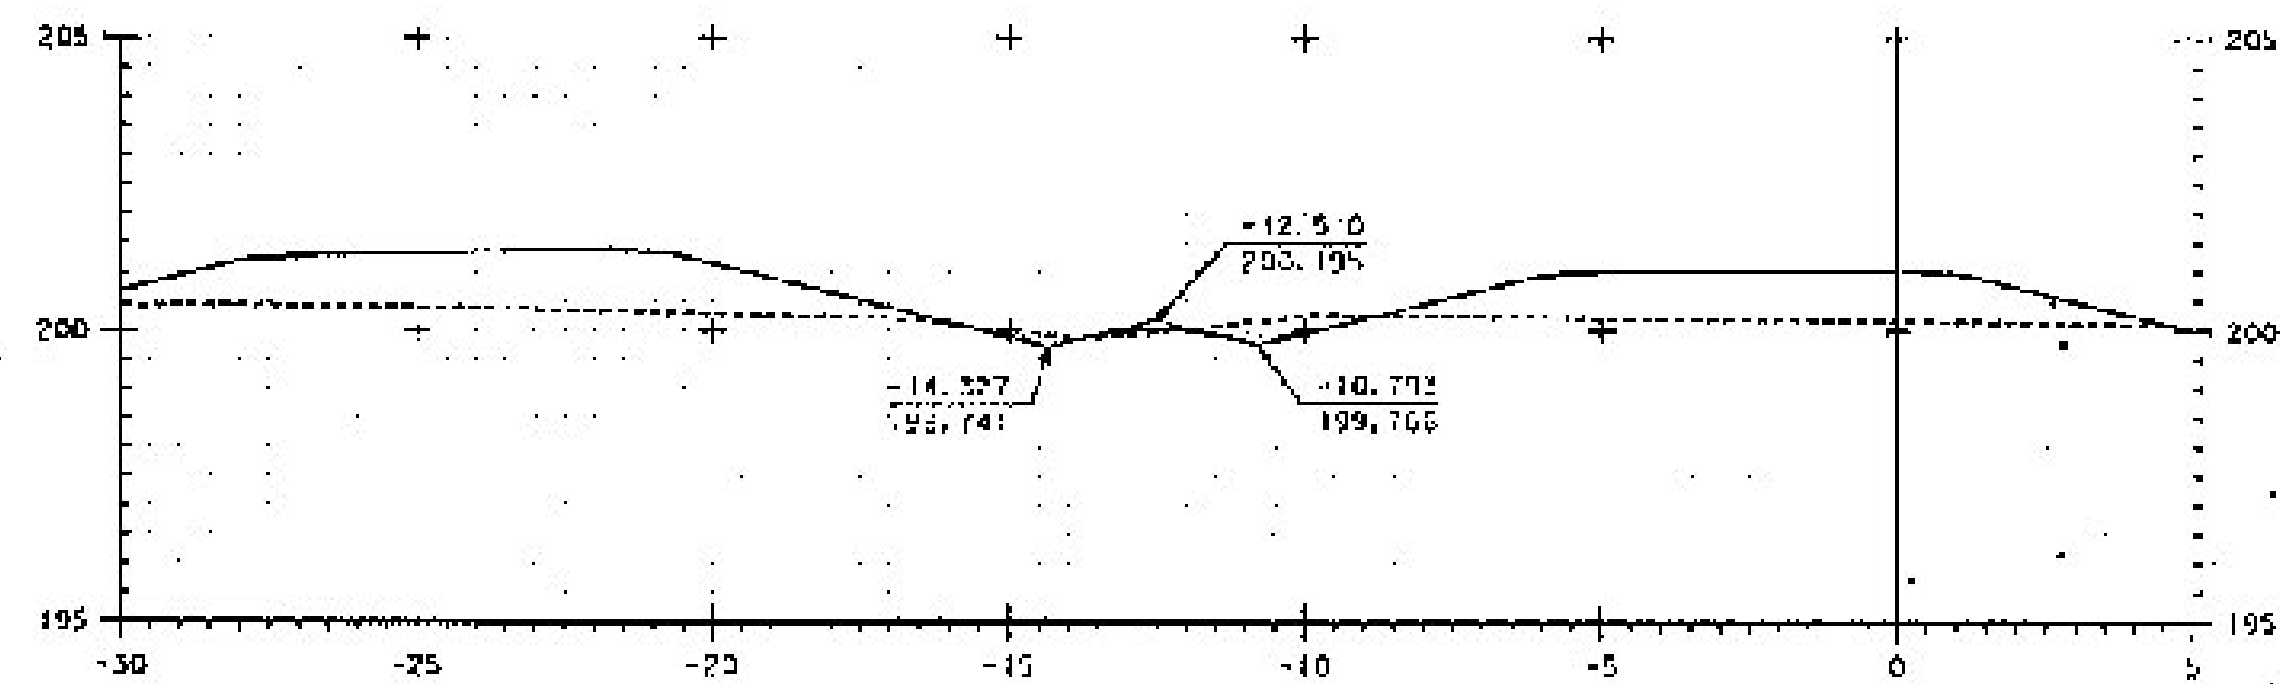

F I-360

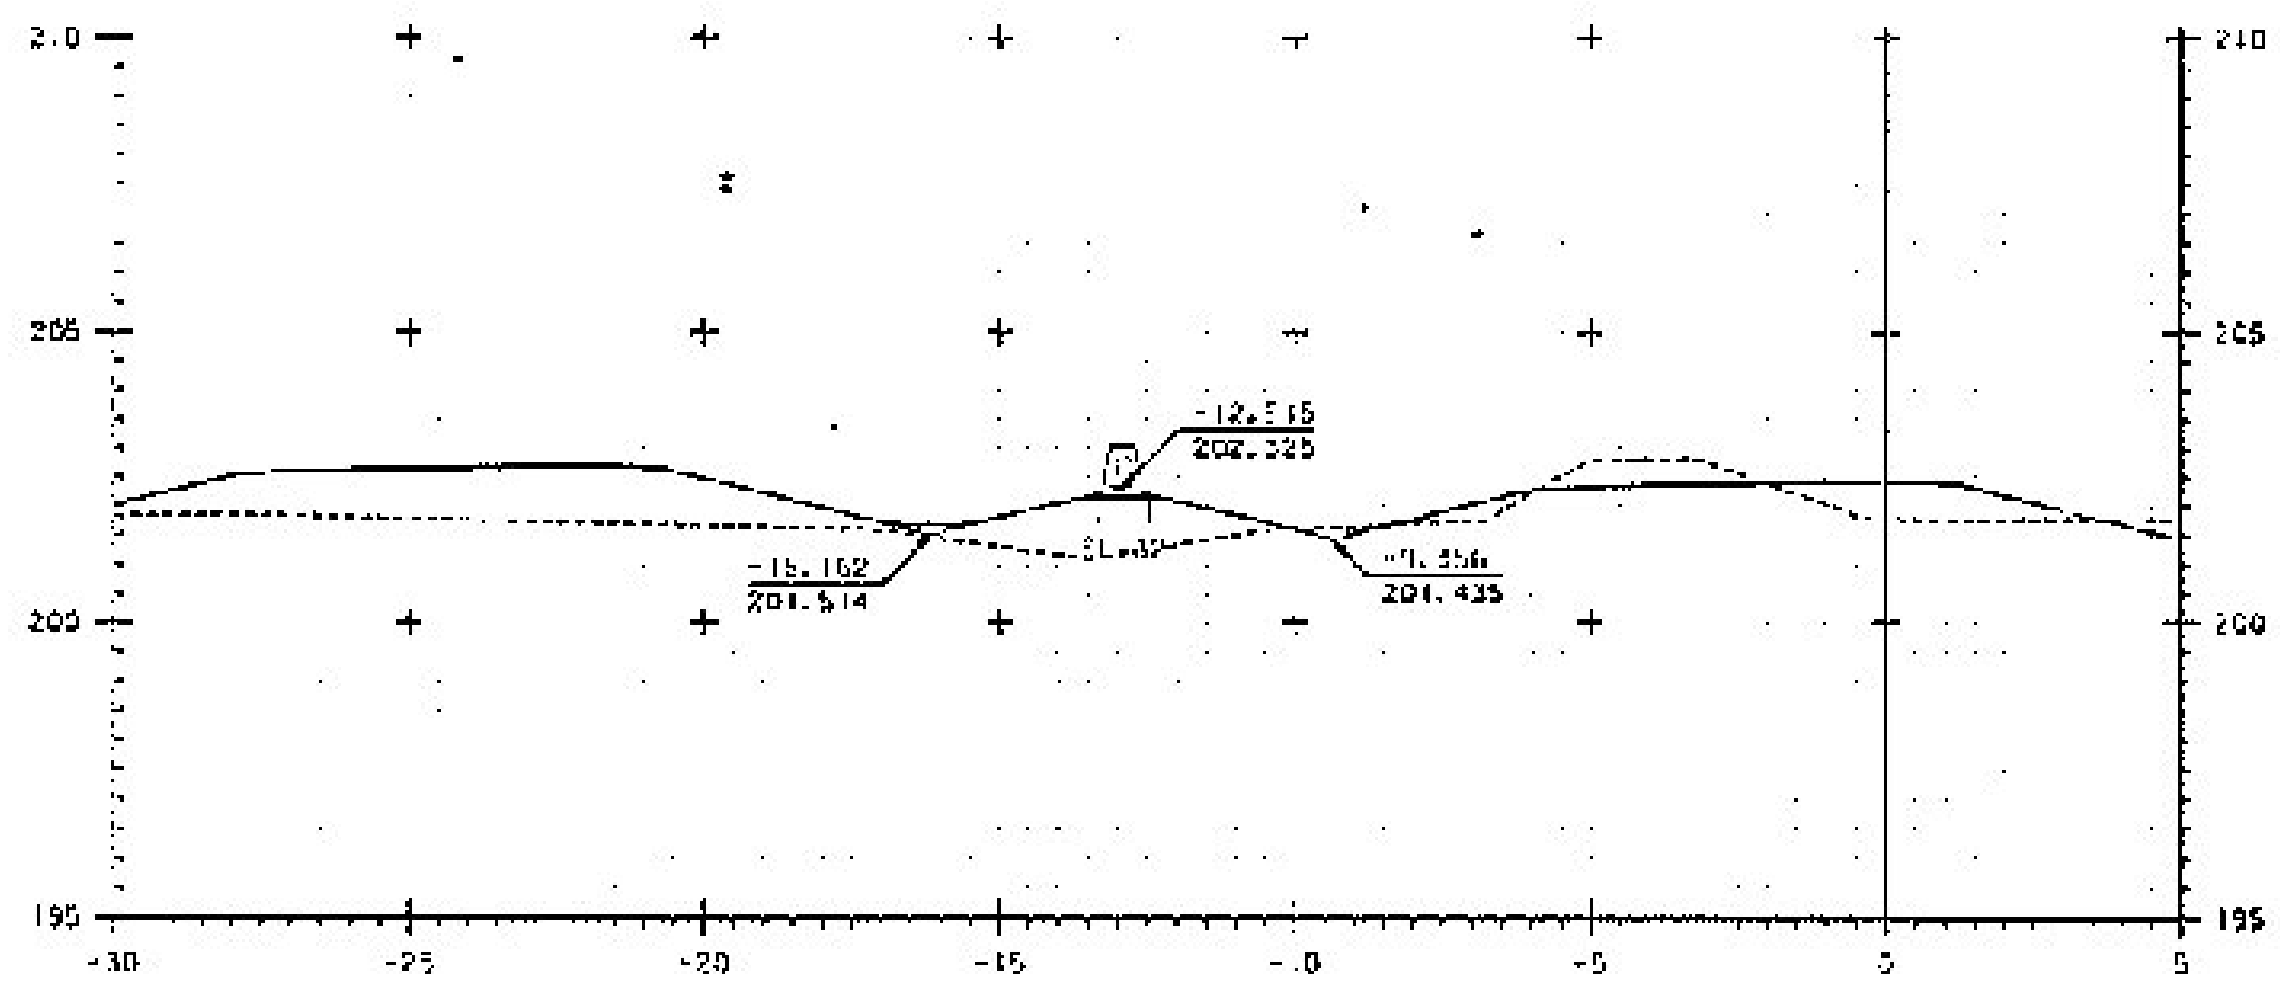

F I+345

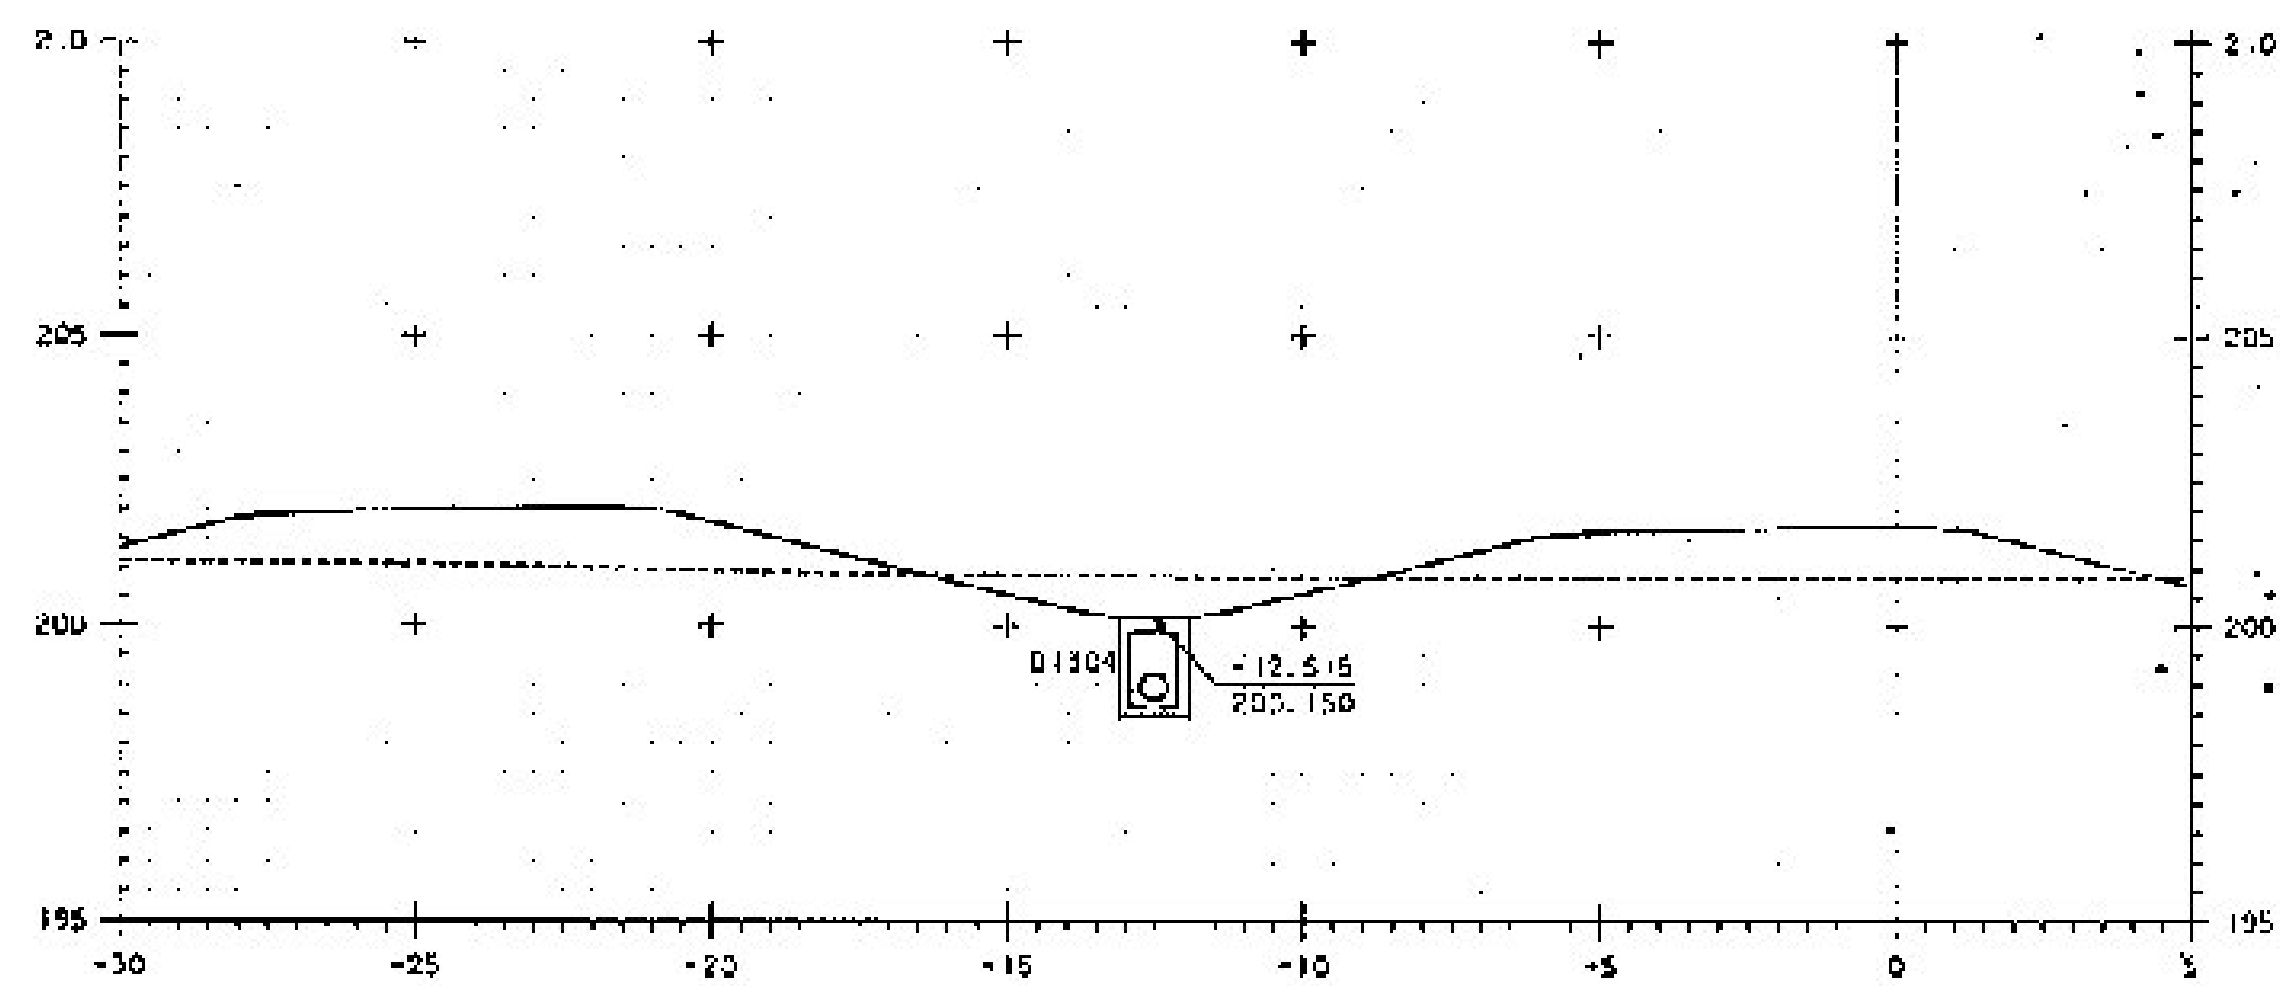

F I+362.747

LIGHT POLE
RECORD PLANS