



F 1+480

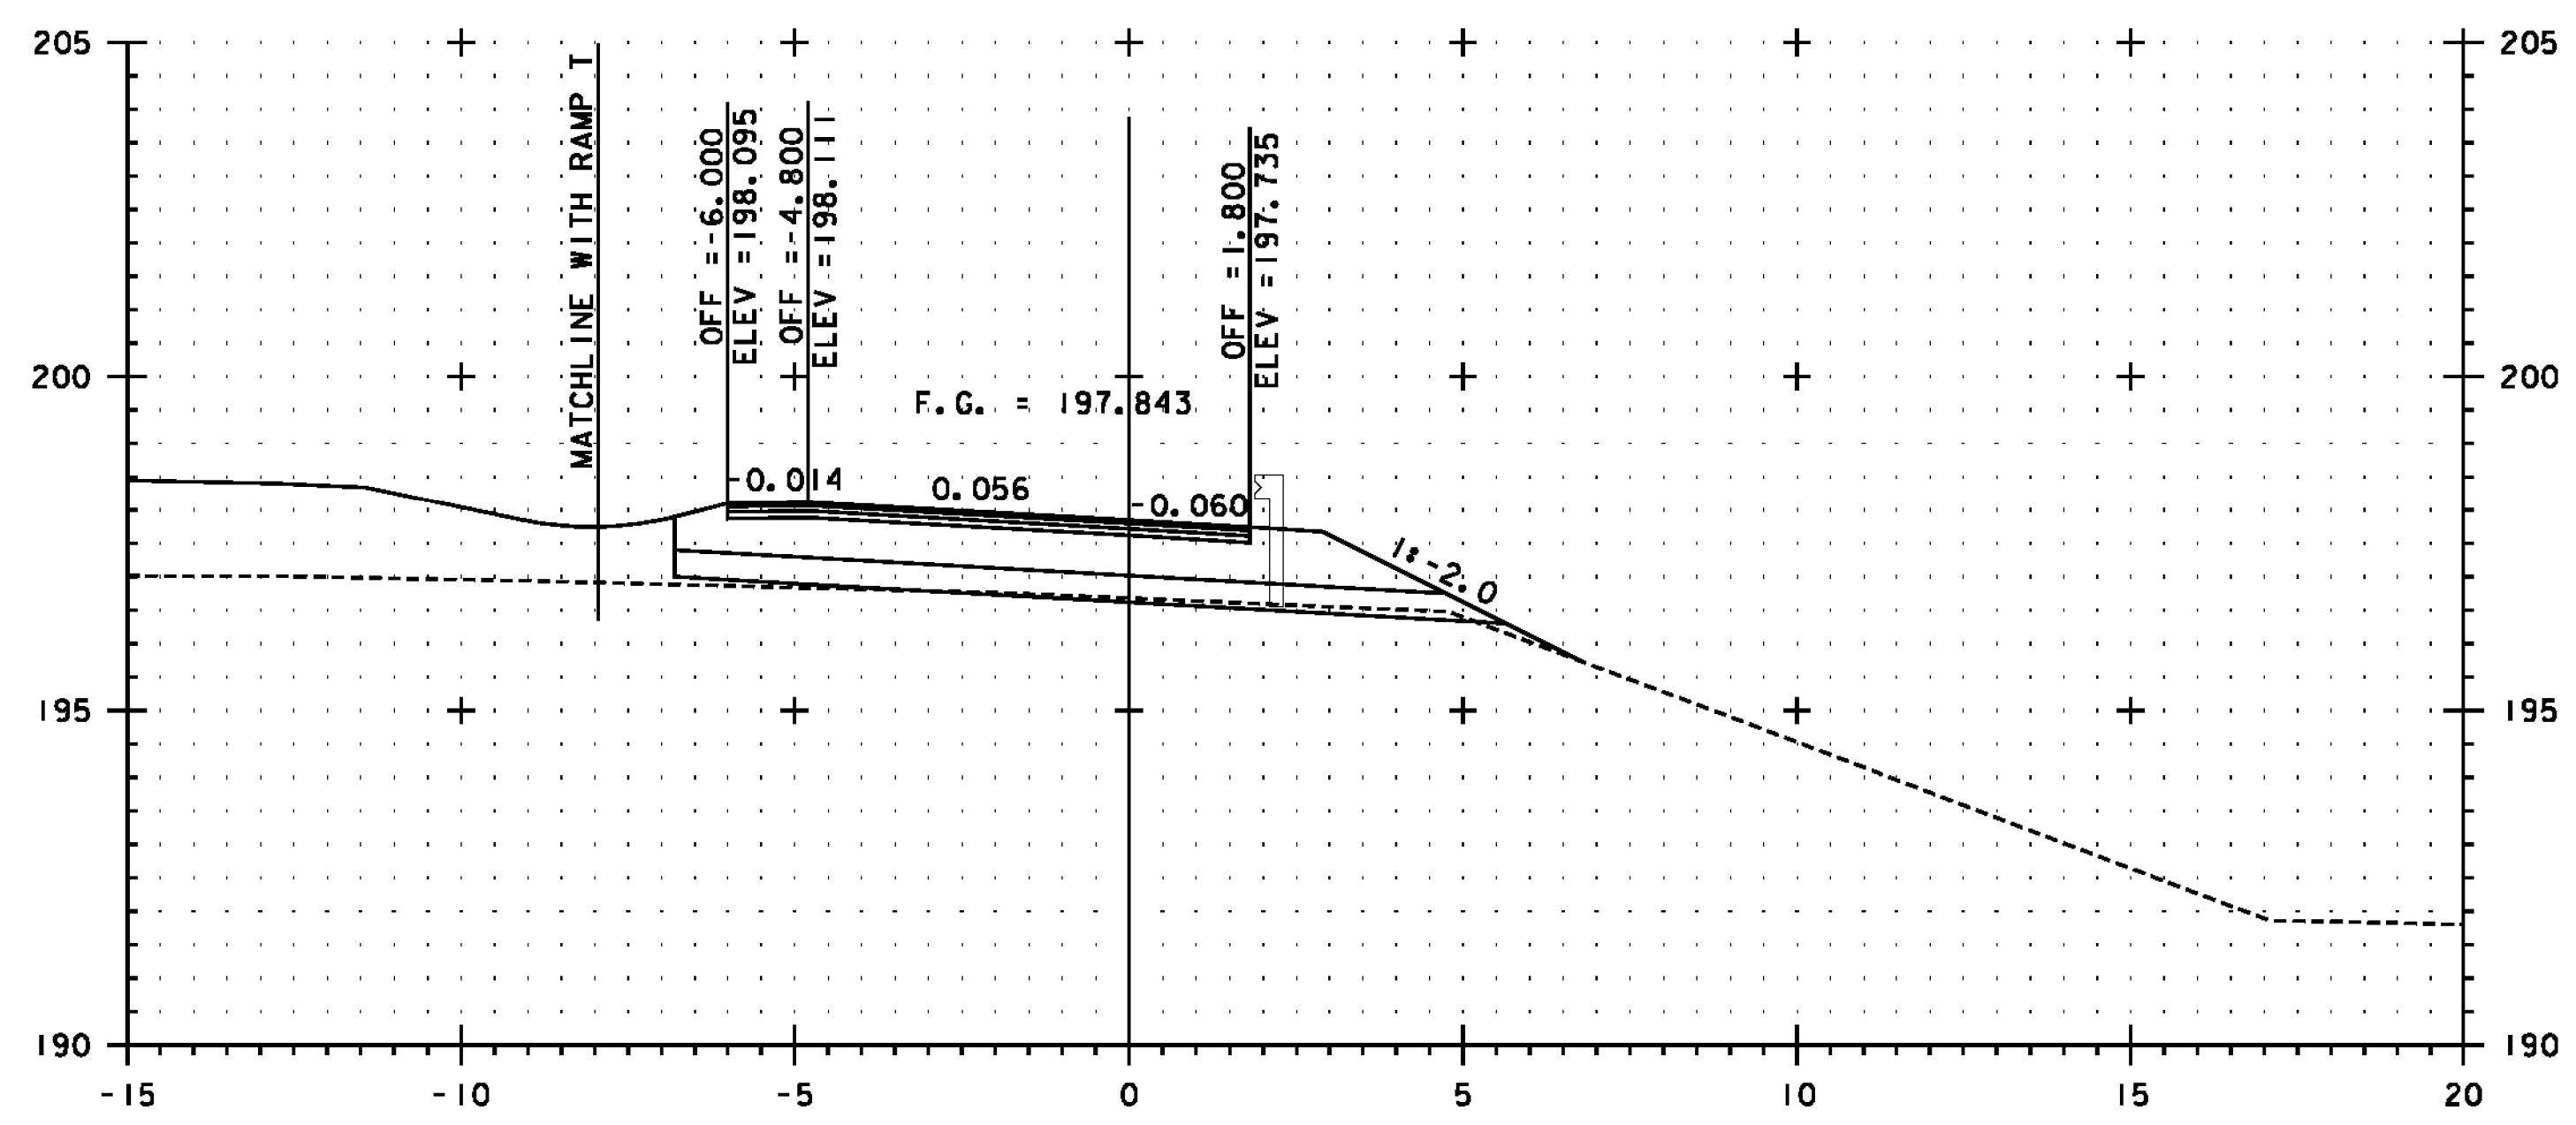


F 1+460

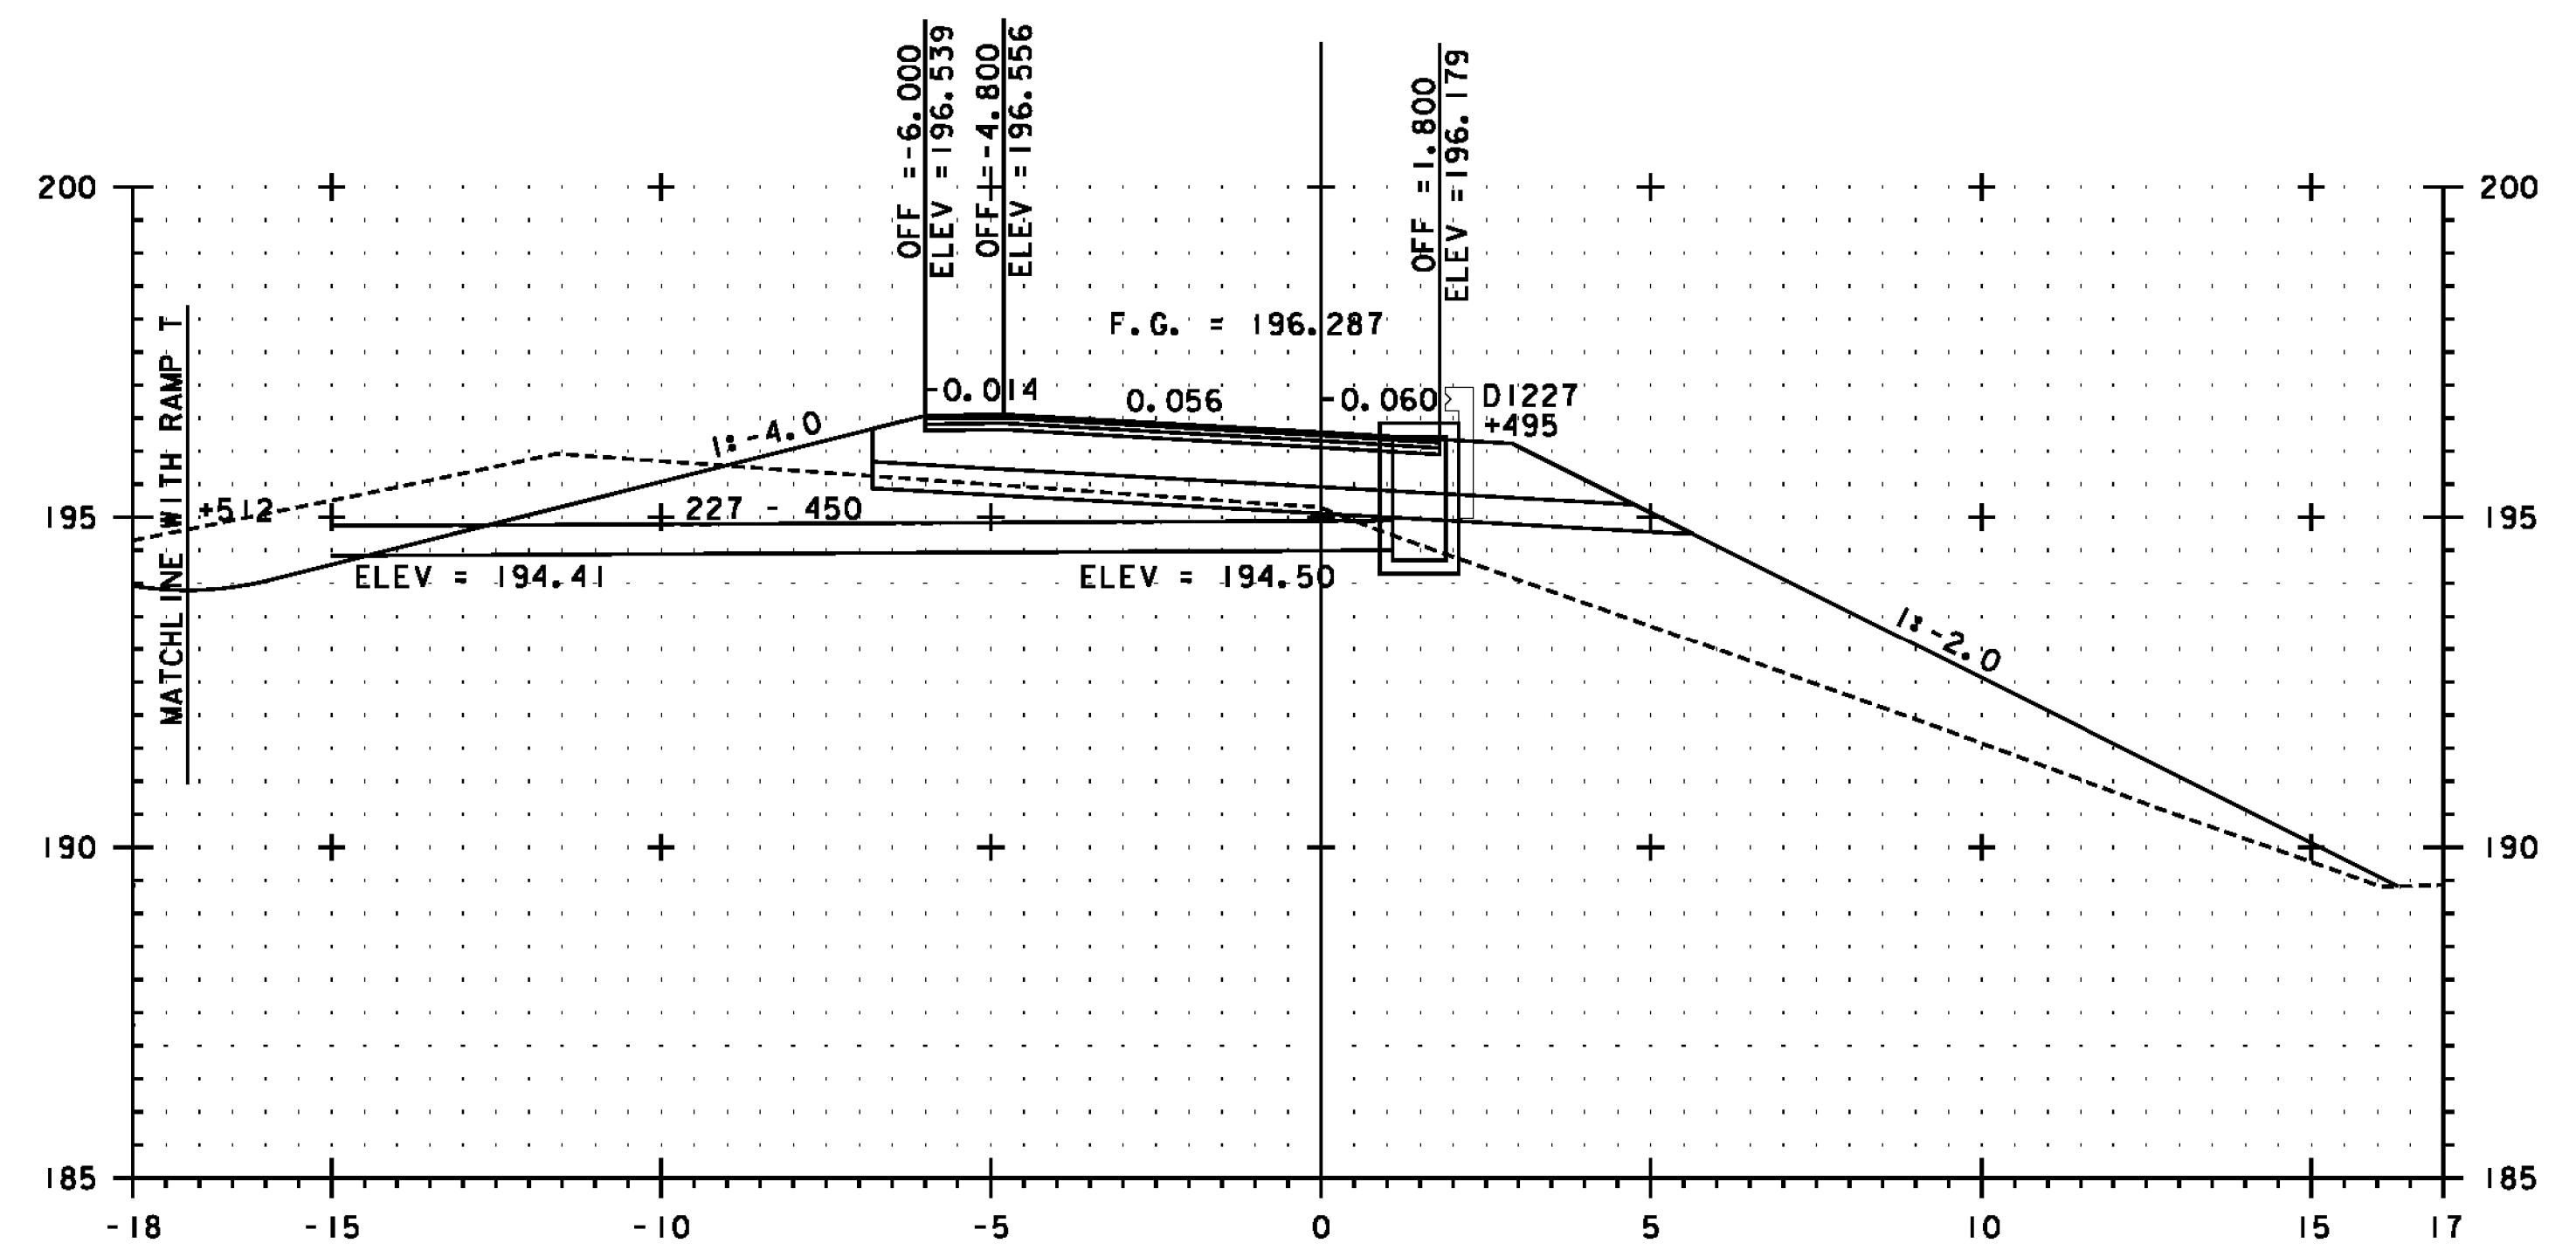

F 1+500

SEE NOTE ON SHEET 355

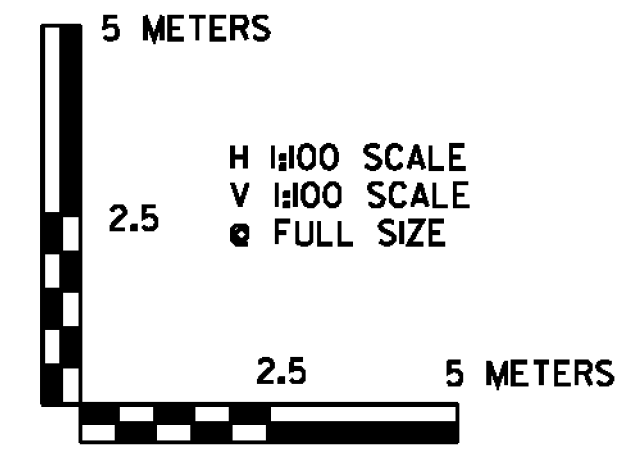

PROJECT NAME:	BENNINGTON
PROJECT NUMBER:	NH 019-(154)
FILE NAME:	...\\plot_files\zd307c4xs.rampF.ptf
PLOT DATE:	1/26/2010
DESIGN SUPERVISOR:	GREG EDWARDS
DRAWN BY:	STANTEC
DESIGNED BY:	MARC FOISY
CHECKED BY:	GARY SANTY
RAMP F CROSS SECTION	FXS-06
SHEET	360 OF 468

1/26/2010 4:56:50 PM v:\1953\getlive\1953\0002\tr\anspor\101\10\dr\dwg\con\tr\cst_4\plot_files\zd307c4xs.rampF.ptf