


SEE NOTE ON SHEET 355

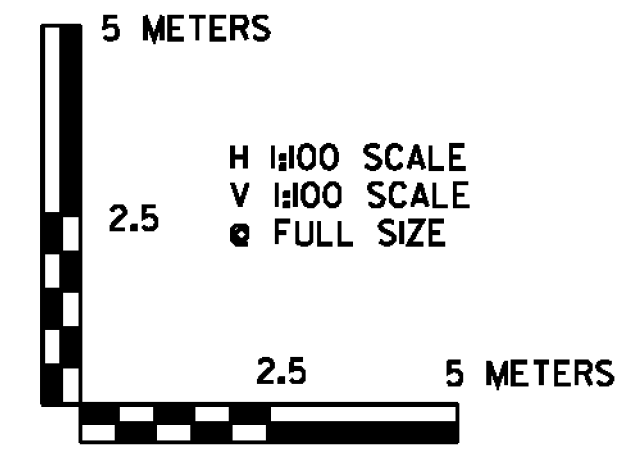

PROJECT NAME:	BENNINGTON
PROJECT NUMBER:	NH 019-1(54)
FILE NAME:	...plot_files\zd307c4xs.rampF.pft
DESIGN SUPERVISOR:	GREG EDWARDS
DESIGNED BY:	MARC FOISY
RAMP F CROSS SECTION FXS-08	
PLOT DATE:	1/26/2010
DRAWN BY:	STANTEC
CHECKED BY:	GARY SANTY
SHEET	362 OF 468

1/26/2010 4:56:52 PM v:\1953\getlive\19530002\transportation\dr\cwg\mg\confr\def_4\plot_files\zd307c4xs.rampF.pft