


SEE NOTE ON SHEET 355

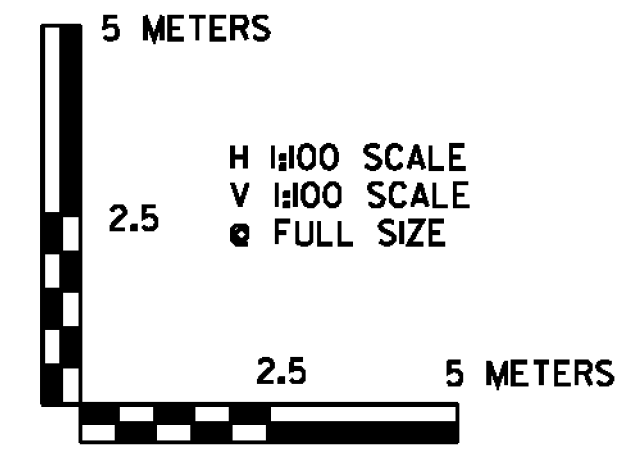

PROJECT NAME:	BENNINGTON
PROJECT NUMBER:	NH 019-(54)
FILE NAME:	...plot_files\zd307c4xs.rampF.ptf
DESIGN SUPERVISOR:	GREG EDWARDS
DESIGNED BY:	MARC FOISY
RAMP F CROSS SECTION:	FXS-09
PLOT DATE:	1/26/2010
DRAWN BY:	STANTEC
CHECKED BY:	GARY SANTY
SHEET:	363 OF 468

1/26/2010 4:56:53 PM v:\1953\getlive\1953\002A\trampF\plot\_files\zd307c4xs.rampF.ptf