


F 1+660



F 1+640

SEE NOTE ON SHEET 355

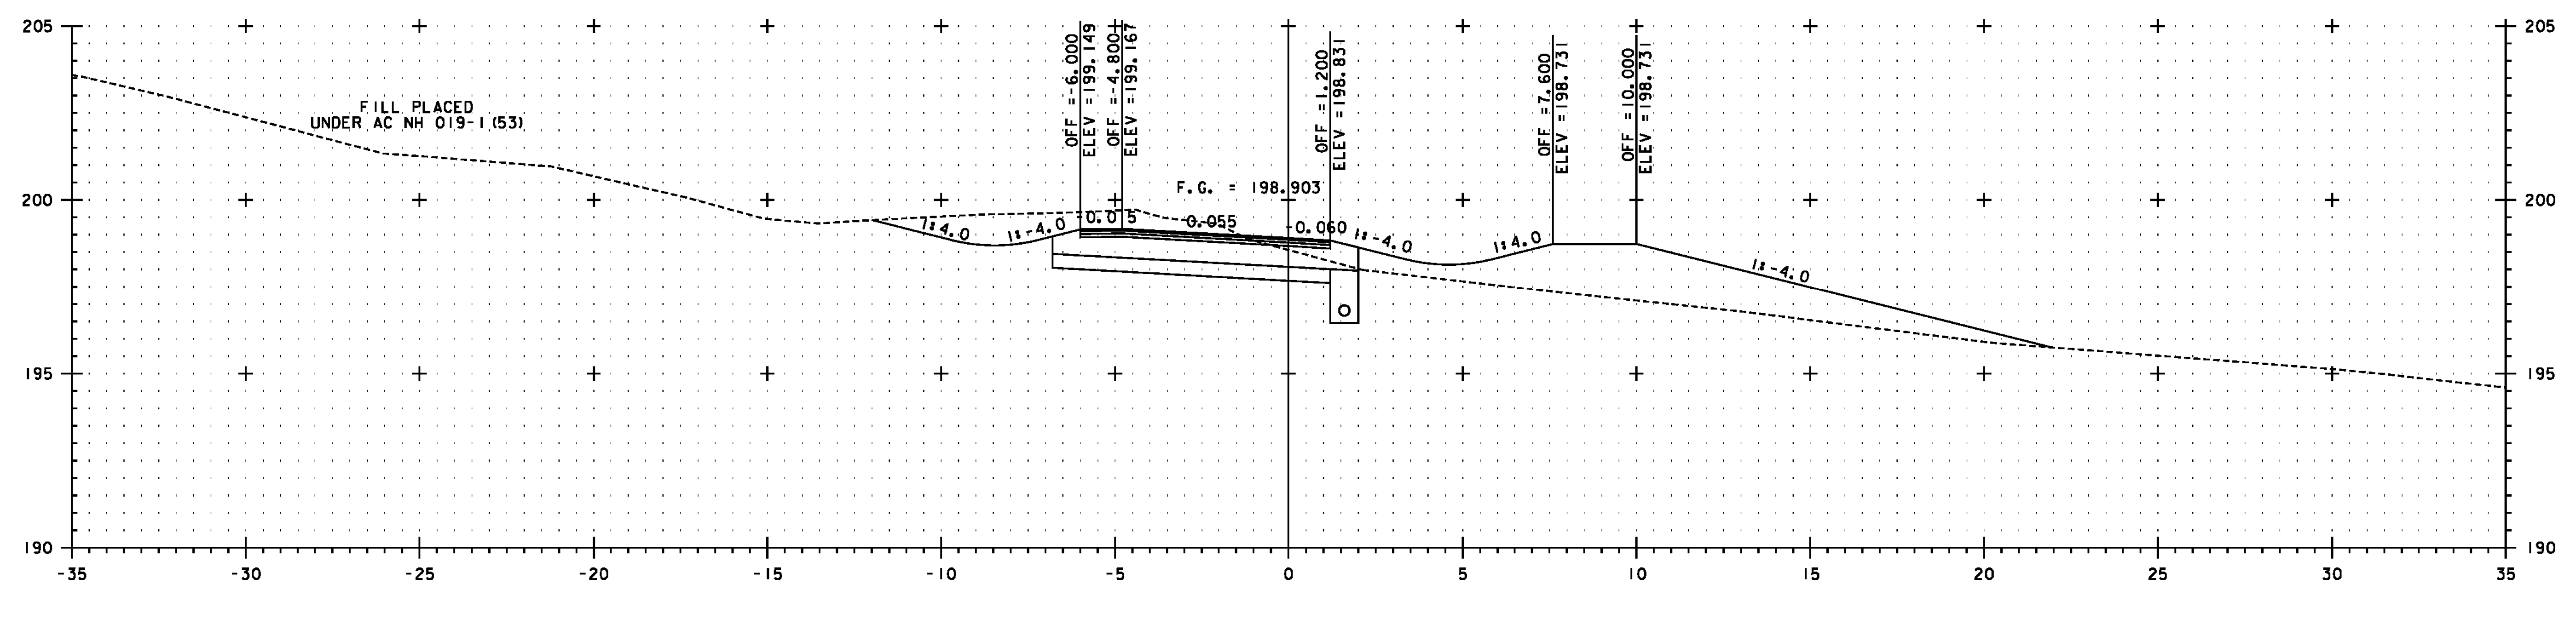

PROJECT NAME:	BENNINGTON
PROJECT NUMBER:	NH 019-(54)
FILE NAME:	...plot_files\zd307c4xs.rampF.ptf
DESIGN SUPERVISOR:	GREG EDWARDS
DESIGNED BY:	MARC FOISY
DRAWN BY:	STANTEC
CHECKED BY:	GARY SANTY
PLOT DATE:	1/26/2010
	SHEET 364 OF 468

1/26/2010 4:56:55 PM v:\1953\getlive\19530002\tr\anspor\station\dr\cm\ng\com\tr\def_4\plot_files\zd307c4xs.rampF.ptf