


F 1+740



F 1+720

SEE NOTE ON SHEET 355

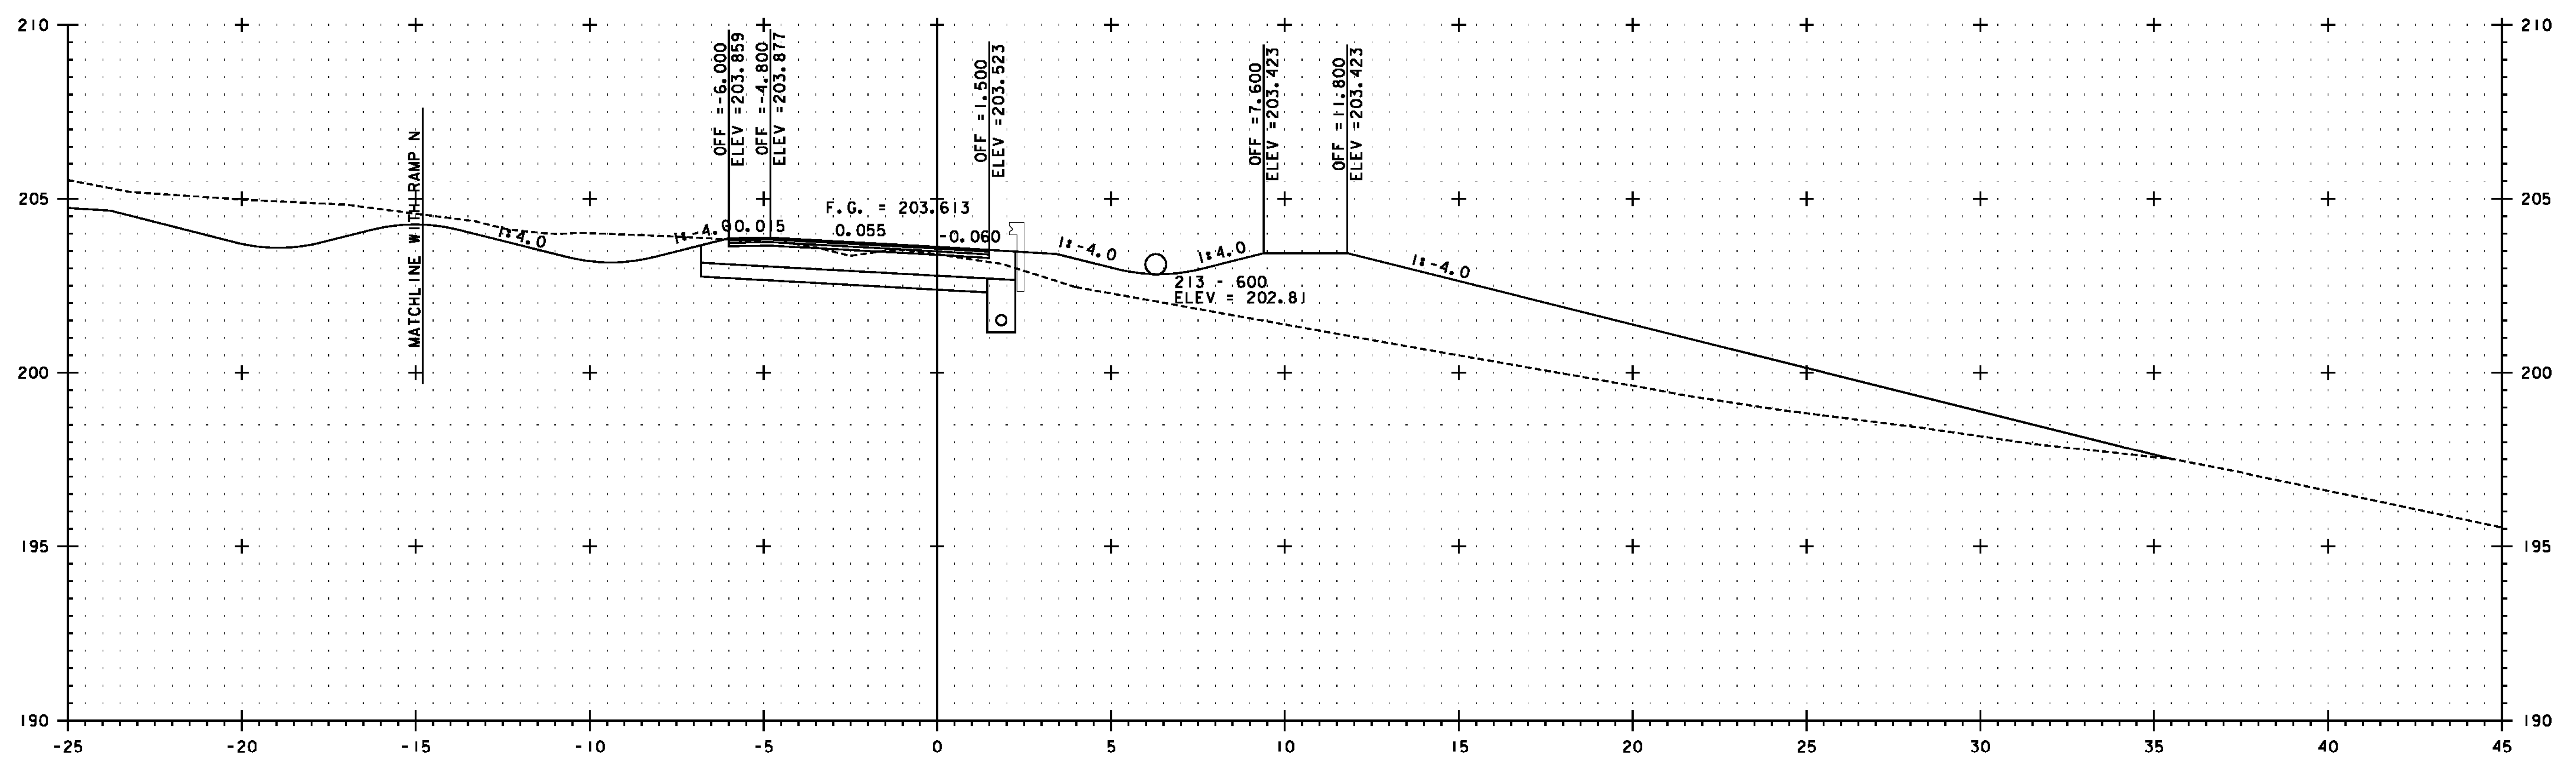

PROJECT NAME:	BENNINGTON
PROJECT NUMBER:	NH 019-(154)
FILE NAME:	...plot_files\zd307c4xs.rampF.ptf
PLOT DATE:	3/16/2010
DESIGN SUPERVISOR:	GREG EDWARDS
DRAWN BY:	STANTEC
DESIGNED BY:	MARC FOISY
CHECKED BY:	GARY SANTY
RAMP F CROSS SECTION	FXS-12
SHEET	366 OF 468

3/16/2010 2:55:13 PM v:\1953\getlive\19530002\transport\101\dr\cwg\ng\confr\c01_4\plot_files\zd307c4xs.rampF.ptf