


SEE NOTE ON SHEET 355

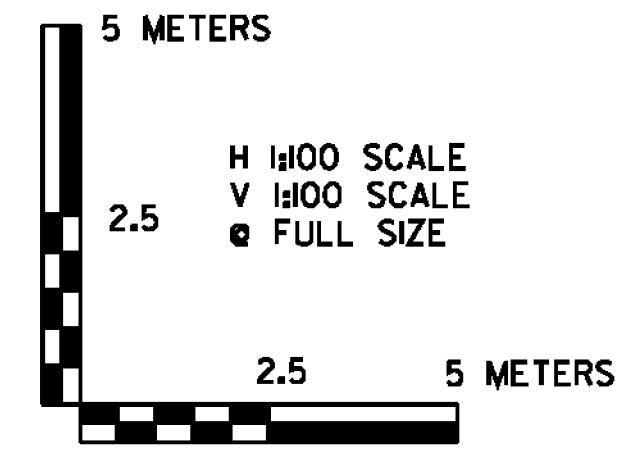

PROJECT NAME:	BENNINGTON
PROJECT NUMBER:	NH 019-(154)
FILE NAME:	...plot_files\zd307c4xs.rampF.ptf
DESIGN SUPERVISOR:	GREG EDWARDS
DESIGNED BY:	MARC FOISY
RAMP F CROSS SECTION	FXS-13
PLOT DATE:	3/16/2010
DRAWN BY:	STANTEC
CHECKED BY:	GARY SANTY
SHEET	367 OF 468

3/16/2010 11:46:29 AM v:\1953\getlive\19530002\trampF\plot_files\zd307c4xs.rampF.ptf