

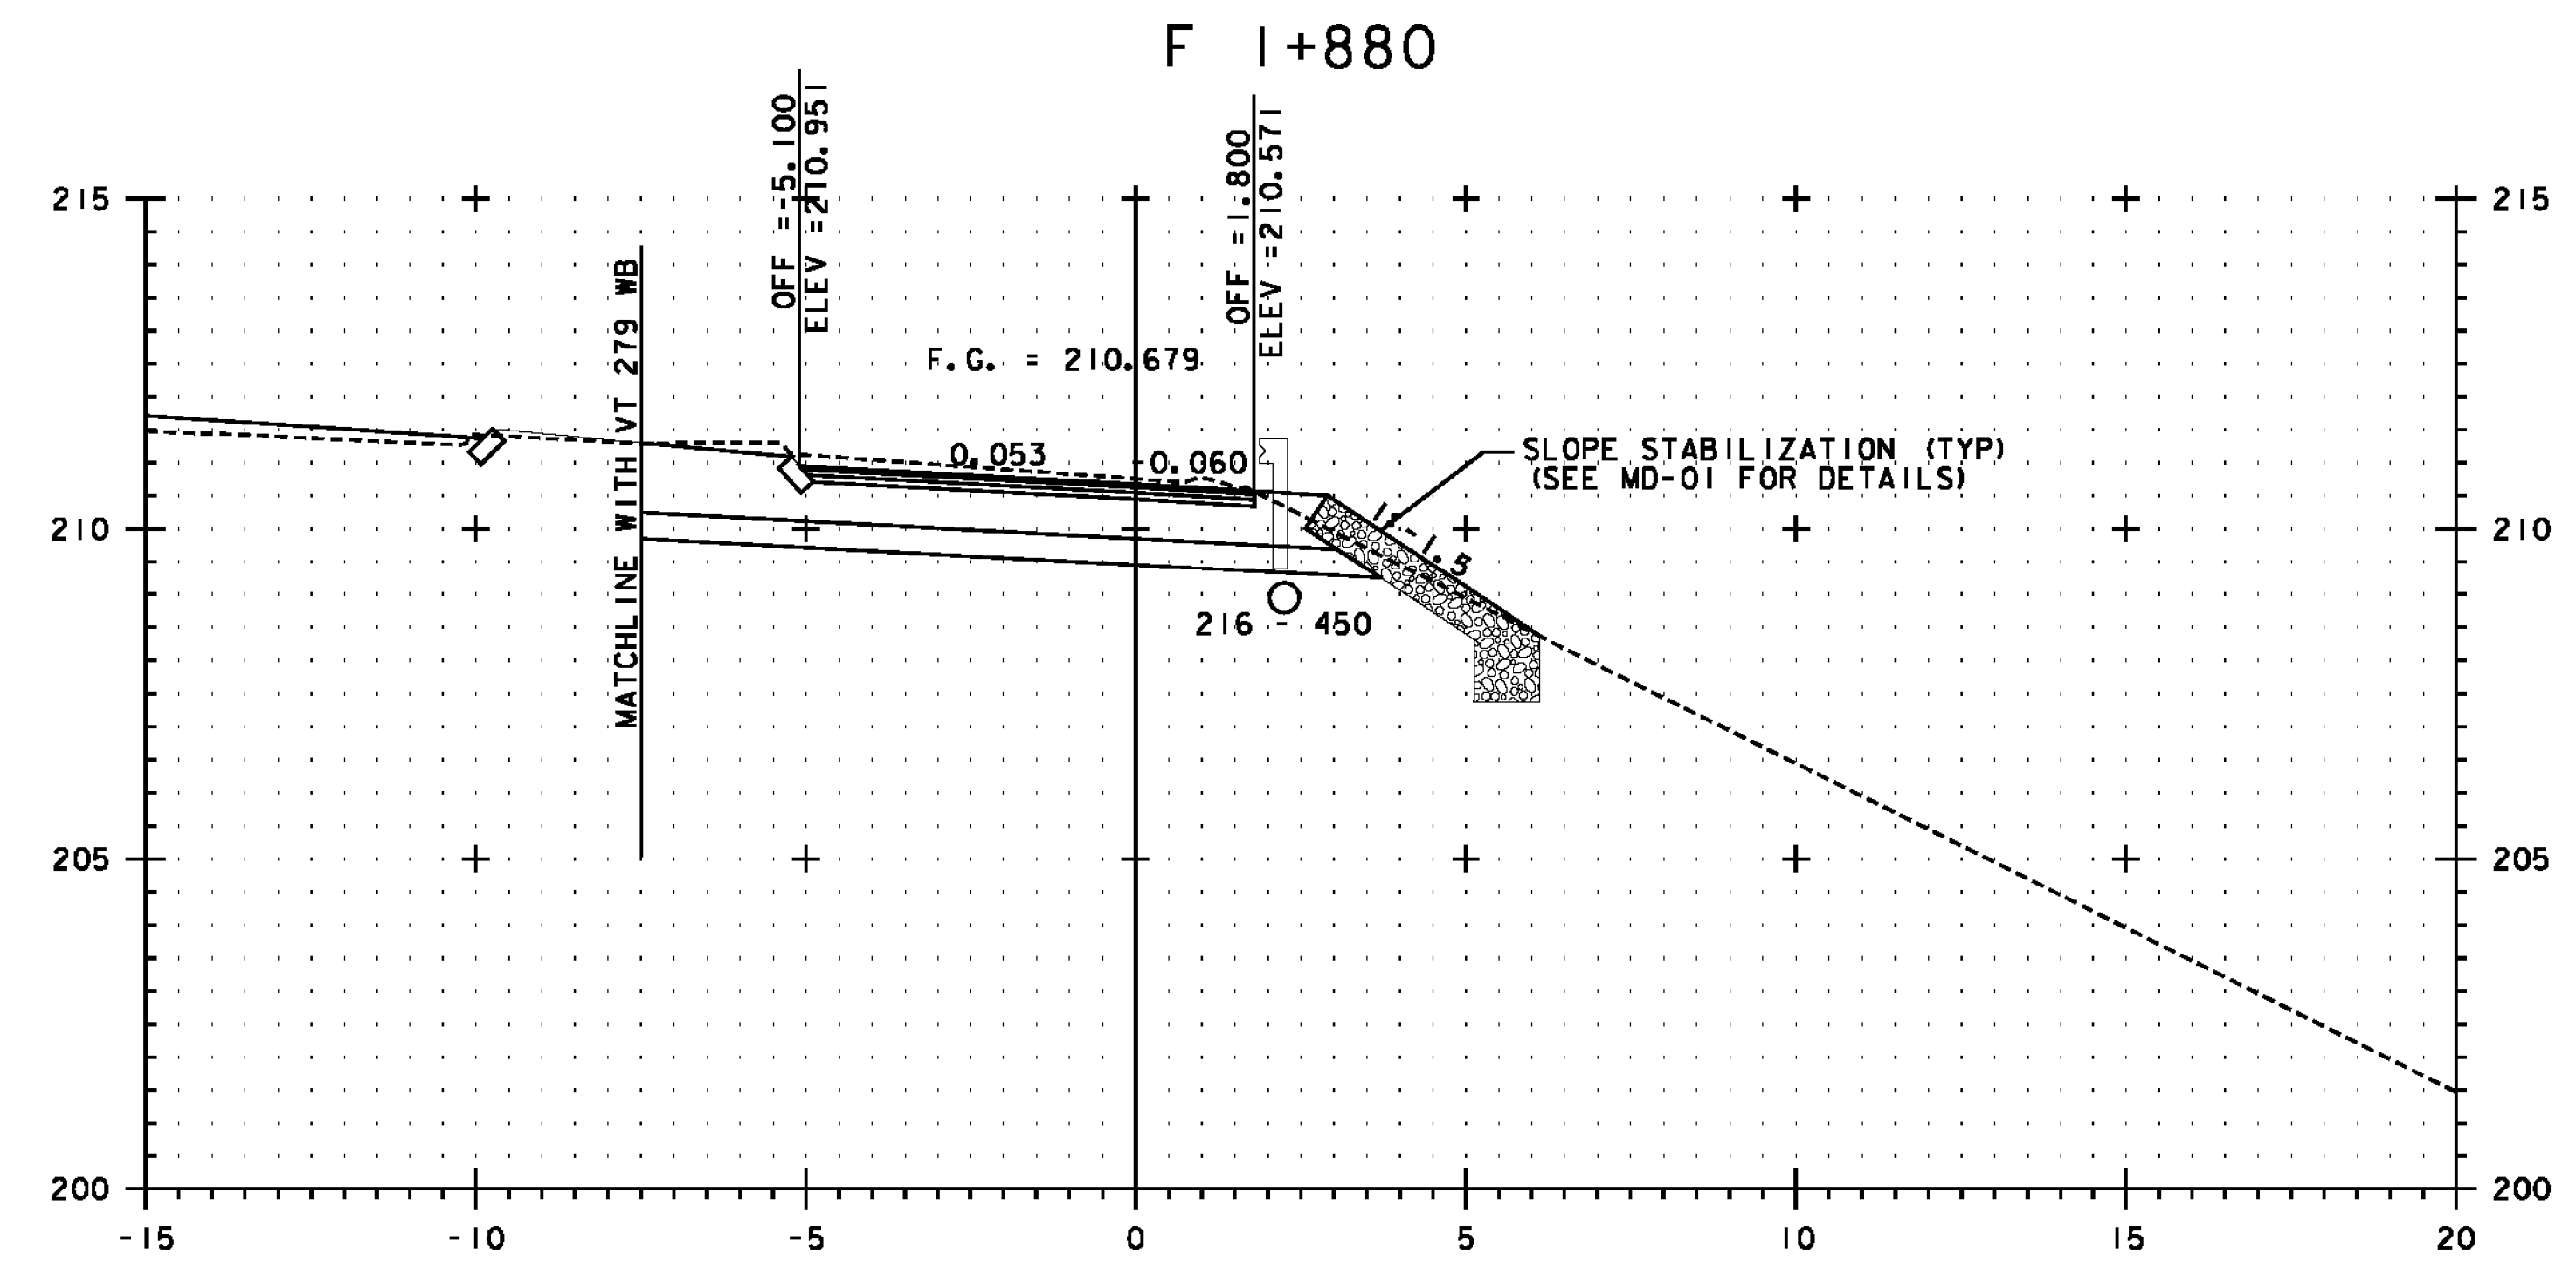
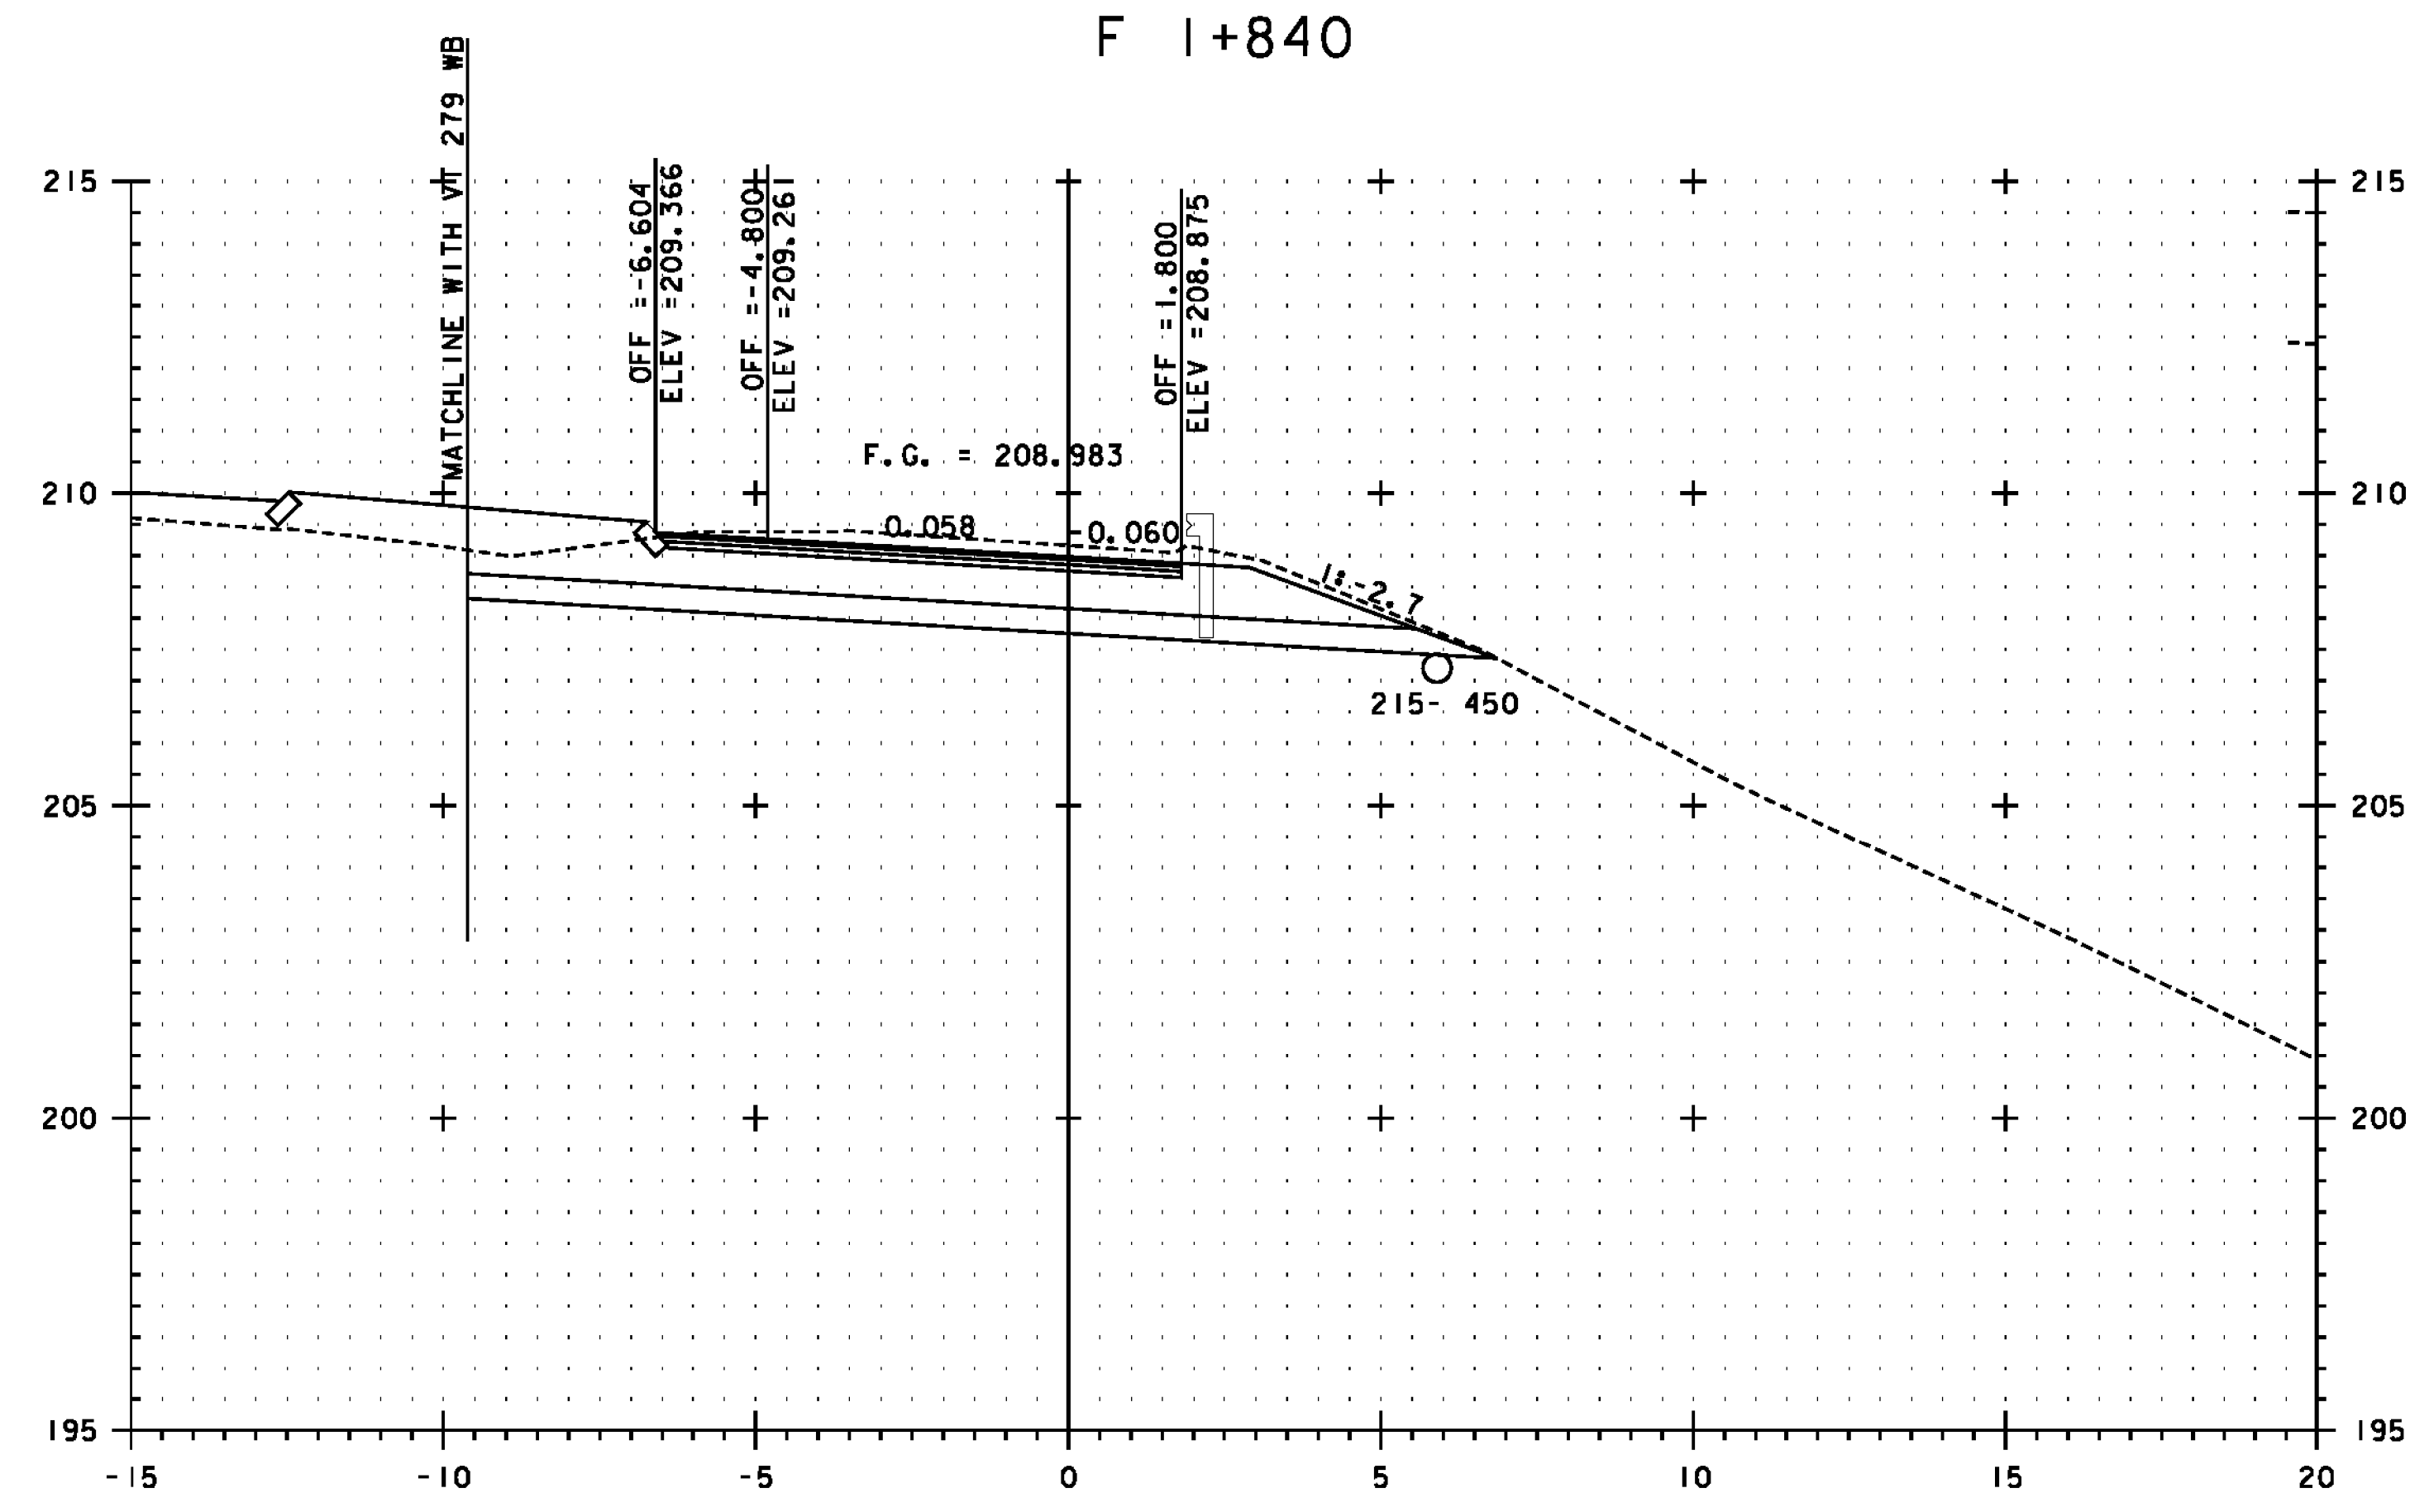
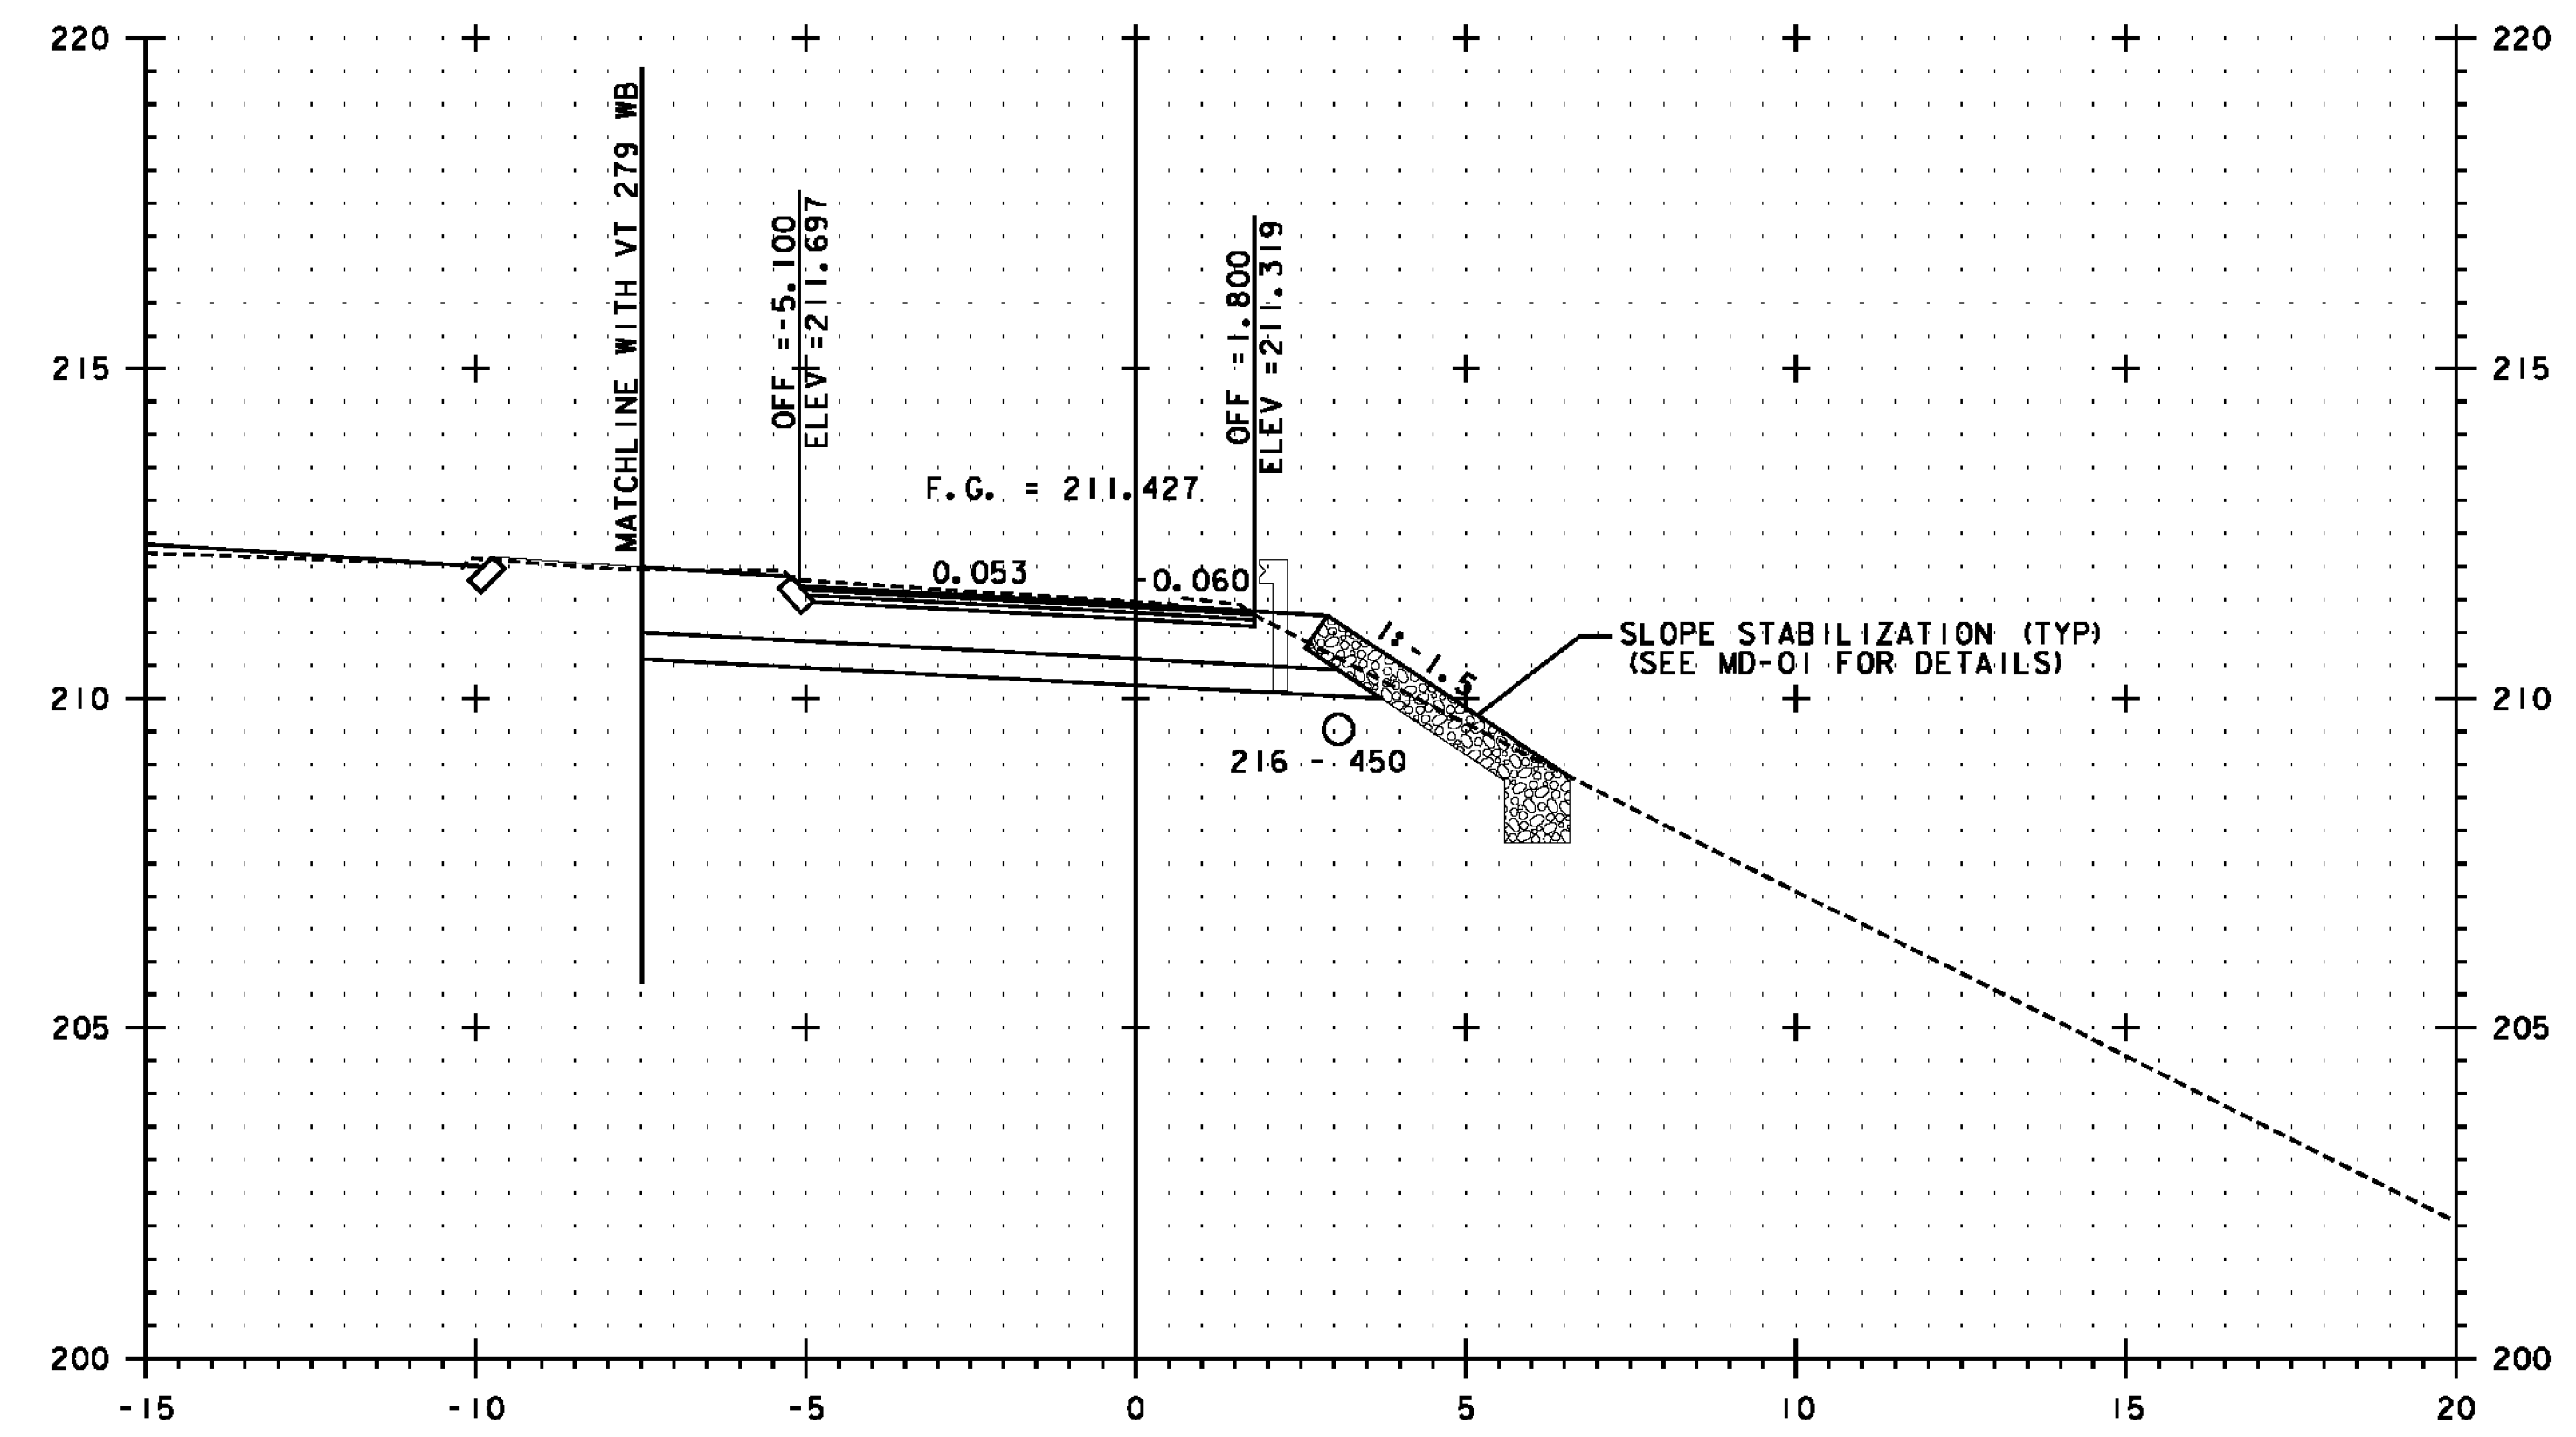


F 1+849.580 = N 1+162.337

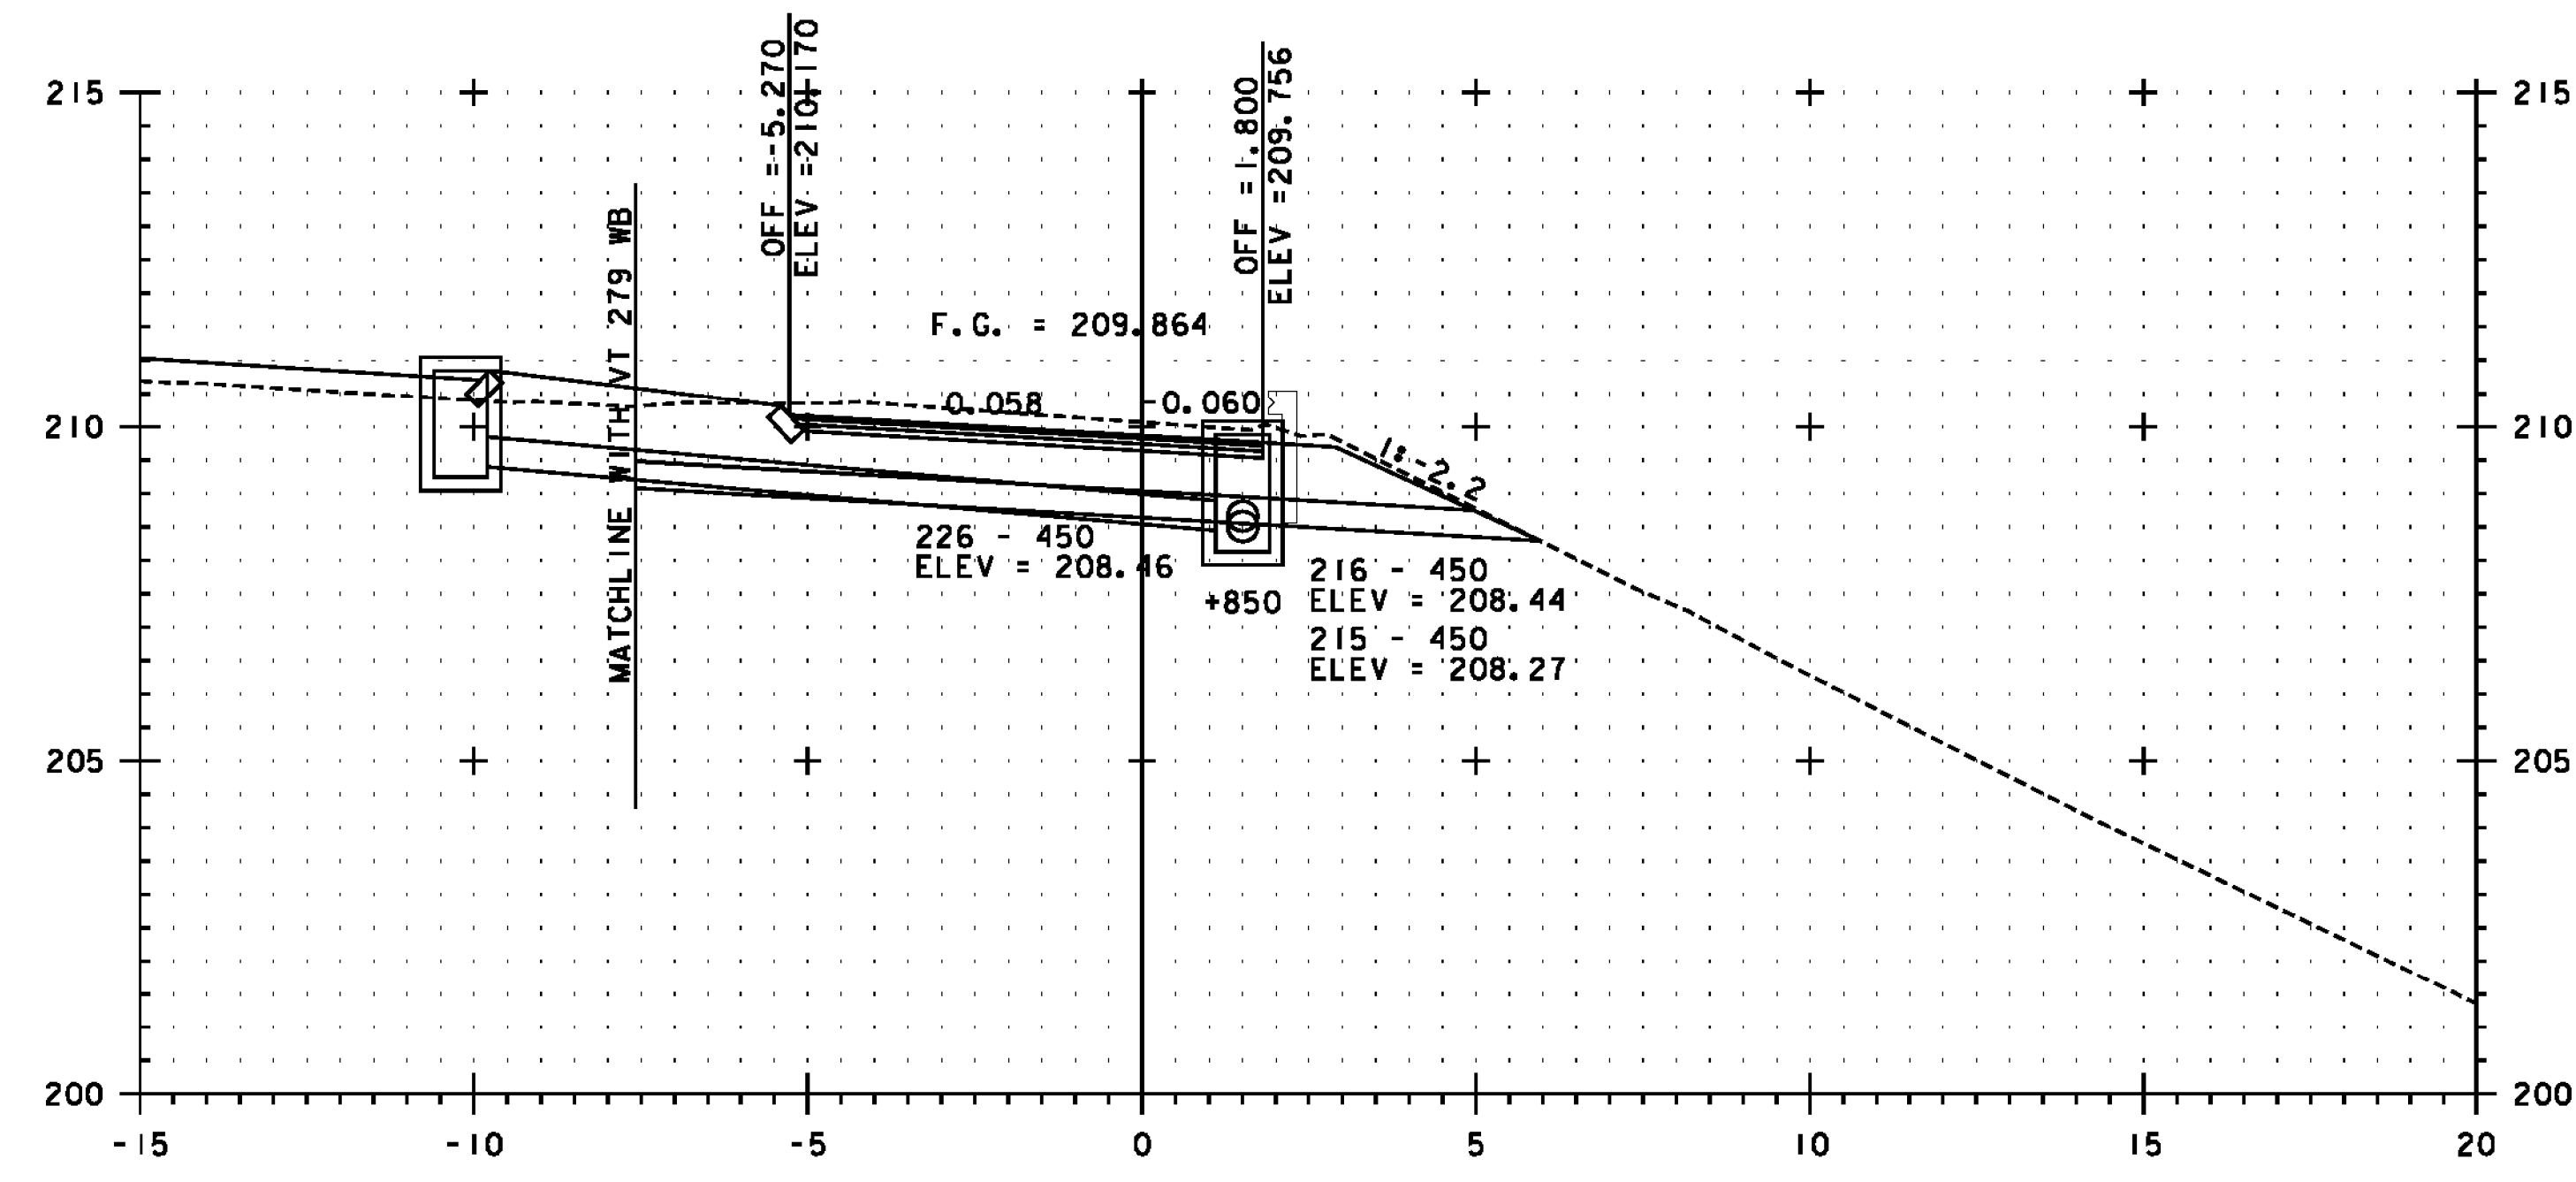

SEE NOTE ON SHEET 355

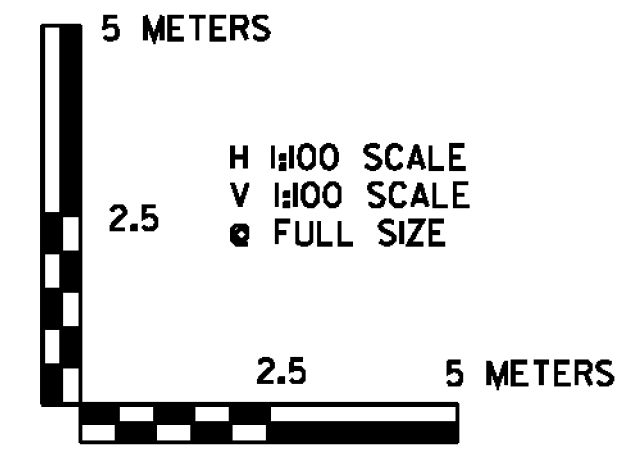

| | |
|---|------------------------------|
| | PROJECT NAME: BENNINGTON |
| | PROJECT NUMBER: NH 019-(154) |
| FILE NAME: ...\plot_files\zd307c4xs.rampF.pft | PLOT DATE: 3/16/2010 |
| DESIGN SUPERVISOR: GREG EDWARDS | DRAWN BY: STANTEC |
| DESIGNED BY: MARC FOISY | CHECKED BY: GARY SANTY |
| RAMP F CROSS SECTION FXS-14 SHEET 368 OF 468 | |

3/16/2010 11:44:48 AM v:\1953\getlive\1953\0002\transportation\drw\mg\confr\cp1_4\plot_files\zd307c4xs.rampF.pft