


F 1+899.294, 10.2m LT. = WB 10+139.217, 13.8m LT.

SEE NOTE ON SHEET 355

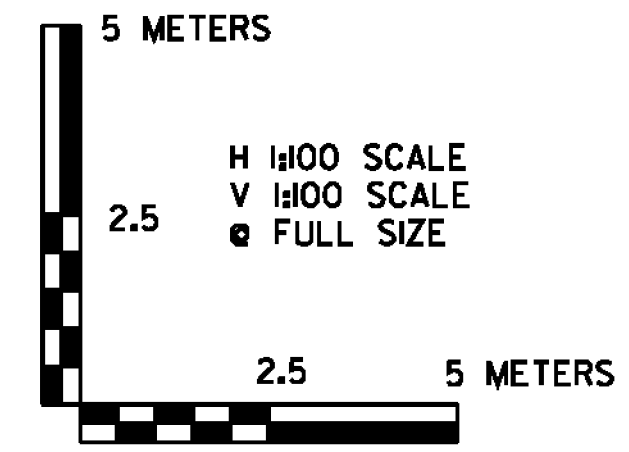

PROJECT NAME:	BENNINGTON
PROJECT NUMBER:	NH 019-(154)
FILE NAME:	...plot_files\zd307c4xs_rampF.ptf
DESIGN SUPERVISOR:	GREG EDWARDS
DESIGNED BY:	MARC FOISY
DRAWN BY:	STANTEC
CHECKED BY:	GARY SANTY
RAMP F CROSS SECTION	FXS-15
PLOT DATE:	1/26/2010
	SHEET 369 OF 468

1/26/2010 4:57:00 PM v:\1953\getlive\1953\0002\tr\mspor\getlive\dr\dwg\con\tr\cpt\_4\plot\_files\zd307c4xs\_rampF.ptf