



G I+760

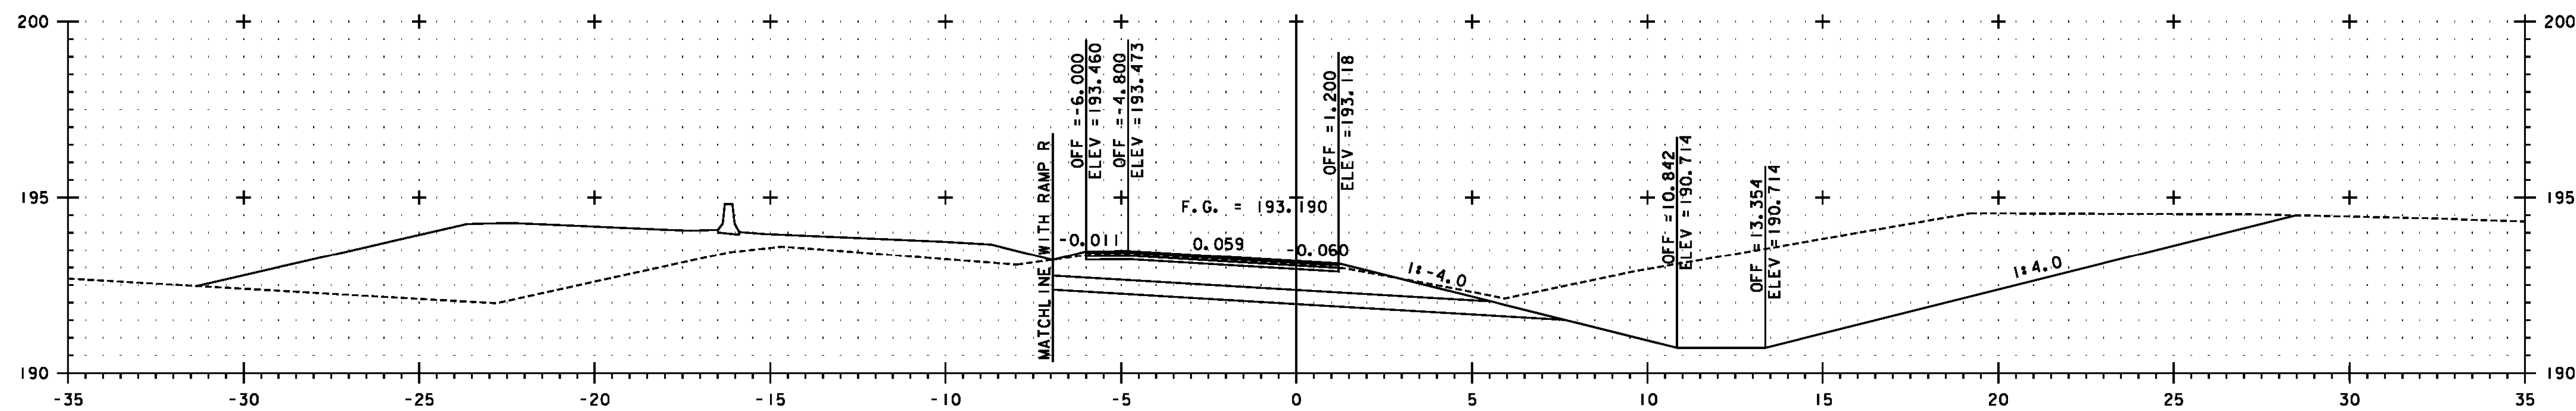


G I+740

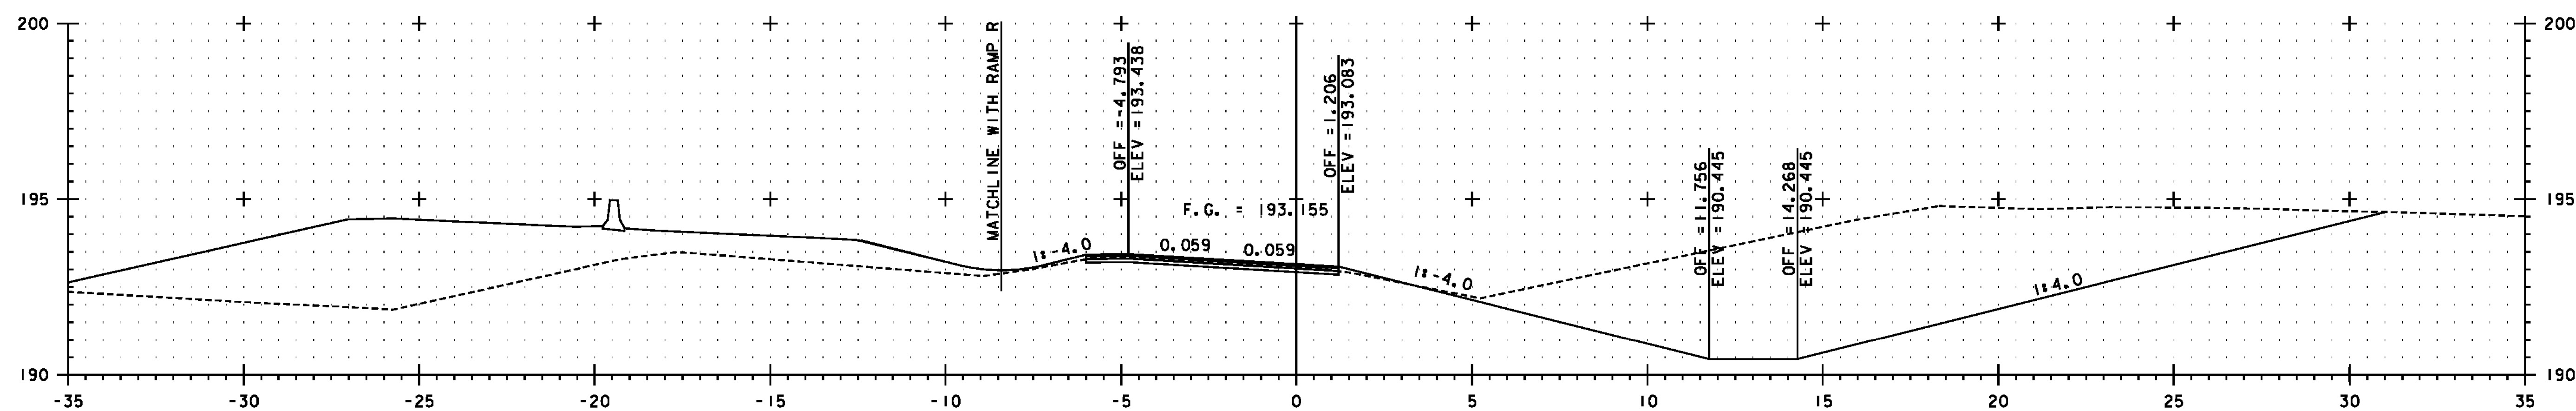

G I+733

NOTE: FINAL CROSS SECTIONS FOR RAMP G ARE CONTAINED IN THE FINAL COMP BOOKS FOR ITEM 203.15 - COMMON EXCAVATION

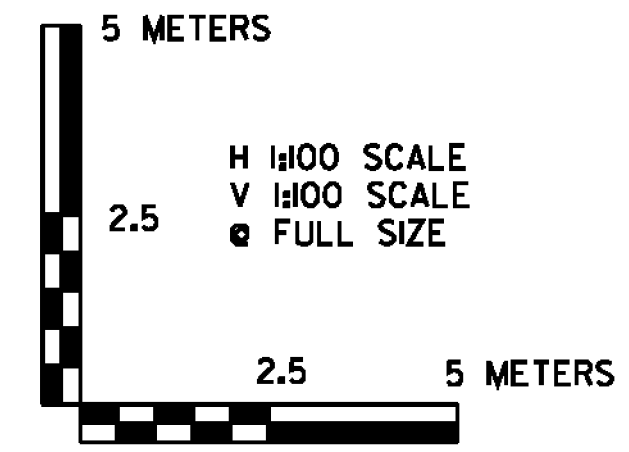

PROJECT NAME:	BENNINGTON
PROJECT NUMBER:	NH 019-(154)
FILE NAME:	...plot_files\zd307c4xs.rampG.ptf
PLOT DATE:	1/26/2010
DESIGN SUPERVISOR:	GREG EDWARDS
DESIGNED BY:	MARC FOISY
DRAWN BY:	STANTEC
CHECKED BY:	GARY SANTY
RAMP G CROSS SECTION	GXS-01
SHEET	370 OF 468

1/26/2010 4:57:03 PM v:\1953\getlive\1953\002A\tr\anspor\ref\ton\dr\cwg\ng\com\tr\cst_4\plot_files\zd307c4xs_rampG.ptf