


SEE NOTE ON SHEET 370

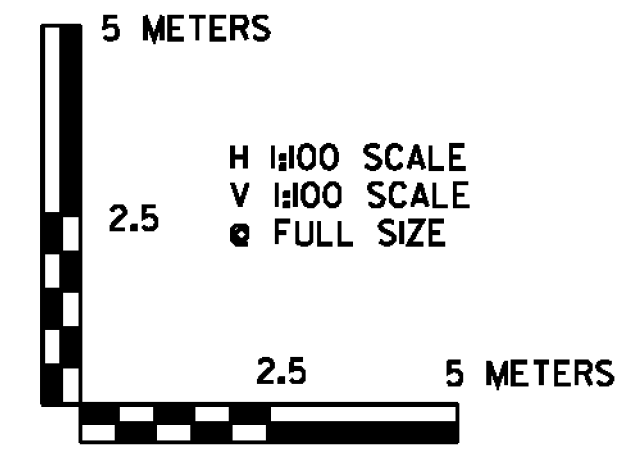

PROJECT NAME:	BENNINGTON
PROJECT NUMBER:	NH 019-(154)
FILE NAME:	...plot_files\zd307c4xs.rampG.ptf
PLOT DATE:	3/16/2010
DESIGN SUPERVISOR:	GREG EDWARDS
DRAWN BY:	STANTEC
DESIGNED BY:	MARC FOISY
CHECKED BY:	GARY SANTY
RAMP G CROSS SECTION GXS-03	SHEET 372 OF 468

3/16/2010 5:08:09 PM V:\1953\getlive\19530002\tramsport\station\drawng\comfr\cst\_4\plot\_files\zd307c4xs.rampG.ptf