



G 2+020

G 2+010.484 = S 1+204.061, 11.6m LT.

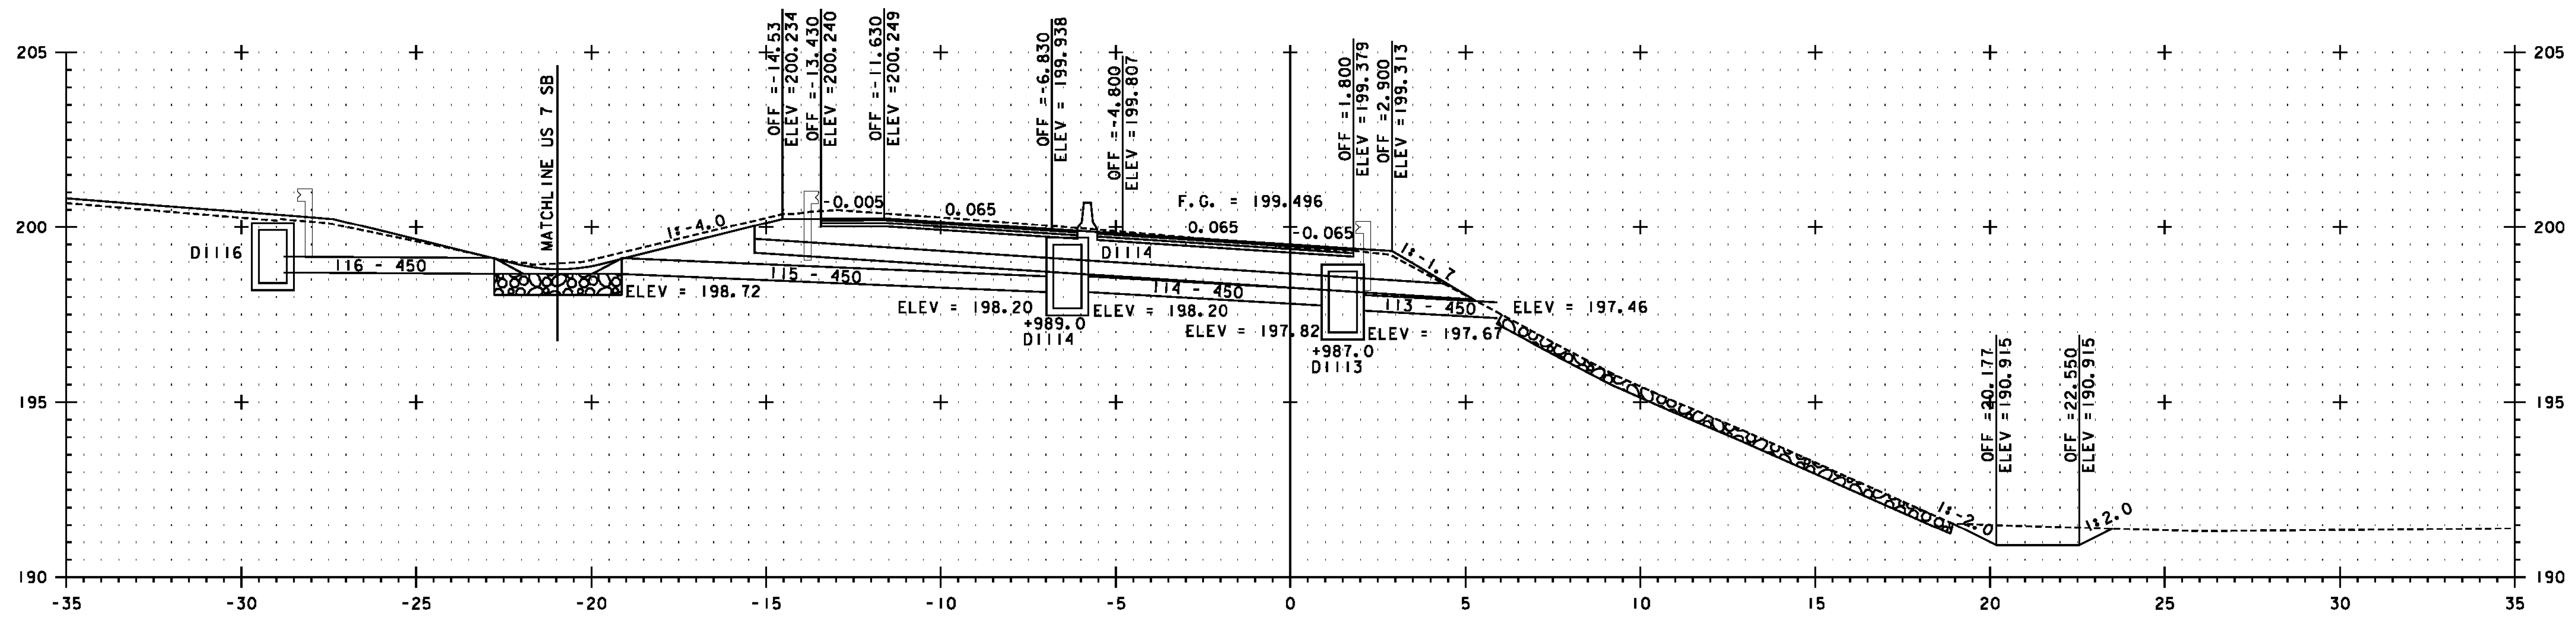

G 2+000

SEE NOTE ON SHEET 370

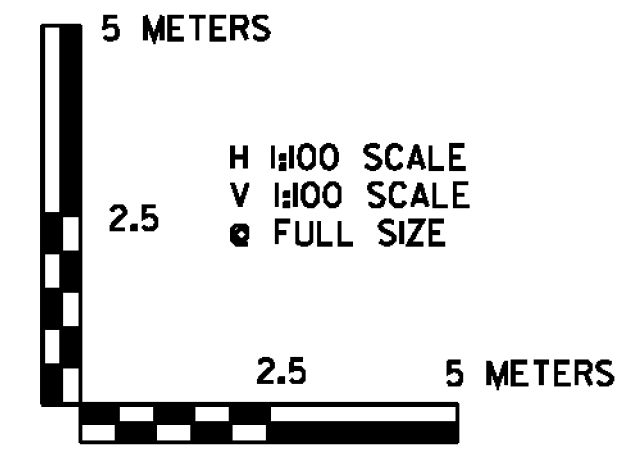

	PROJECT NAME: BENNINGTON
	PROJECT NUMBER: NH 019-1(54)
FILE NAME: ...\plot_files\zd307c4xs.rampG.ptf	PLOT DATE: 1/26/2010
DESIGN SUPERVISOR: GREG EDWARDS	DRAWN BY: STANTEC
DESIGNED BY: MARC FOISY	CHECKED BY: GARY SANTY
RAMP G CROSS SECTION GXS-07	
SHEET 376 OF 468	

1/26/2010 4:57:09 PM V:\1953\getlive\19530002\tr\anspor\station\dr\w\ng\com\tr\cpt_4\plot_files\zd307c4xs.rampG.ptf