



G 2+060

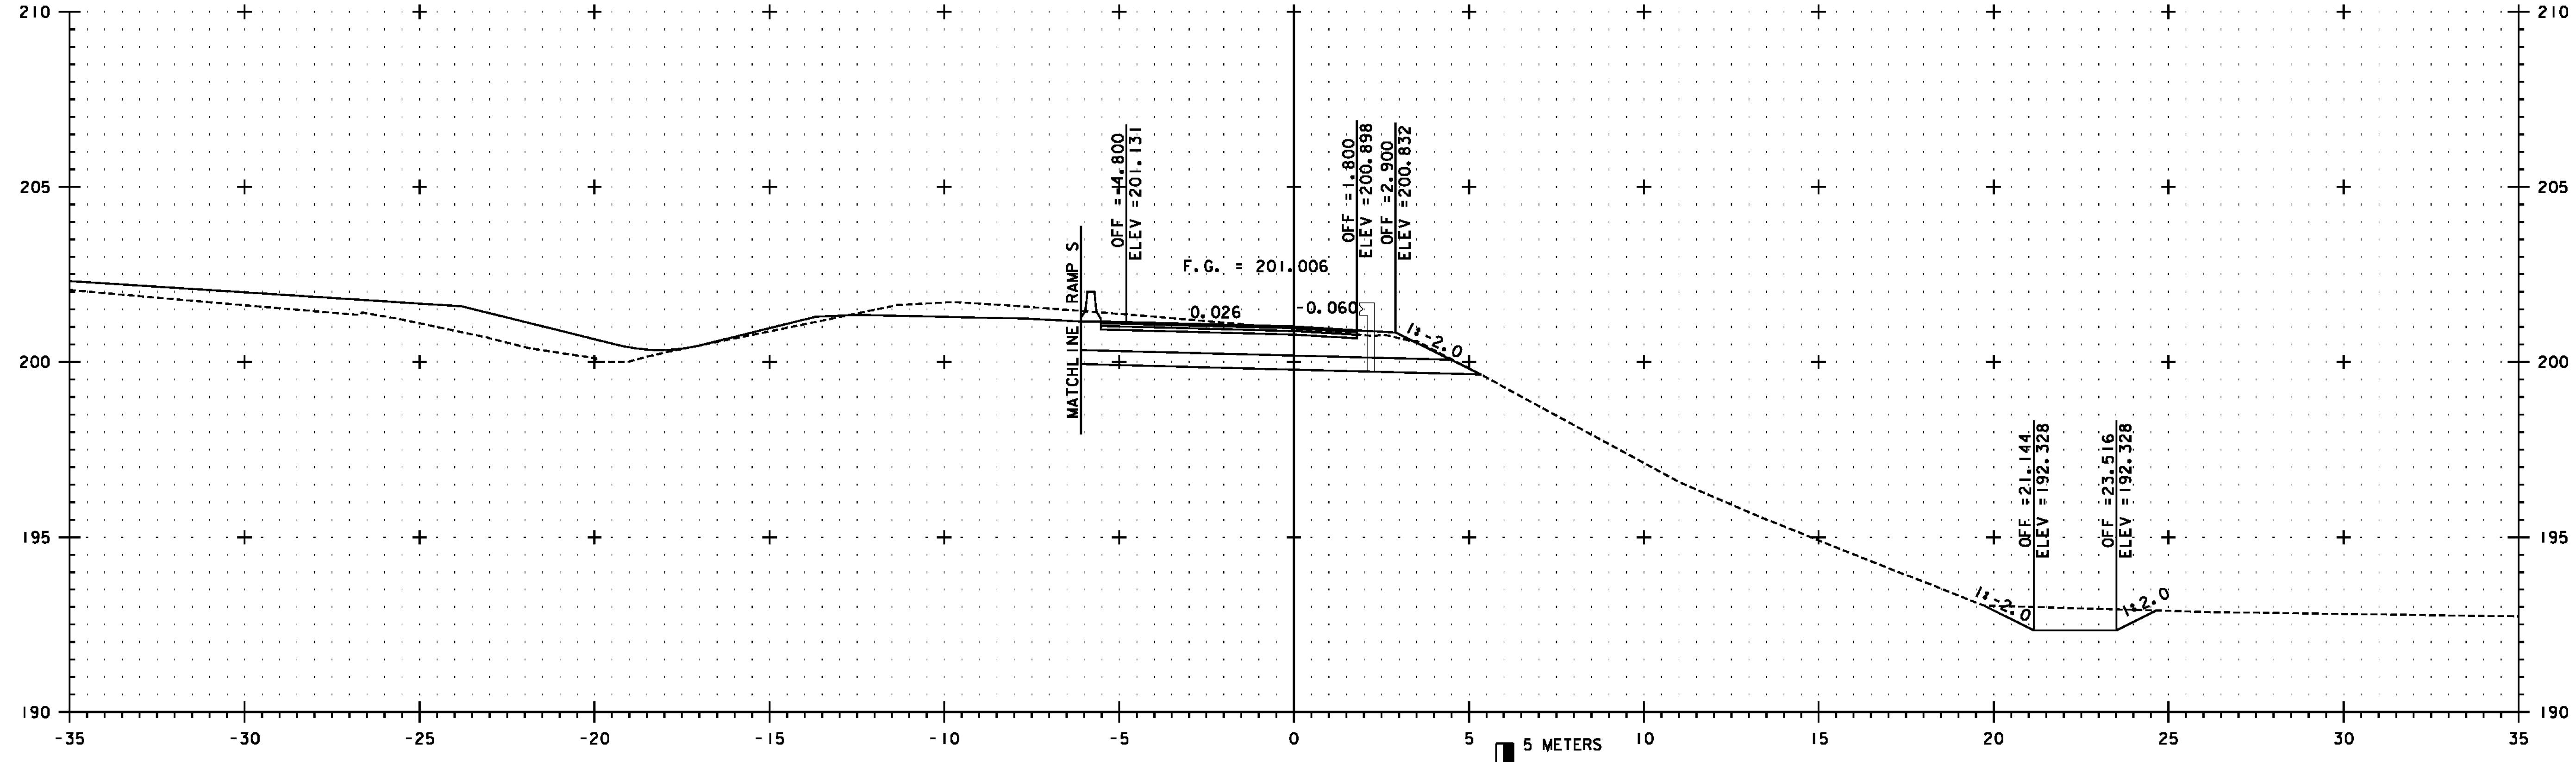

G 2+040

SEE NOTE ON SHEET 370

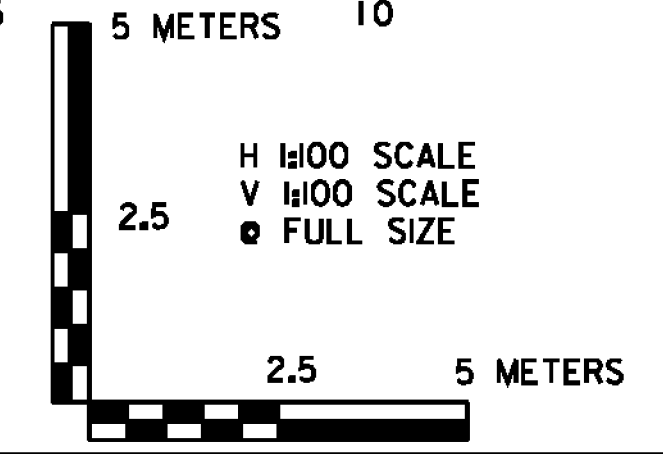

PROJECT NAME:	BENNINGTON
PROJECT NUMBER:	NH 019-(154)
FILE NAME:	...plot_files\zd307c4xs.rampG.ptf
DESIGN SUPERVISOR:	GREG EDWARDS
DESIGNED BY:	MARC FOISY
RAMP G CROSS SECTION	GXS-08
PLOT DATE:	1/26/2010
DRAWN BY:	STANTEC
CHECKED BY:	GARY SANTY
SHEET	377 OF 468

I:\2672010_4657211.PW v:\1953\getlive\1953\0002\transportation\drw\mg\confr\cst_4\plot_files\zd307c4xs.rampG.ptf