


G 2+100



G 2+080

SEE NOTE ON SHEET 370

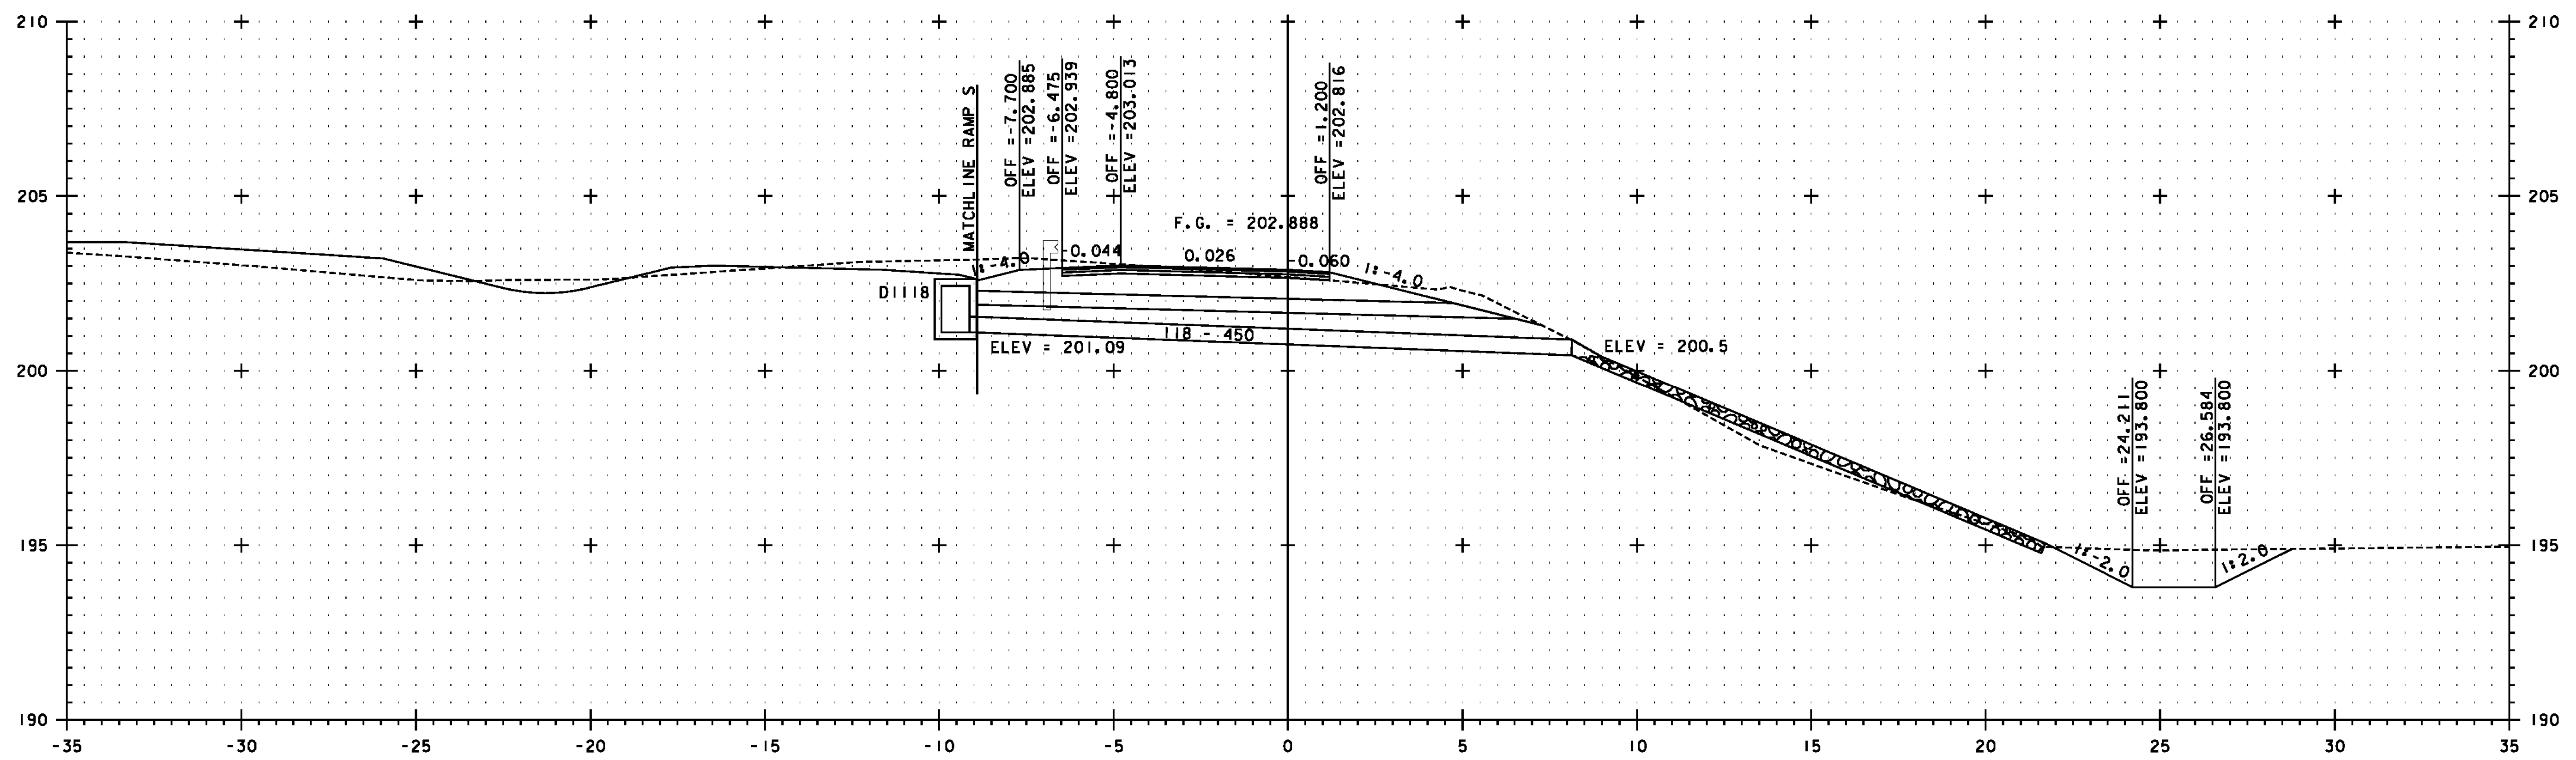

PROJECT NAME:	BENNINGTON
PROJECT NUMBER:	NH 019-(154)
FILE NAME:	...plot_files\zd307c4xs.rampG.ptf
PLOT DATE:	1/26/2010
DESIGN SUPERVISOR:	GREG EDWARDS
DRAWN BY:	STANTEC
DESIGNED BY:	MARC FOISY
CHECKED BY:	GARY SANTY
RAMP G CROSS SECTION	GXS-09
SHEET	378 OF 468

1/26/2010 4:57:12 PM v:\1953\active\19530002\transportation\drw\ng\comp\tr\cpt_4\plot_files\zd307c4xs.rampG.ptf