



G 2+140

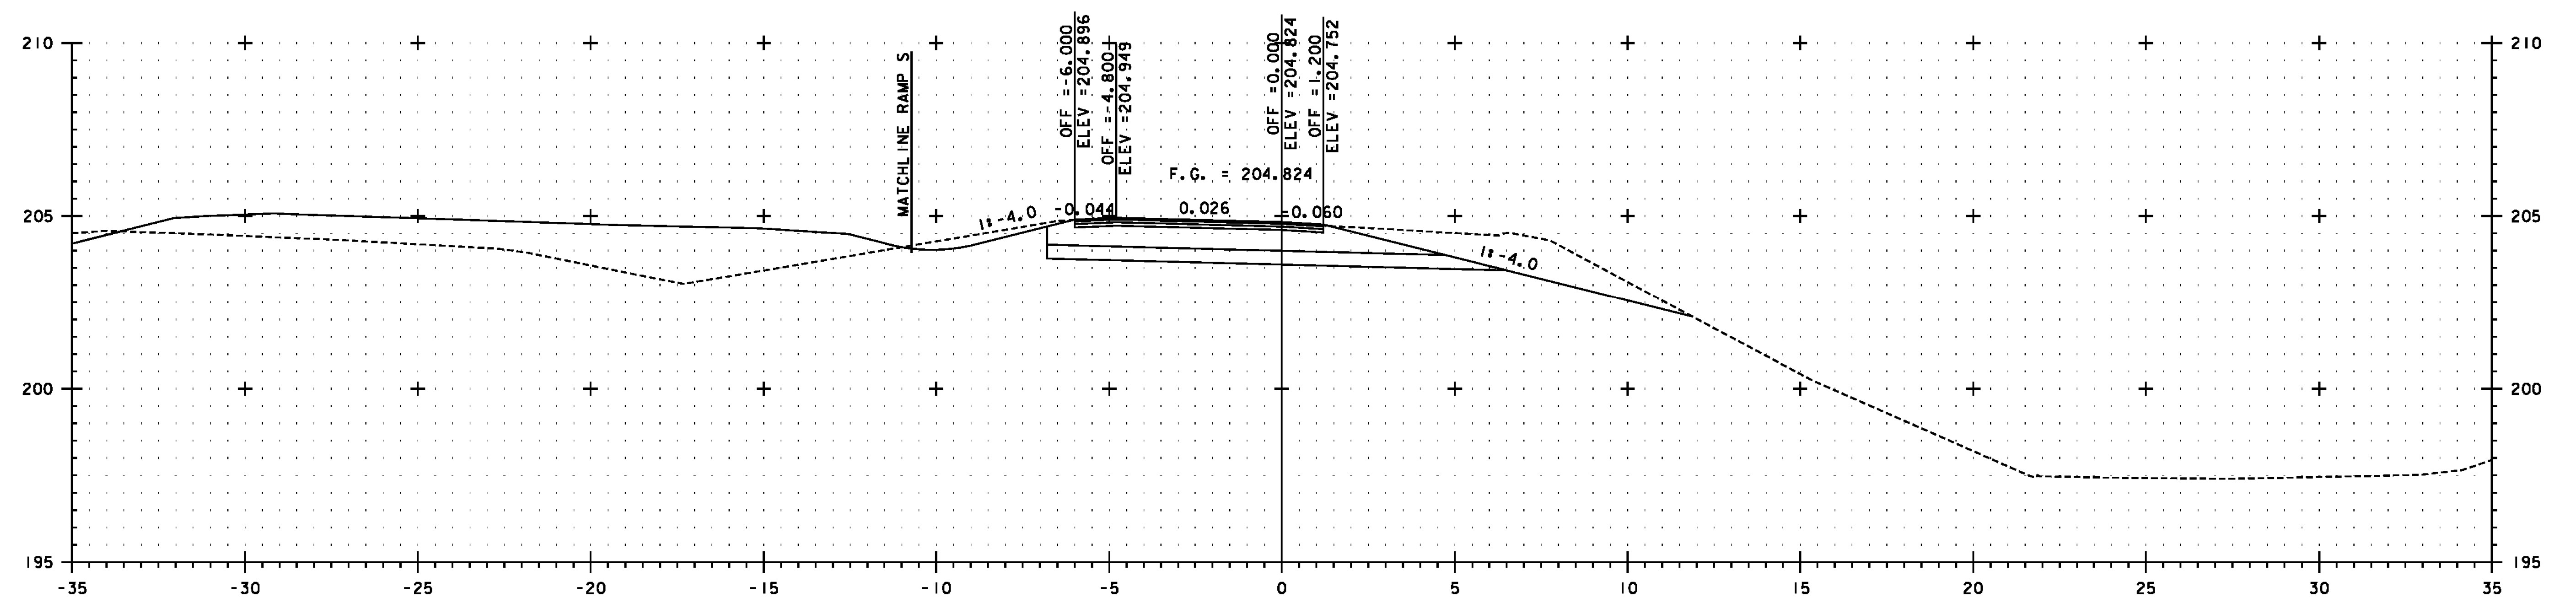

G 2+120

SEE NOTE ON SHEET 370

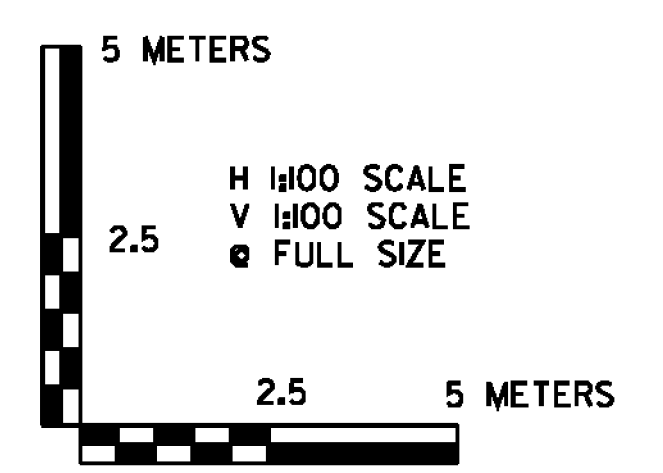

SEE REVISED SHEET

PROJECT NAME:	BENNINGTON
PROJECT NUMBER:	NH 019-(154)
FILE NAME:	...plot_files\zd307c4xs.rampG.ptf
PLOT DATE:	3/16/2010
DESIGN SUPERVISOR:	GREG EDWARDS
DRAWN BY:	STANTEC
DESIGNED BY:	MARC FOISY
CHECKED BY:	GARY SANTY
RAMP G CROSS SECTION	GXS-10
SHEET	379 OF 468

3/16/2010 11:55:31 AM V:\1953\getlive\1953\0002\transportation\dr\cwg\ng\confr\cst_4\plot_files\zd307c4xs.rampG.ptf