


SEE NOTE ON SHEET 370

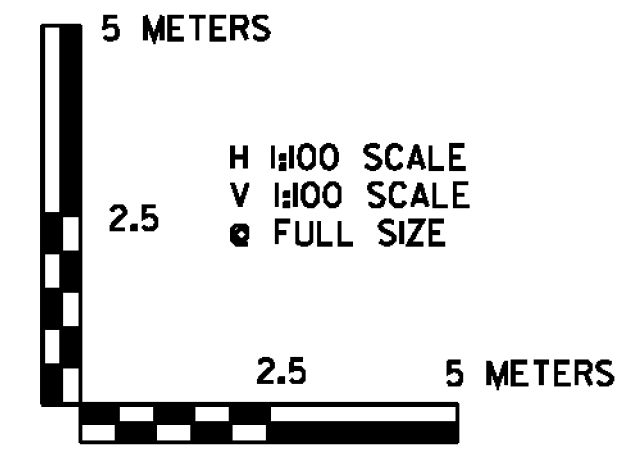

	SEE REVISED SHEET	
	PROJECT NAME: BENNINGTON	PROJECT NUMBER: NH 019-(154)
FILE NAME: ...\plot_files\zd307c4xs.rampG.ptf	PLOT DATE: 1/26/2010	DESIGN SUPERVISOR: GREG EDWARDS
DESIGNED BY: MARC FOISY	CHECKED BY: GARY SANTY	DRAWN BY: STANTEC
RAMP G CROSS SECTION GXS-11		SHEET 380 OF 468

1/26/2010 4:57:14 PM v:\1953\getlive\19530002\tr\anspor\101101\dr\cm\ng\com\tr\001_4\plot_files\zd307c4xs.rampG.ptf